
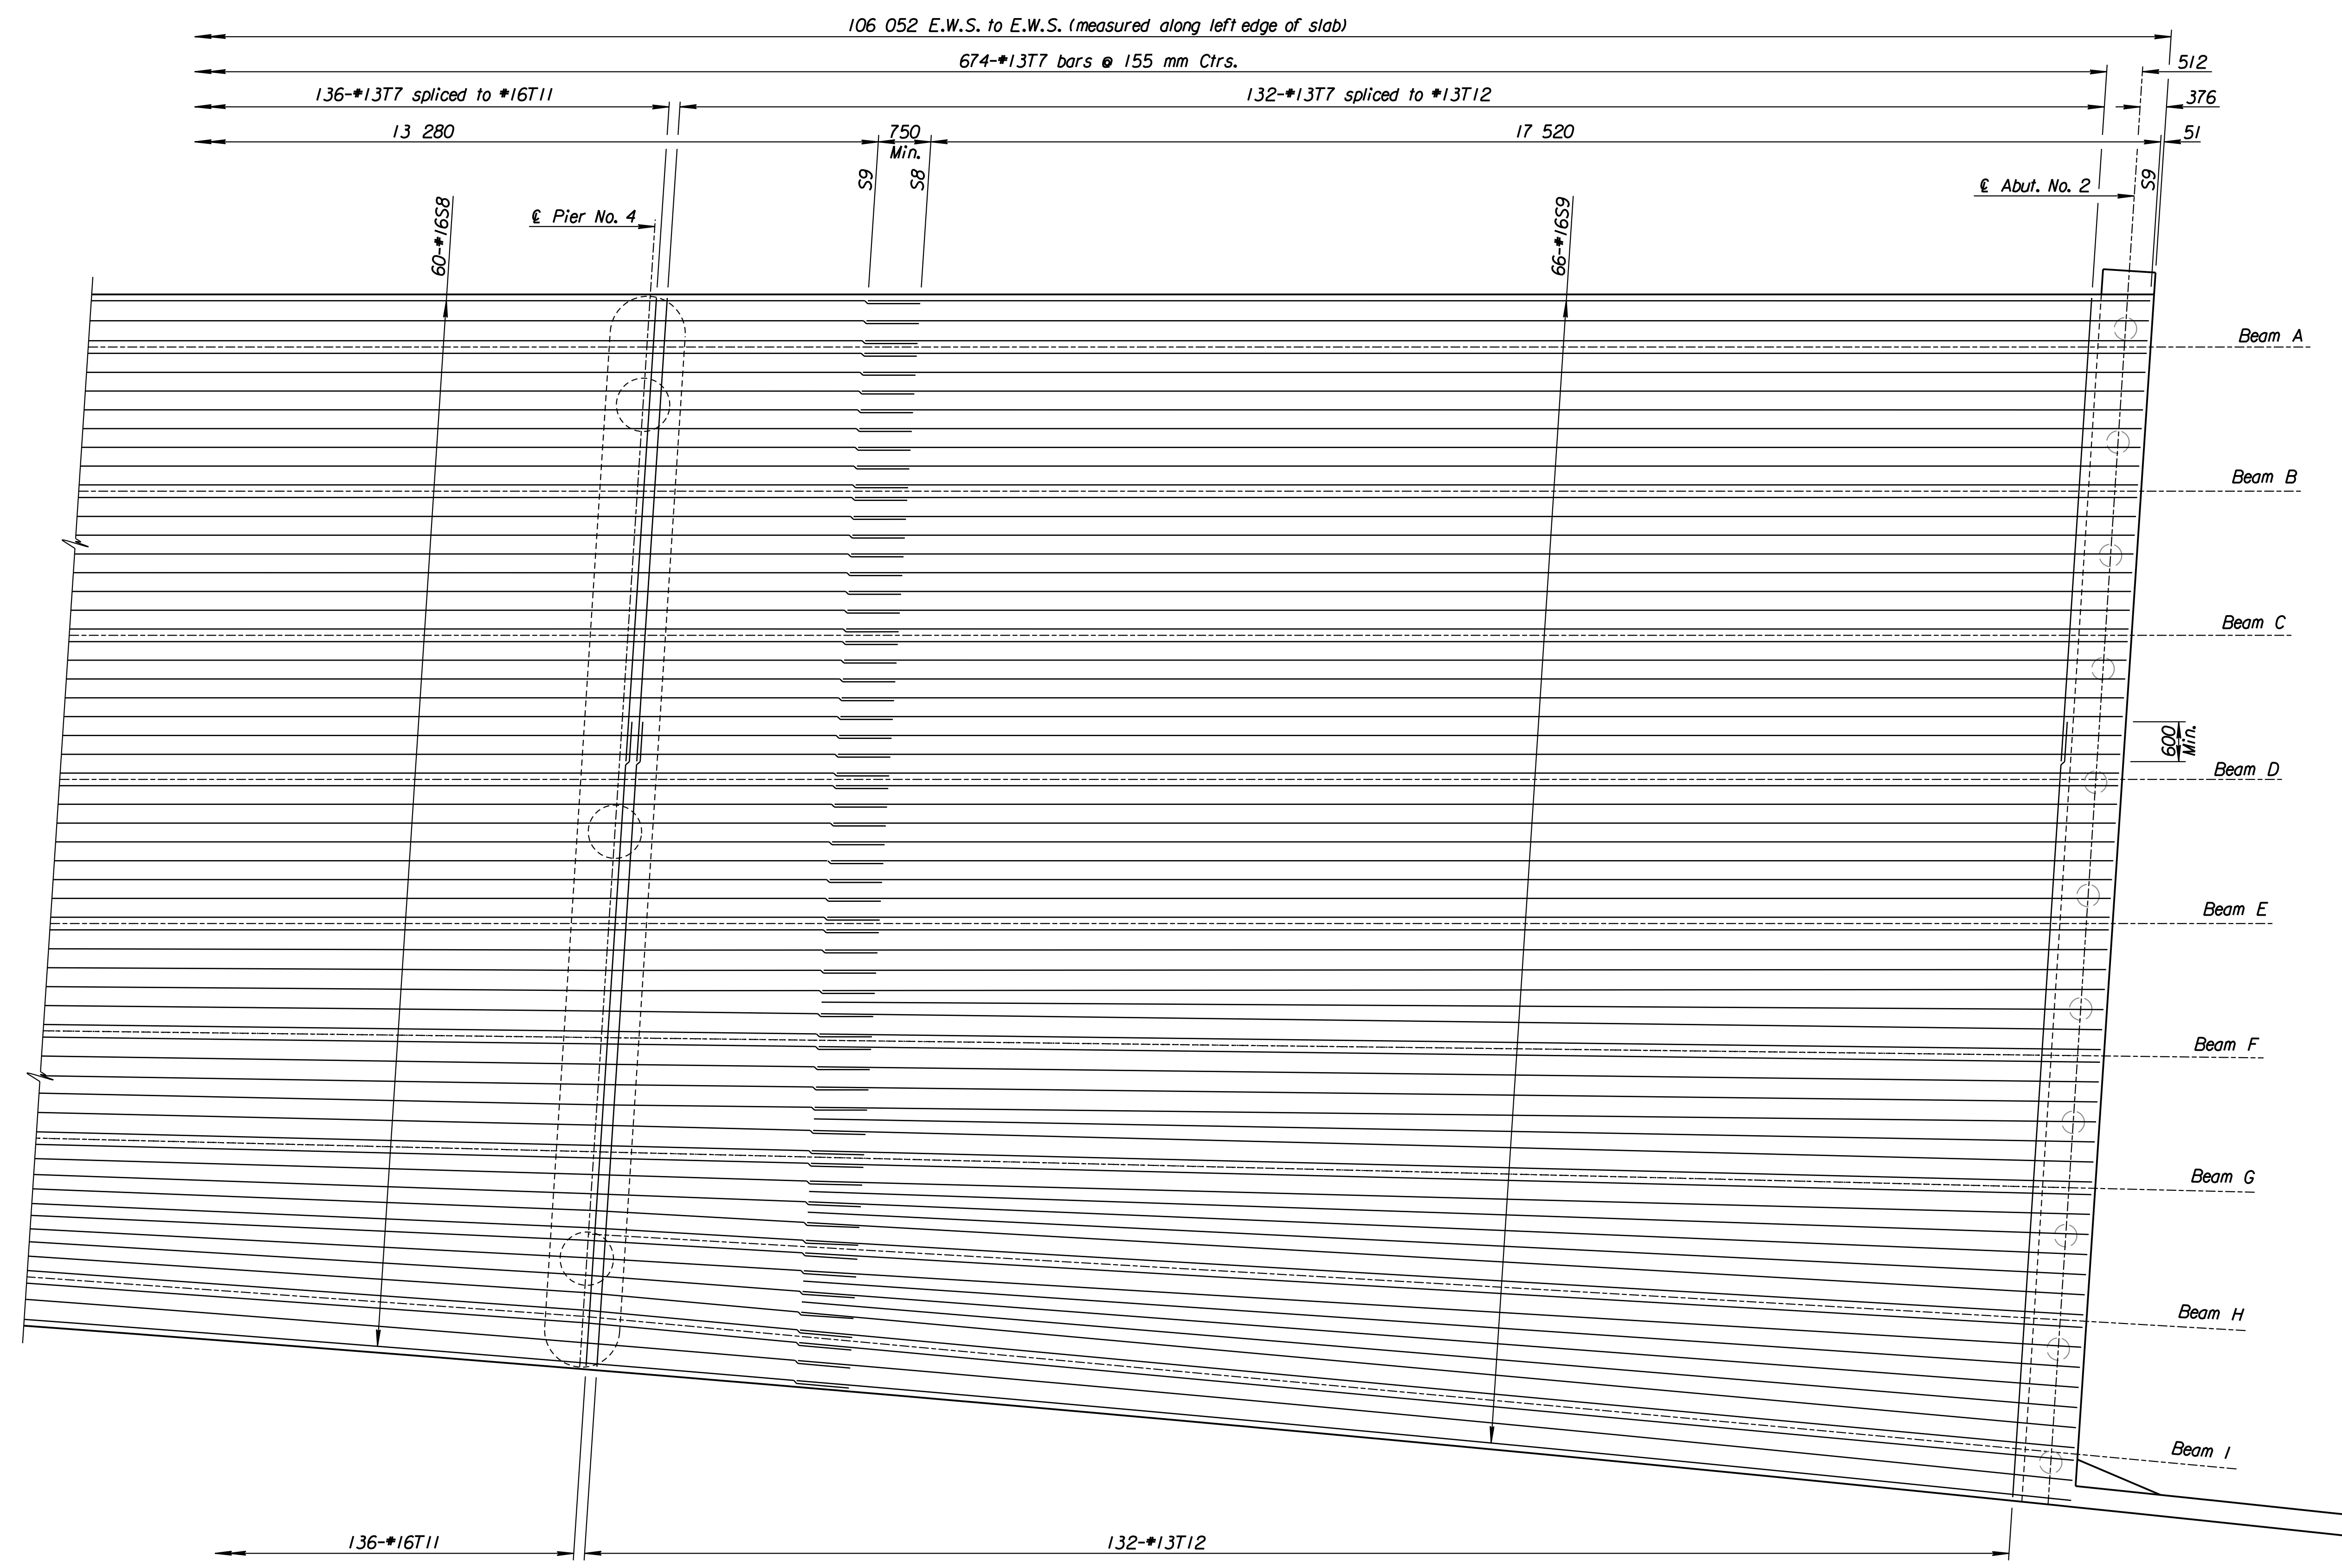


STATE	PROJECT NO.	YEAR	SHEET NO.	TOTAL SHEETS
KANSAS	54-87 K-6657-01	2002	553	1122

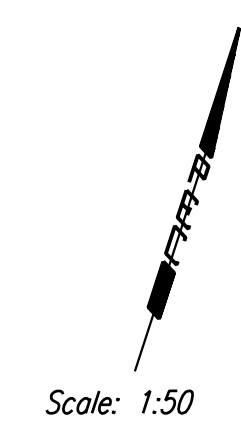

See Typical Bridge Section for additional information.

1			
No.	Revisions	By	Date
CITY OF WICHITA BR. NO. 54-87-19.29 (492) F.E.B. STA. 16+005.740 SUPERSTRUCTURE BOTTOM OF SLAB-SHEET NO. 3 E.B. FRT. RD. OVER COWSKIN CREEK SEDGWICK COUNTY			
Professional Engineering Consultants, P.A. 303 S. TOPEKA • WICHITA, KANSAS 67202 316-262-2691 • FAX 316-262-3003			
Designed by	RAS	Checked by	RAS
Drawn by	DRP	Date	April, 2002 Job No. 97362

RECORD DRAWING

Dsnr: RAS Oper: gdr Scale: 1:50
 1/1997/97.362/As-Builts/dgns/Vol_3/5h 553-suplhm3.dgn Last Rev: 9-5-07 By: gdr