



STATE	PROJECT NO.	YEAR	SHEET NO.	TOTAL SHEETS
KANSAS	54-87 K-6657-01	2002	586	1122

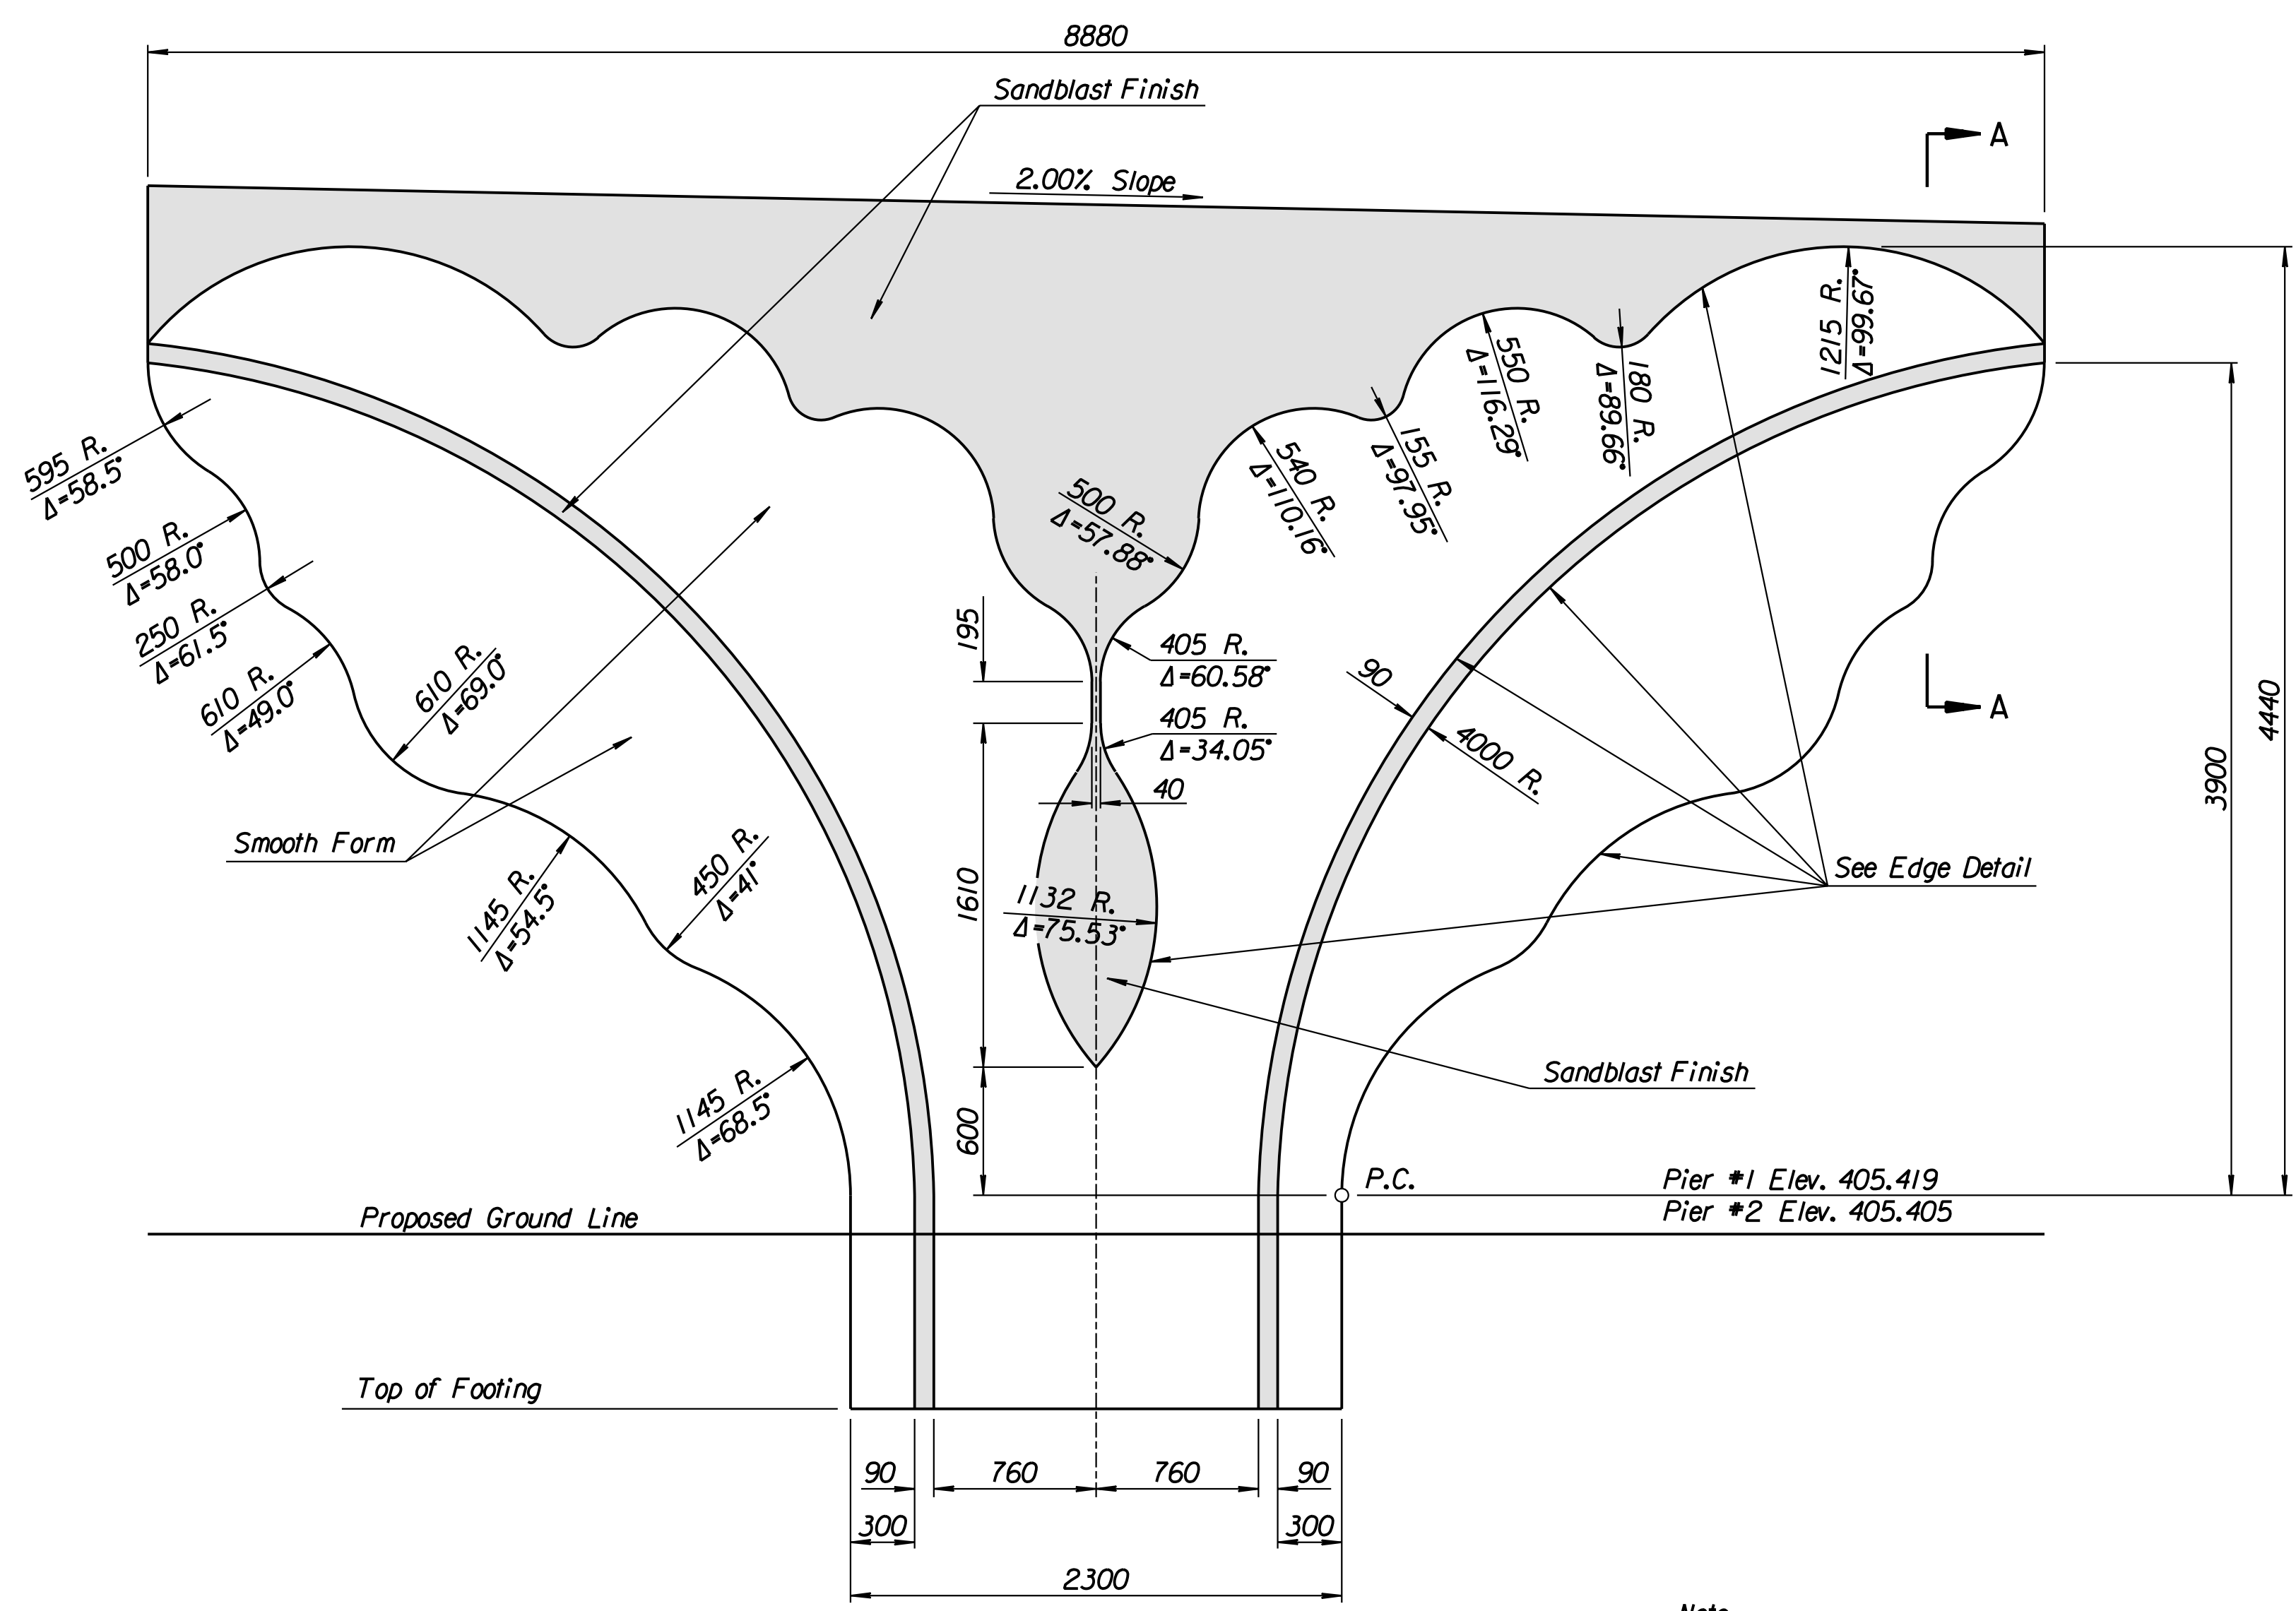

TYPICAL PIER DIMENSIONS

Note:
Sandblast Finish shall be equivalent to
*121 Sandblast *3 Form Liner by Scott Systems.

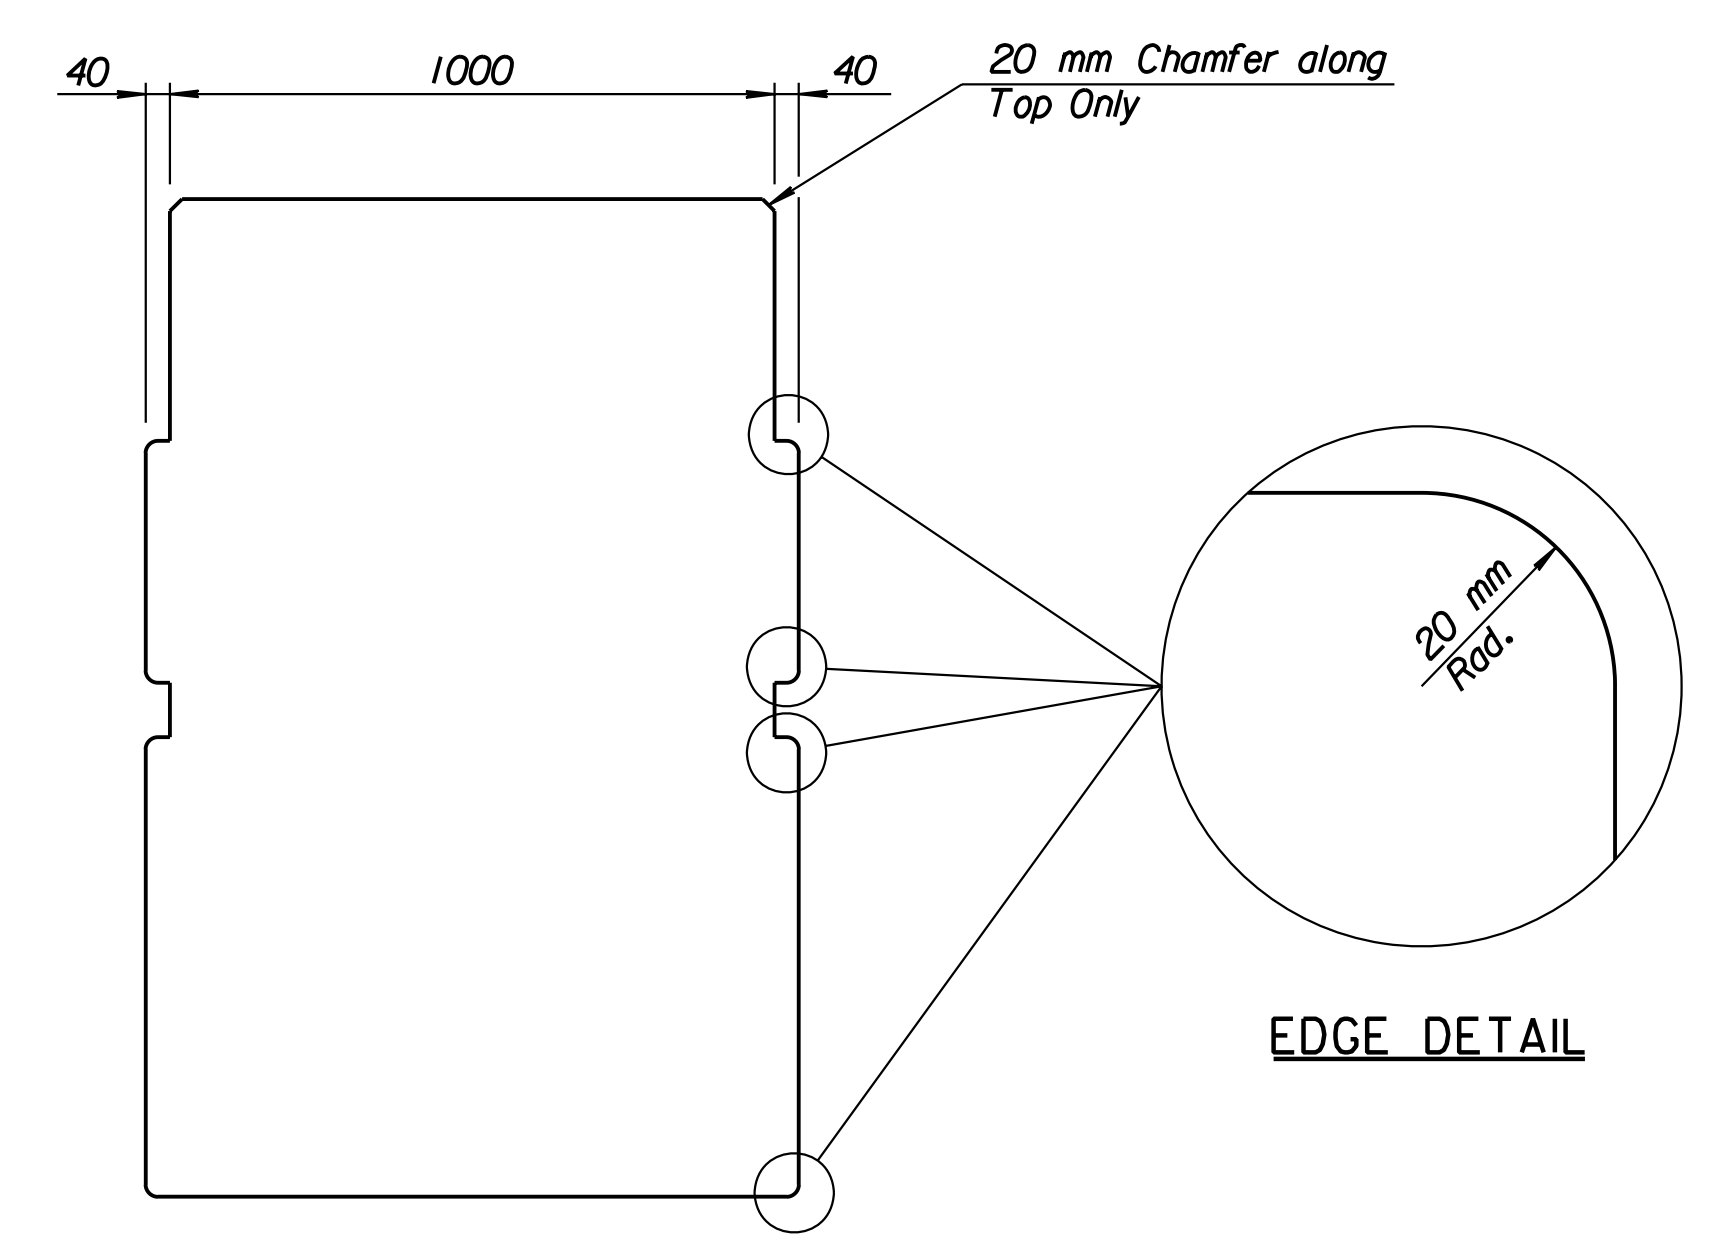

SECTION A-A

Drawn by: will
Plotted by: gdr
I:\1997\97362\As-Builts\dgn\Vol_3\Sh 586-pierdimy.dgn Last Rev: 9-6-07 By: gdr

RECORD DRAWING

No.	Revisions	By	Date
CITY OF WICHITA			
BR. NO. 54-87-20.13 (496) W.B.		STA. 17+332.607	
BR. NO. 54-87-20.12 (497) E.B.		STA. 17+332.607	
PIER GEOMETRIC DIMENSIONS			
KELLOGG (US-54) OVER TYLER ROAD SEDGWICK COUNTY			
Professional Engineering Consultants, P.A.			
303 S. TOPEKA • WICHITA, KANSAS 67202 316-262-2691 • FAX 316-262-3003			
Designed by	P.D.F.	Checked by	R.A.S.
Drawn by	W.L.L.	Date	April, 2002 Job No. 97362