


STATE	PROJECT NO.	YEAR	SHEET NO.	TOTAL SHEETS
KANSAS	54-87 K-6657-01	2002	587	1122

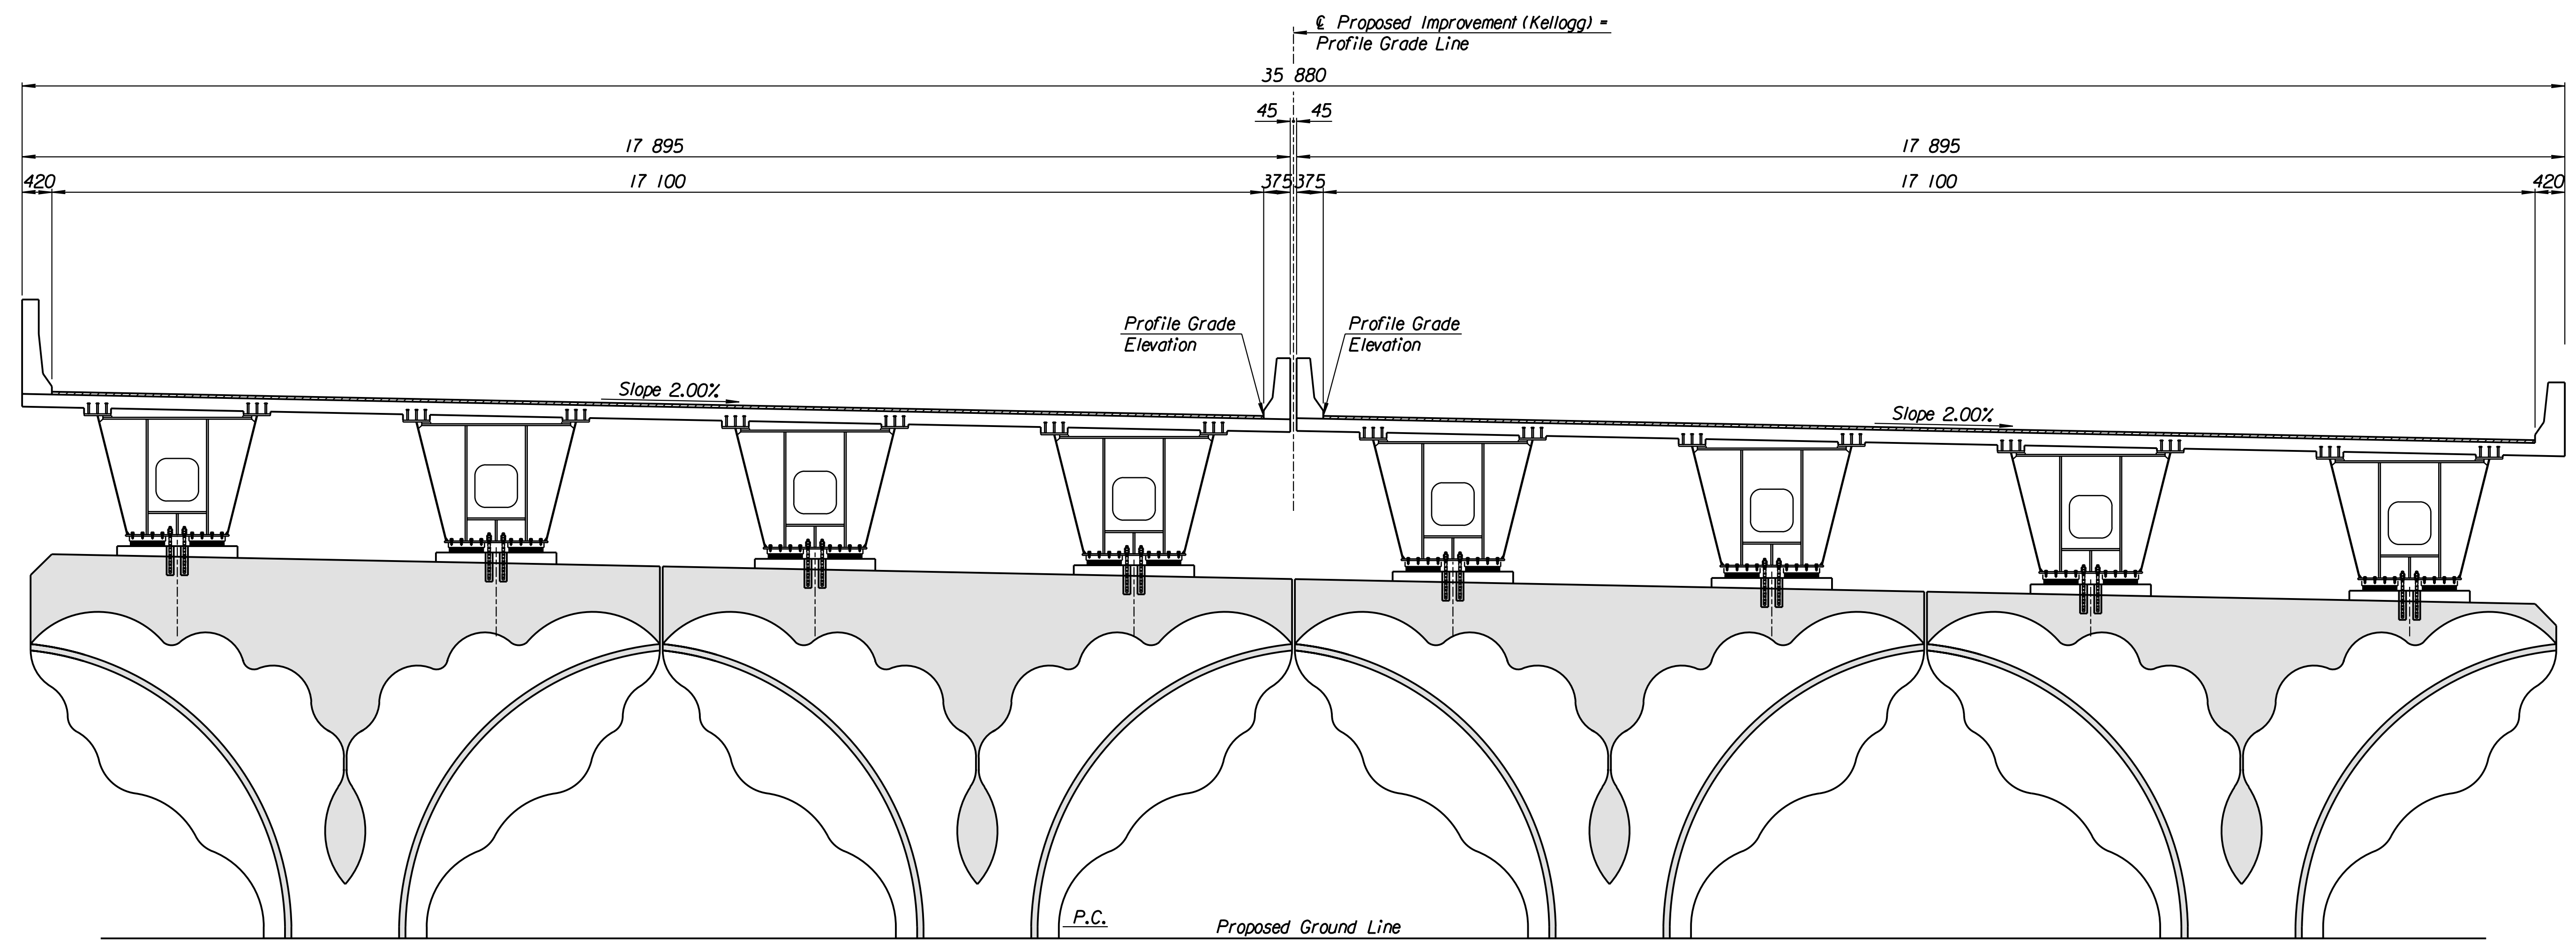

ELEVATION

DATE	BY	REFERENCES NOTED	REFERENCES CHECKED

Drawn by: will  
 Plotted by: gdr  
 l:/1997/97.362/As-Built/dgn/s/Vol\_3/Sh\_587-pier.tex.dgn Last Rev: 9-6-07 By: gdr

RECORD DRAWING

No.	Revisions	By	Date

CITY OF WICHITA  
 BR. NO. 54-87-20.13 (496) W.B. STA. 17+332.607  
 BR. NO. 54-87-20.12 (497) E.B. STA. 17+332.607

**PIER TEXTURE DETAILS**  
 KELLOGG (US-54)  
 OVER TYLER ROAD  
 SEDGWICK COUNTY

**Professional Engineering Consultants, P.A.**  
 303 S. TOPEKA • WICHITA, KANSAS 67202  
 316-262-2691 • FAX 316-262-3003

Designed by	P.D.F.	Checked by	R.A.S.
Drawn by	W.L.L.	Date	April 2002
		Job No.	97362