

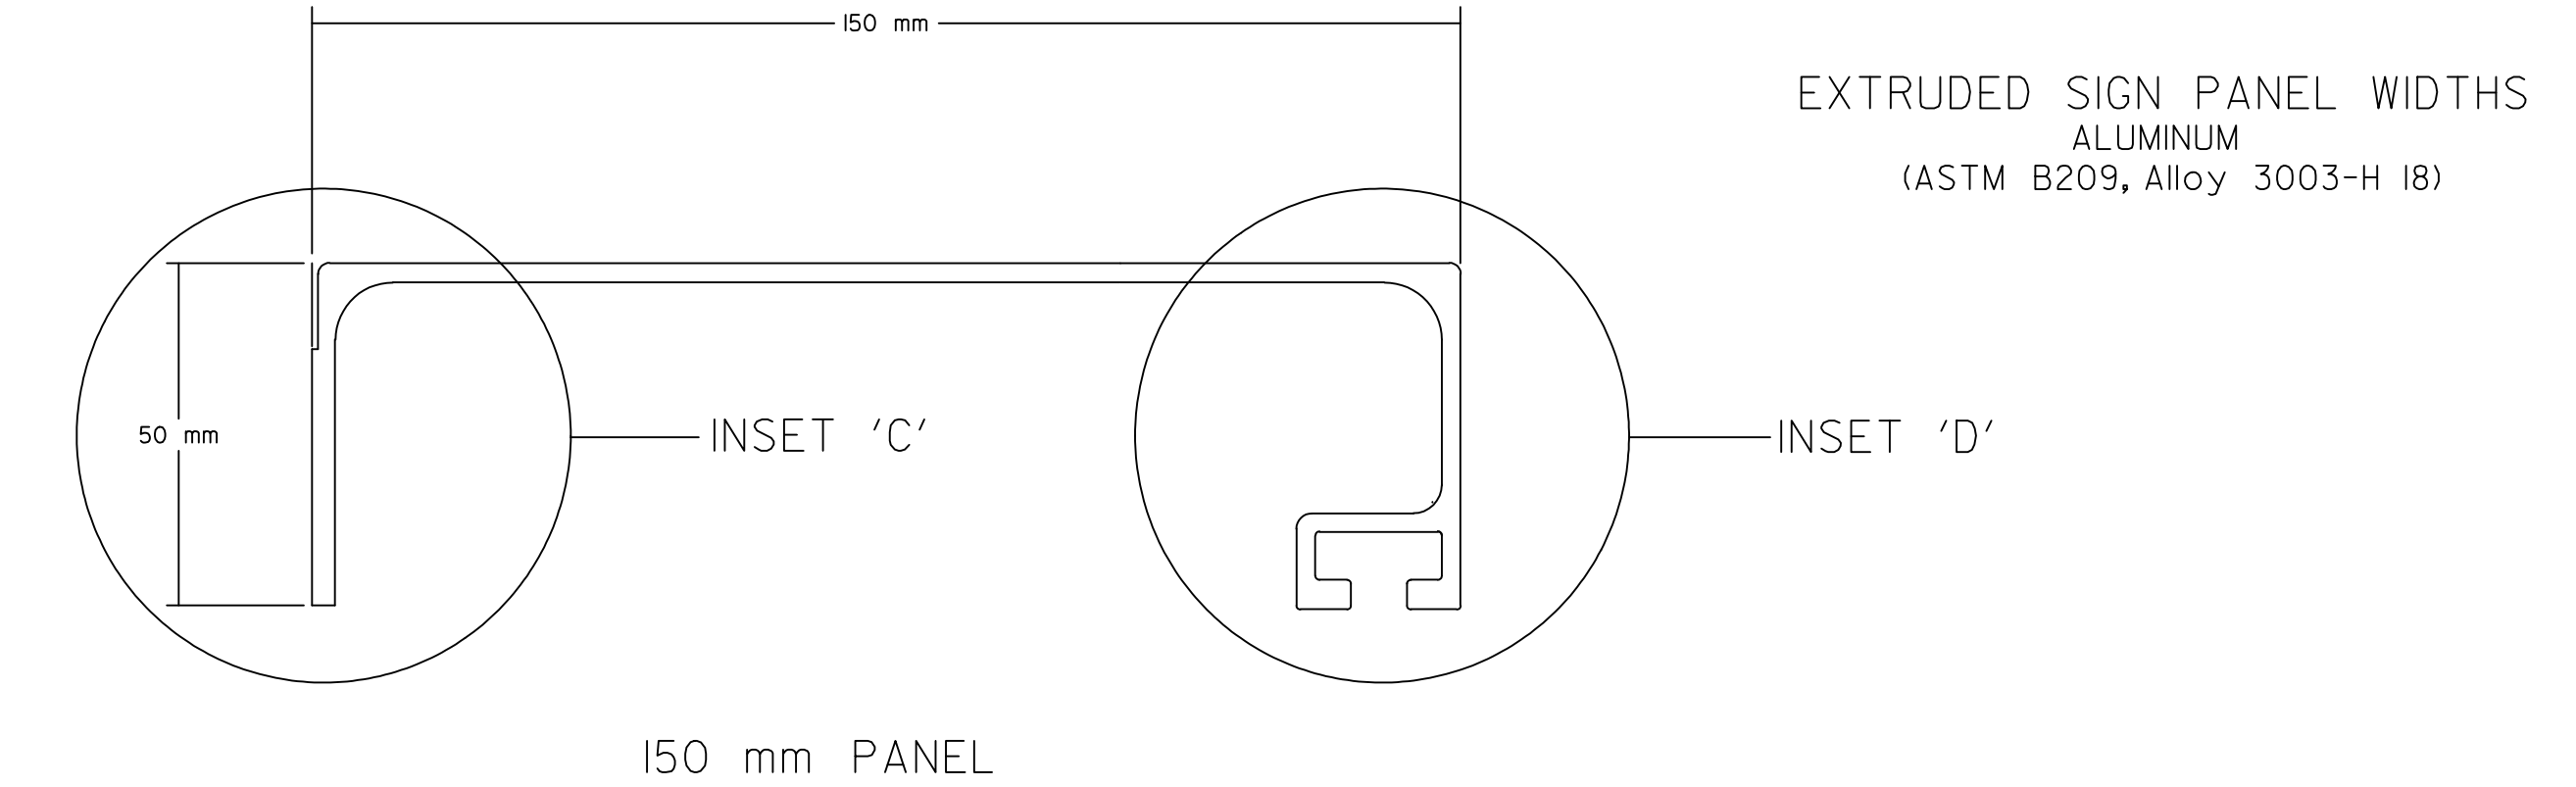
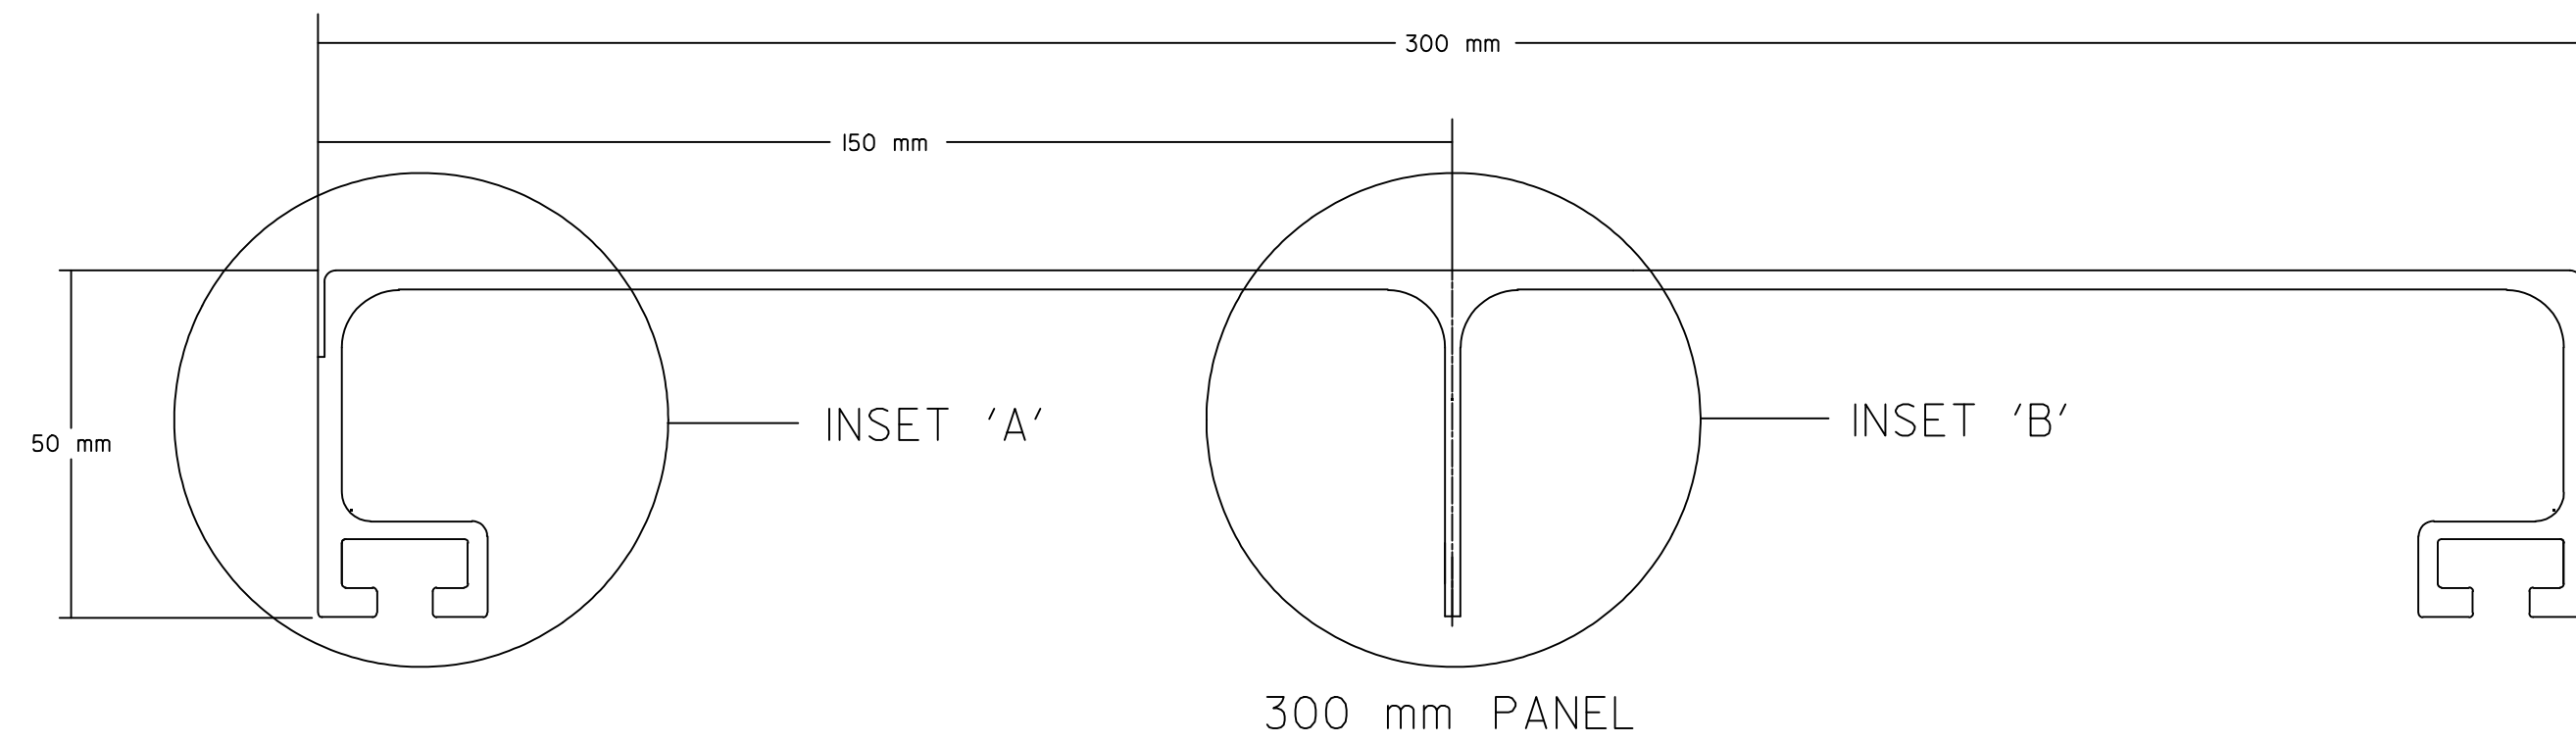
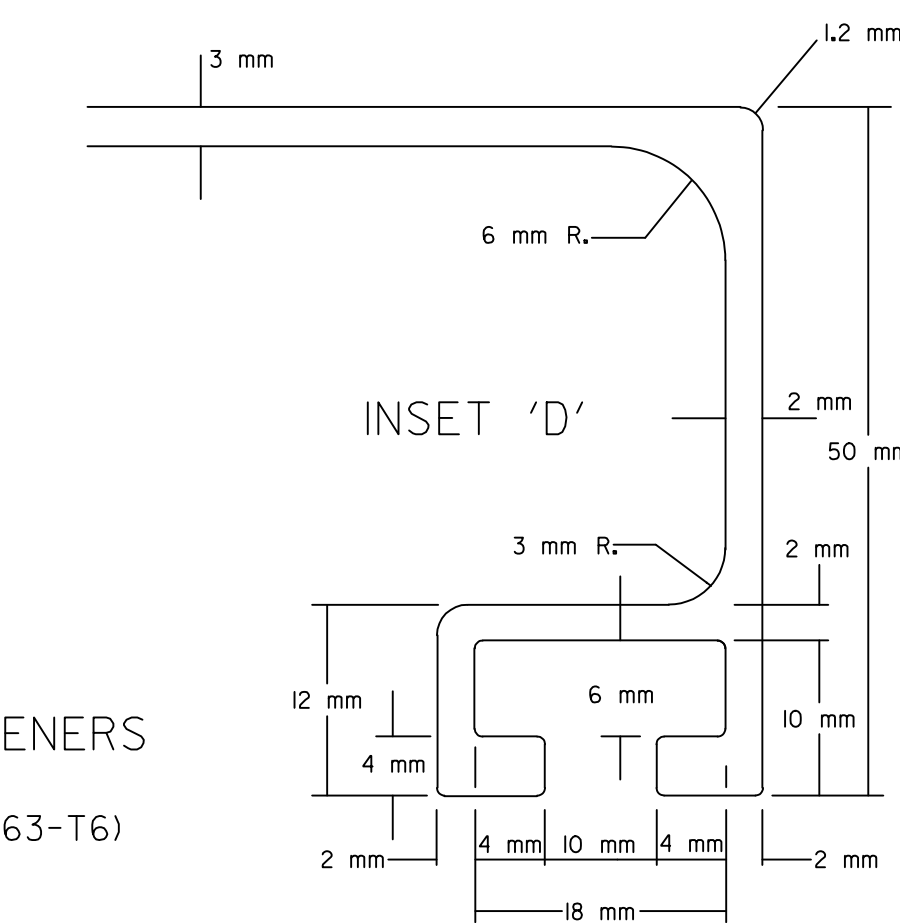
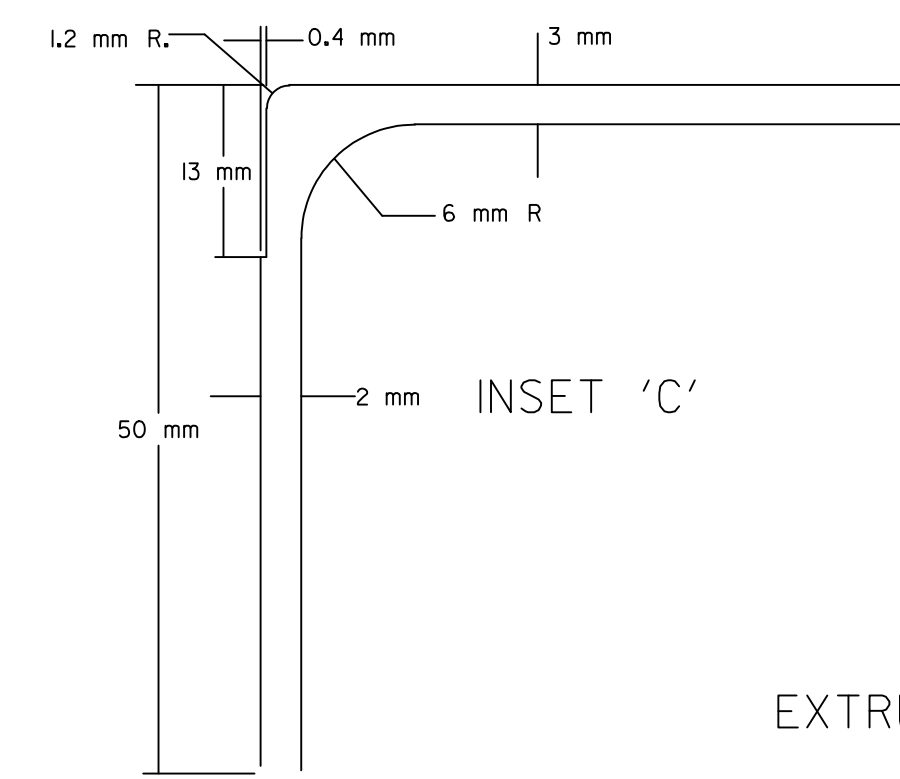



FHWA REGION NO.	STATE	PROJECT NO.	YEAR	SHEET NO.	TOTAL SHEETS
7	KANSAS	54-87 K-6657-01	2002	735	1122

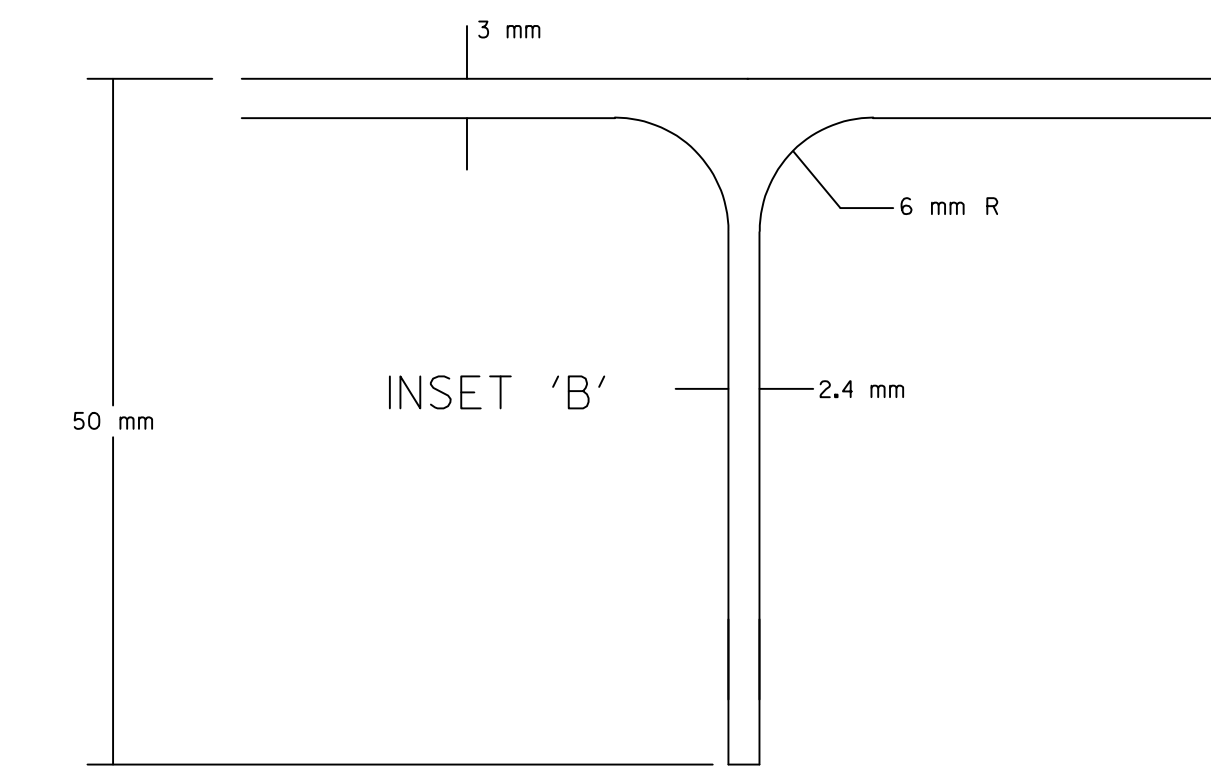


EXTRUDED SIGN PANEL WIDTHS  
ALUMINUM  
(ASTM B209, Alloy 3003-H 18)

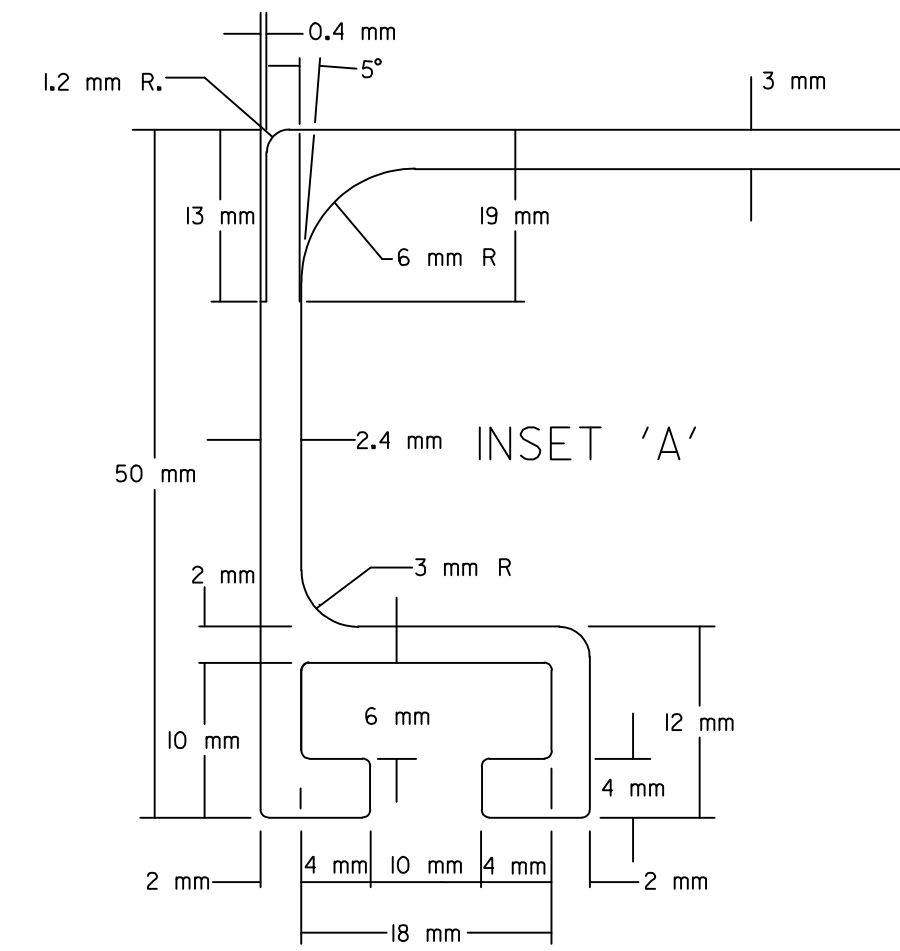

EXTRUDED STIFFENERS  
ALUMINUM  
(ASTM B221, Alloy 6063-T6)

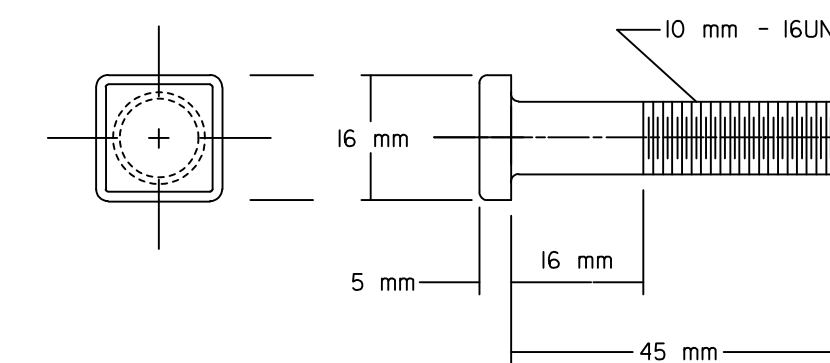


POST CLIP BOLT  
ALUMINUM  
(ASTM B211(H) ALLOY 2024-T4(C) OR 6061-T6)

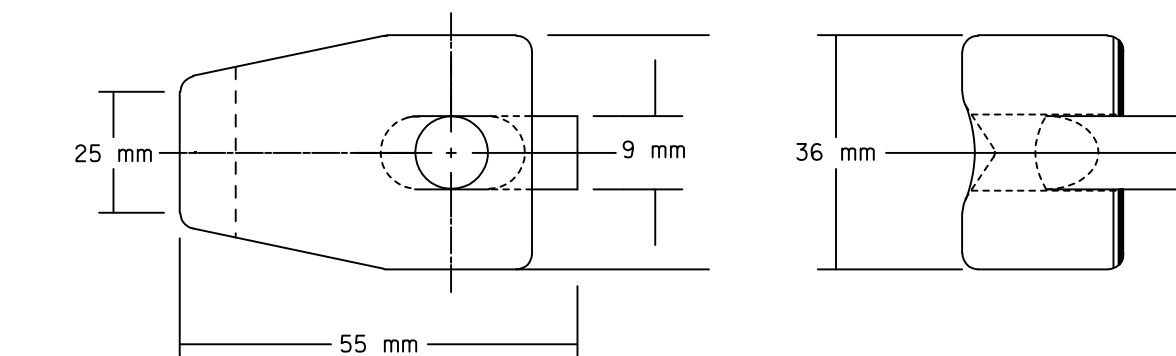

POST CLIP  
ALUMINUM  
(ASTM B108, Alloy 356.0-T6  
Alloy A 356.0-T6(A)  
Alloy 356.0-F(B),(G))

- NOTES: EXTRUDED PANEL TOLERANCE
1. Gap between two adjacent panels shall not exceed 1.6 mm.
  2. Allowable lateral bow in panel shall not exceed ± 3 mm.
  3. Length of panel shall not exceed ± 3 mm from specified length.
  4. All inside and outside corners are to be 0.8 mm radius unless otherwise specified.

- EXTRUDED PANEL WIDTH ASSEMBLY
1. For extruded panelsigns with an overallheight in even meters, use only the 300 mm wide panel.
  2. For extruded panelsigns with an overallheight in intervals of 150 mm, use the 150 mm wide panel at the top or bottom of the sign. All other panels are to be the 300 mm wide panel.

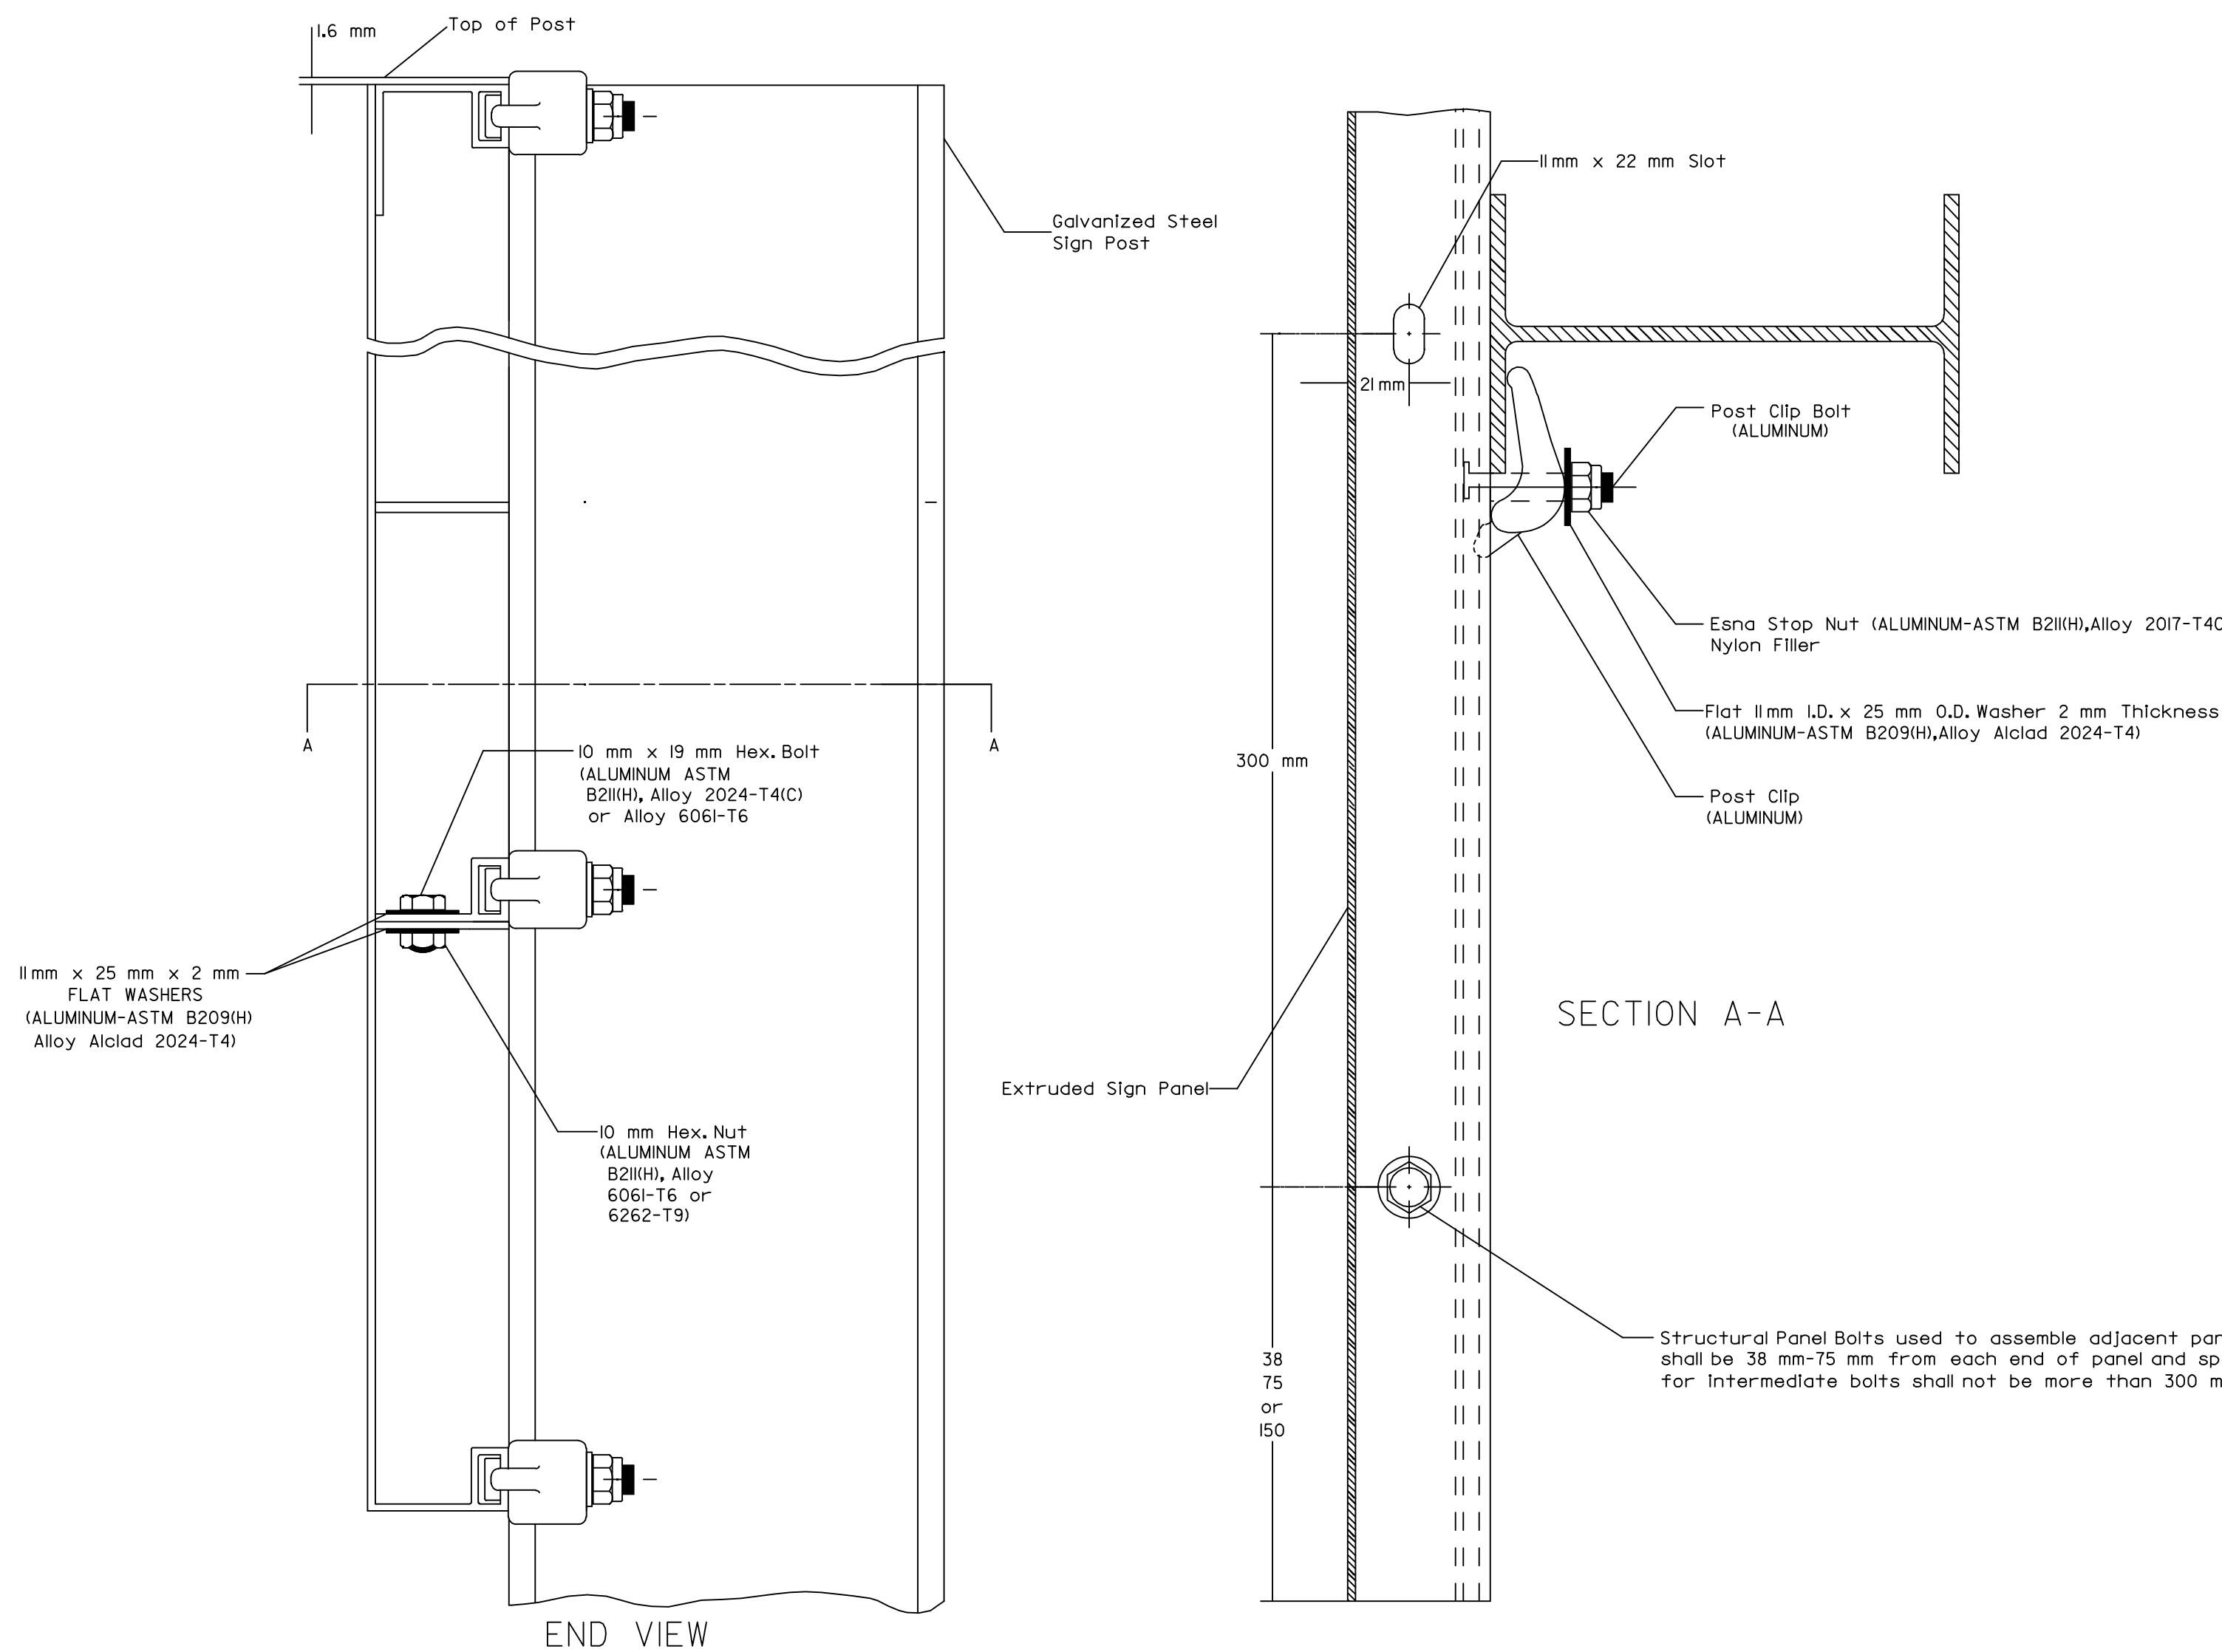

SECTION A-A

Structural Panel Bolts used to assemble adjacent panels shall be 38 mm-75 mm from each end of panel and spacing for intermediate bolts shall not be more than 300 mm.

All dimensions are in millimeters

3				
2				
1				
NO.	DATE	REVISION	BY	APP'D

KANSAS DEPARTMENT OF TRANSPORTATION				
FABRICATION OF EXTRUDED SIGN				
PANEL & MOUNTING DETAIL FOR				
SIGN PANEL ON STEEL I-BEAM POST				
TE636SI				7-20-93
FHWA APPROVAL I-10-95	DESIGNED	APP'D	NELDA A BUCKLEY	
DESIGNED	DETAILED	KS	QUANTITIES	TRACED
DESIGN CK.	DETAIL CK.		QUAN. CK.	TRACE CK.

RECORD DRAWING

DSNR: OPER: SVB SCALE: 1  
 I:/1997/97362/As-Builts/dgn/Vol.4/Sh 735-KDOT\_ST-D-TE636SI.dgn Last Rev: 10-3-07 Bjs gdr