



STATE	PROJECT NO.	YEAR	SHEET NO.	TOTAL SHEETS
KANSAS	54-87 K-6657-01	2002	746	1122

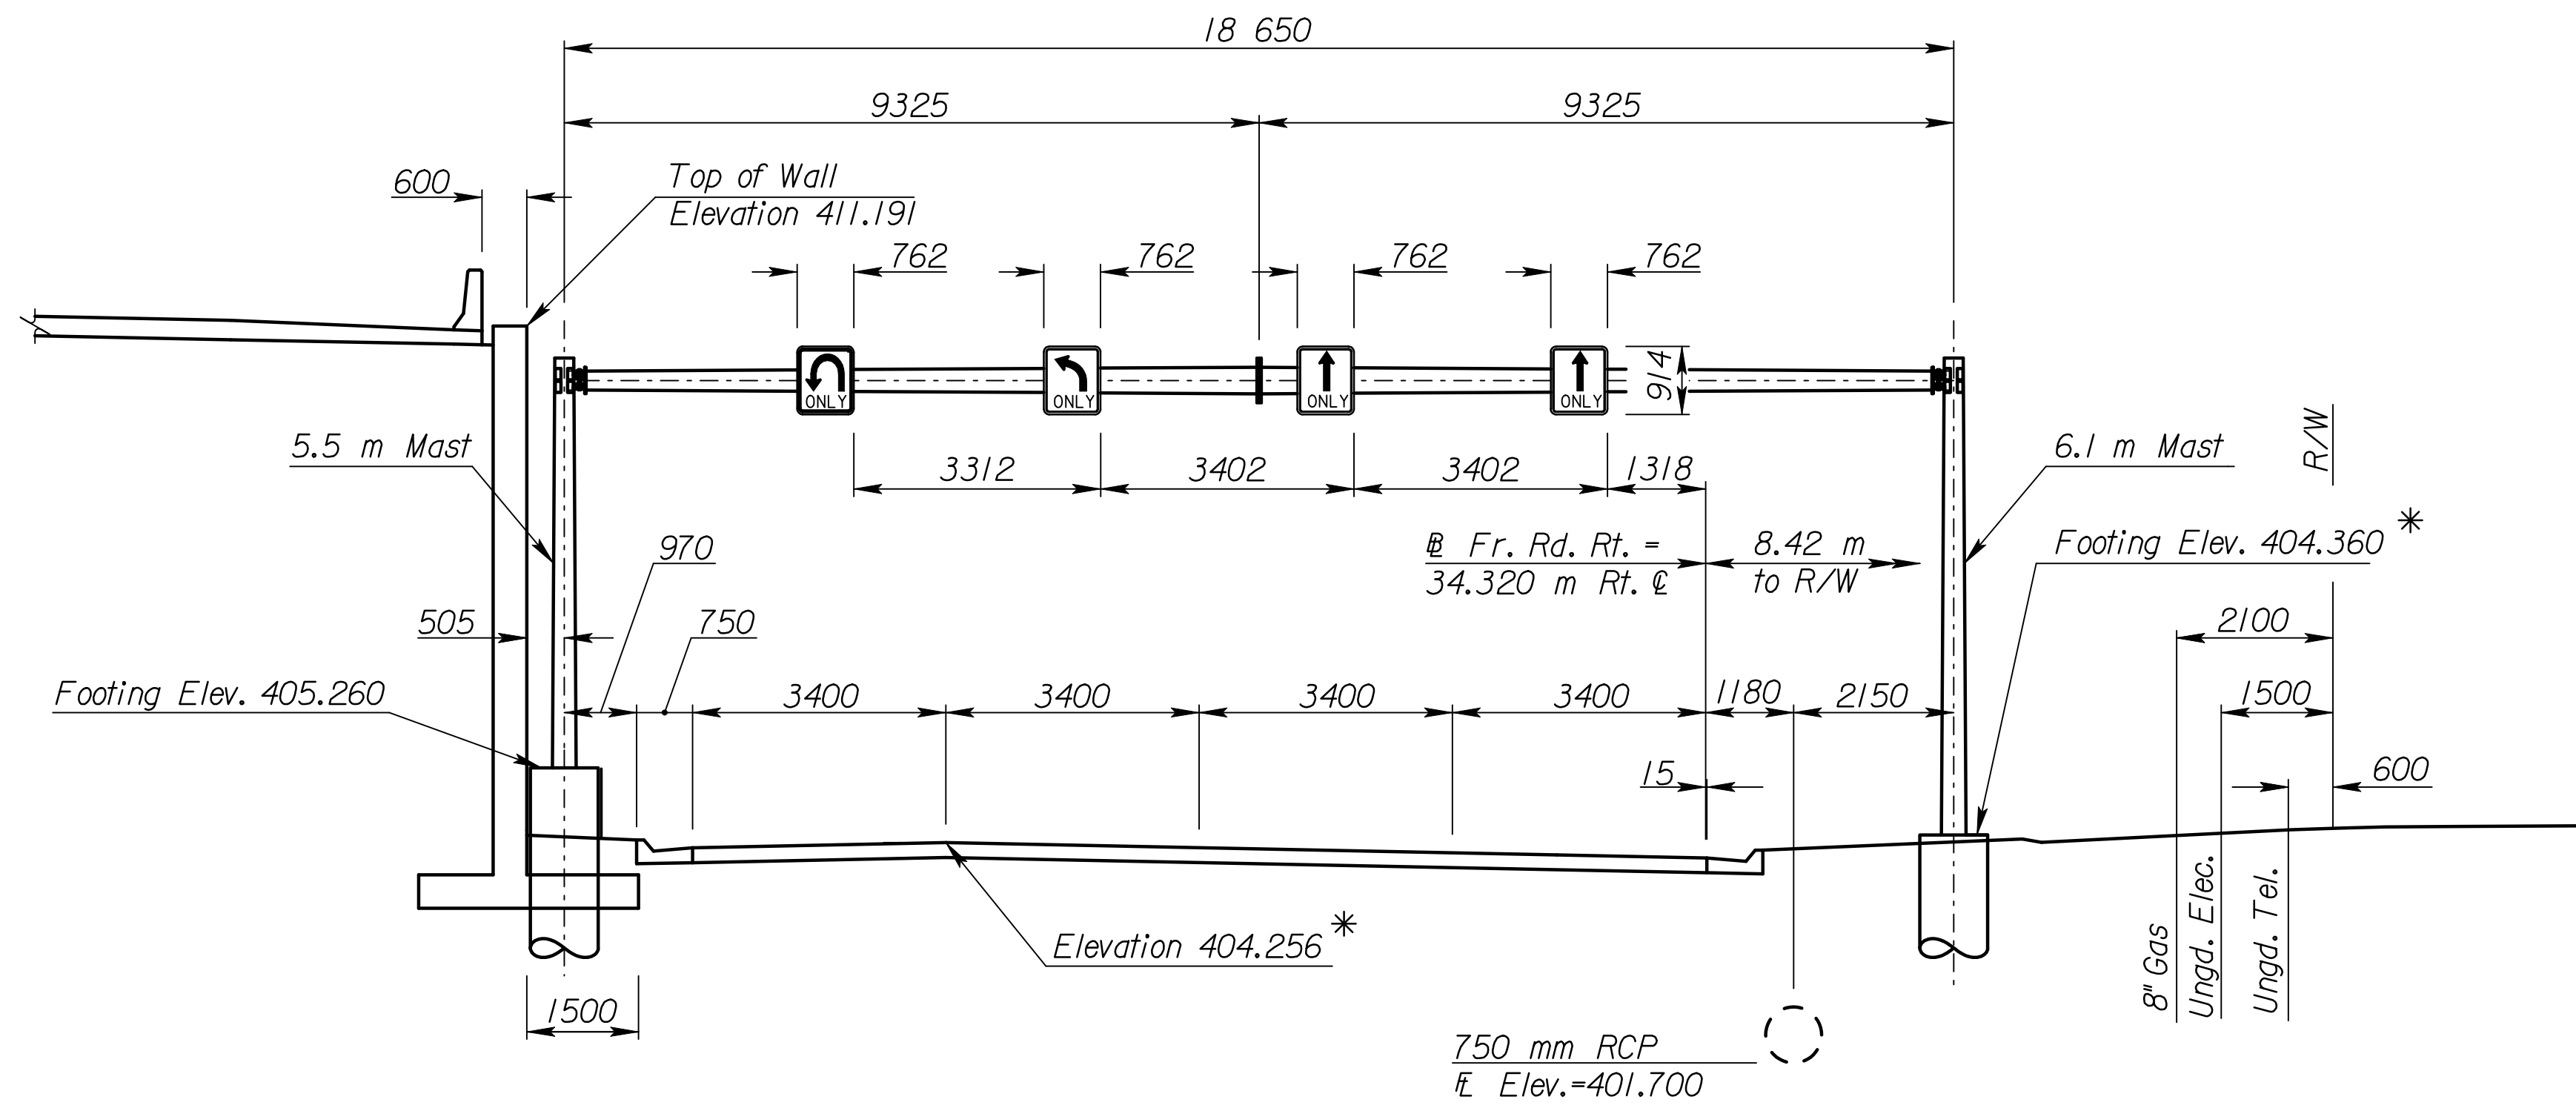

ELEVATION
Fr. Rd. Rt. Sta. 17+228

* Note: Vary the footing elevations as necessary to maintain a minimum vertical clearance of 5.300 m.

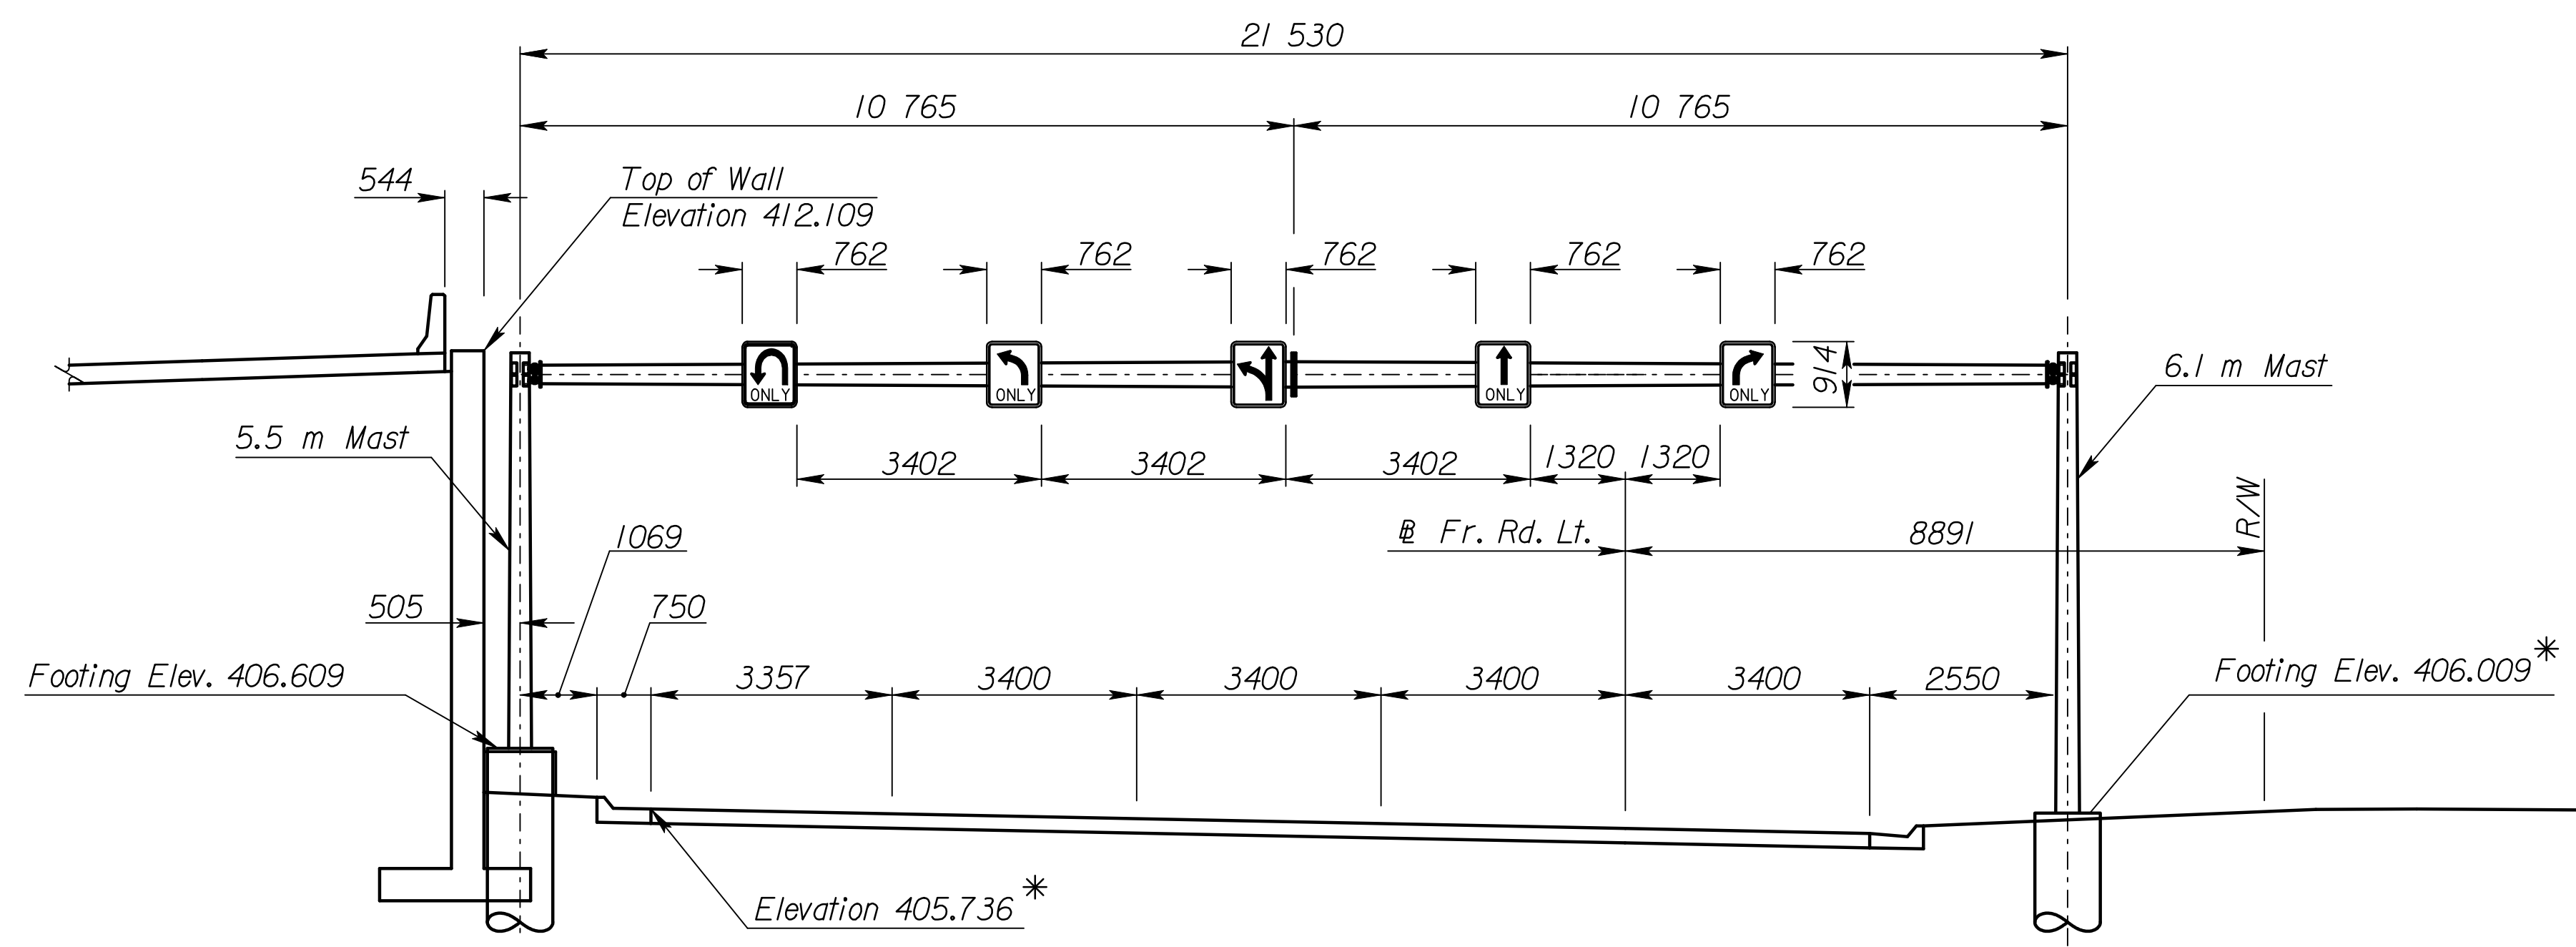

ELEVATION
Fr. Rd. Lt. Sta. 17+478

RECORD DRAWING

3					
2					
1					
NO.	DATE	REVISIONS	BY	APP'D	
KANSAS DEPARTMENT OF TRANSPORTATION					
SINGLE TAPERED TUBE SPAN TYPE OVERHEAD SIGN STRUCTURE CONSTRUCTION LAYOUT					
PROJ. NO. 54-87 K-6657-01			SEDGWICK CO.		
SHEET NO. 2 OF 44	SCALE	APP'D			
DESIGNED	SMB	DETAILED	SMB	QUANTITIES	CADD
DESIGN CK.	DETAIL CK.	QUAN. CK.	CADD CK.		

Scale = 1/8" = 1'-0"
I:\1997\97362\As-Builts\dgn\Vol 4\Sh 746-KDOT STD-Sign-Mono Tubes.dgn Last Rev. 10-3-07 By: gdr