


ELEVATION

\* Note: Use this point as a control point for all elevations.

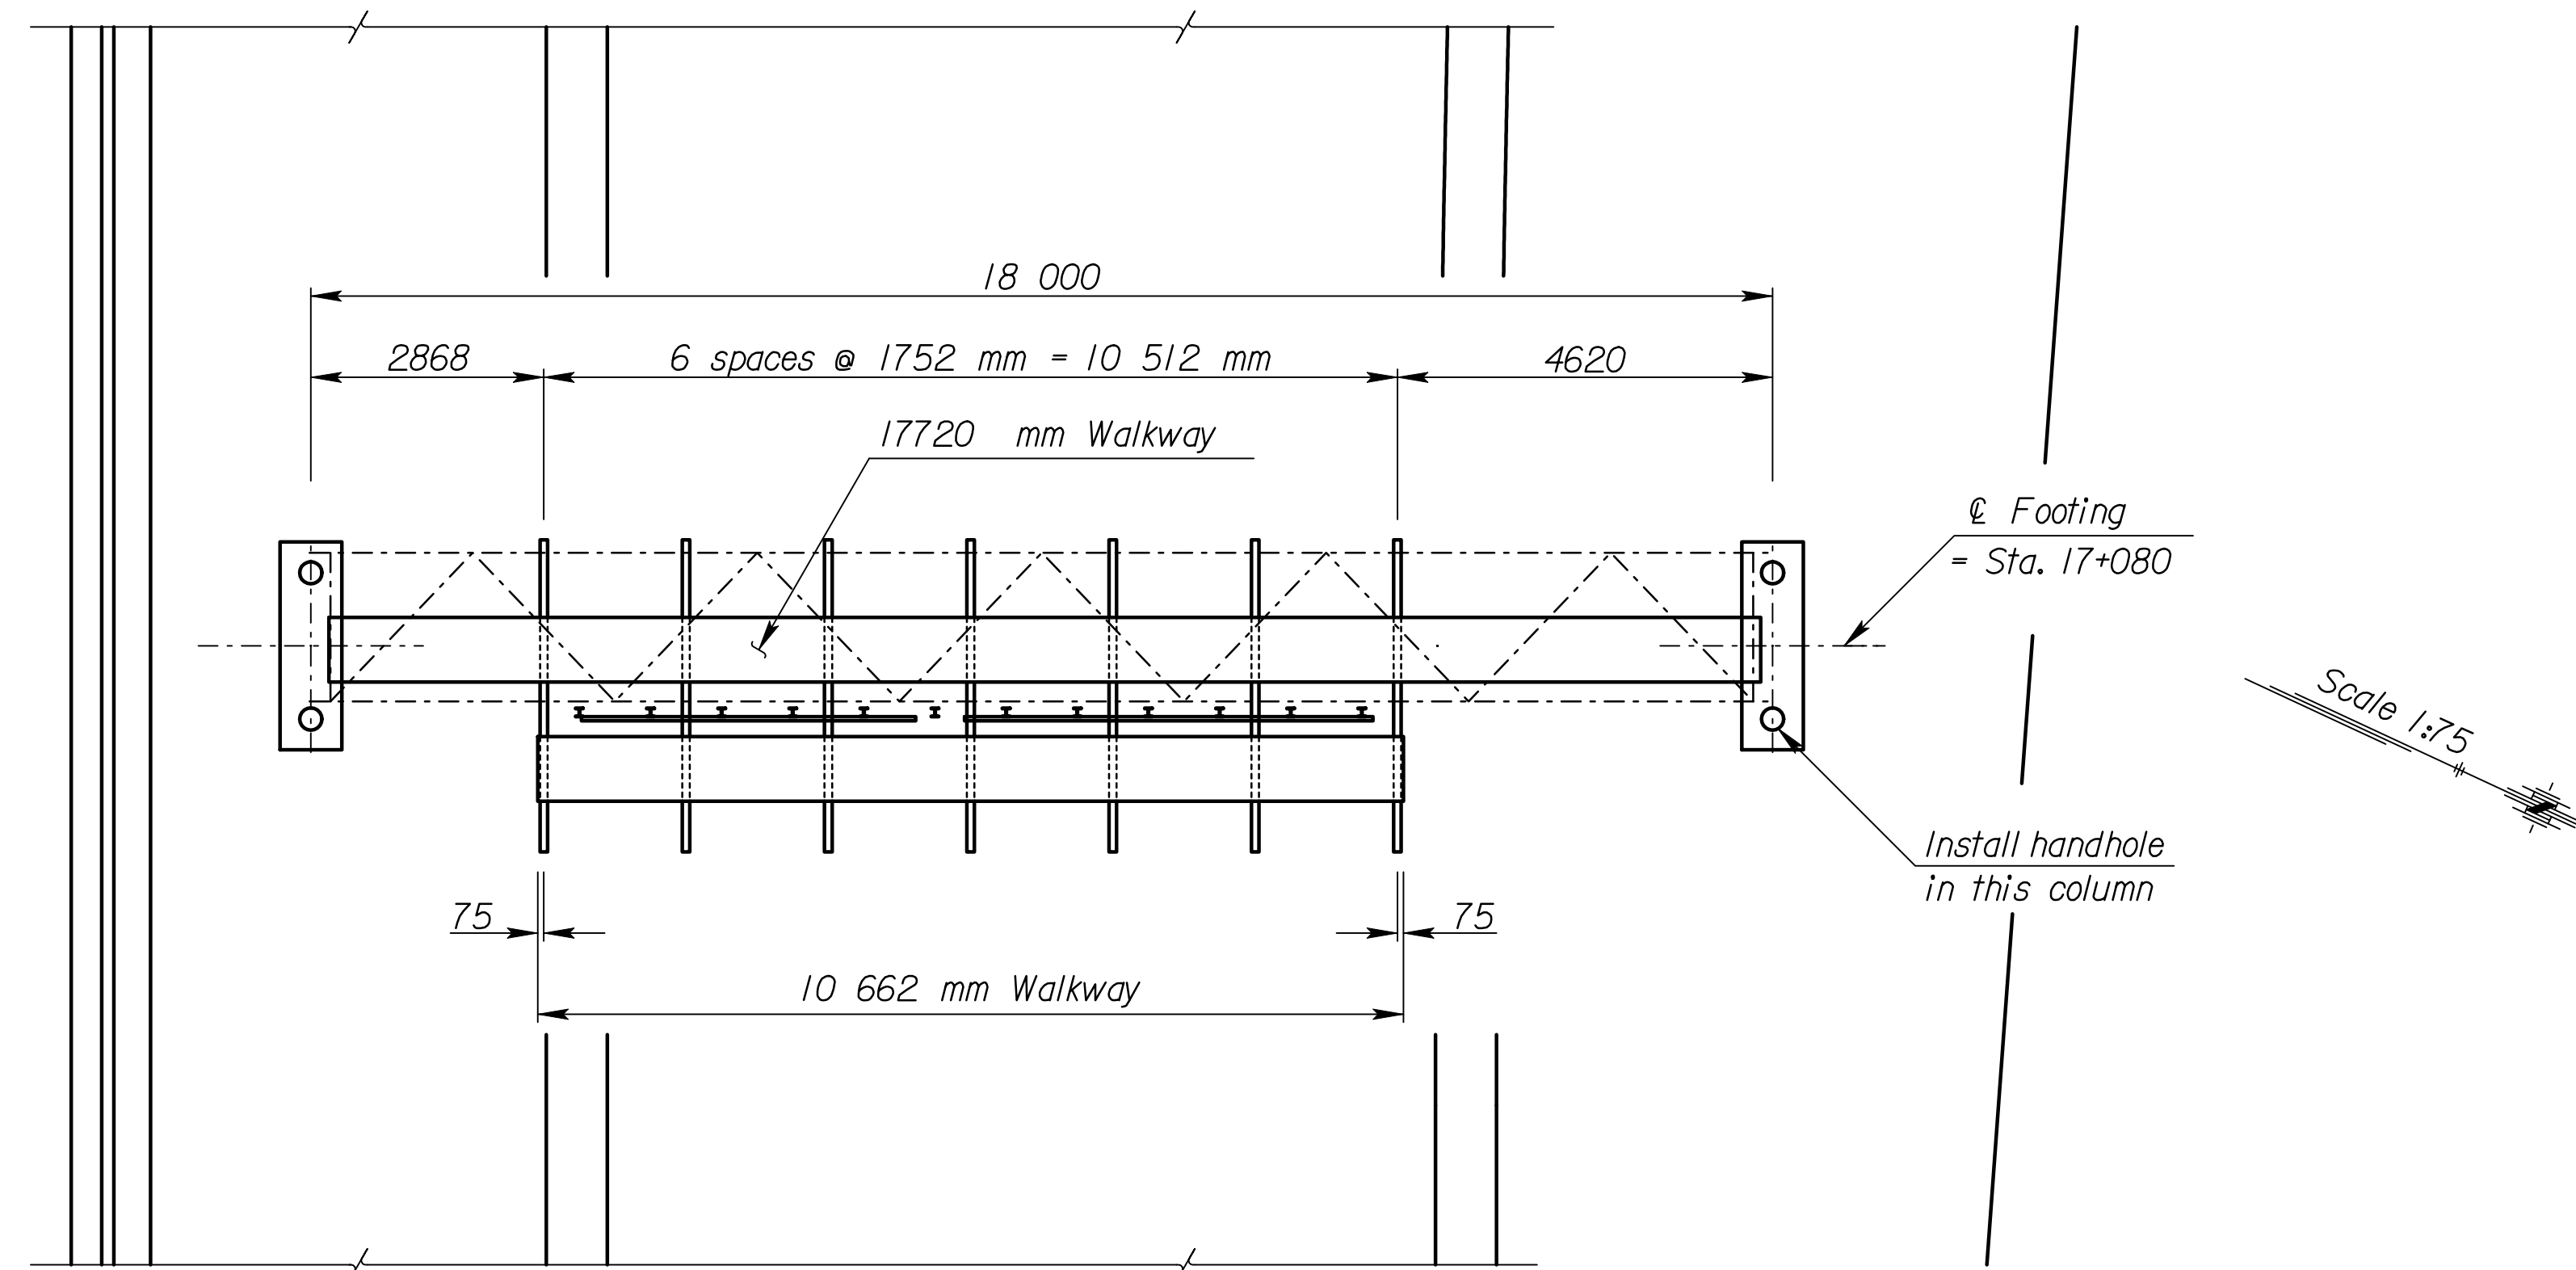

PLAN

STEEL NOT USED

		STEEL DETAILS			
TRUSS	Member 1 Wall Thickness				4.78
	Member 2 Wall Thickness				3.05
	N = 10 X = 240 S = 1752 Camber = 22				
END SUPPORTS	Member 1 Wall Thickness				4.78
	Member 2 Wall Thickness				3.18
FOOTINGS	Left N = 3 S = 1535 L = 6970				
	Right N = 3 S = 1600 L = 7165				
	Left Type	B	Right Type	B	

RECORD DRAWING

3					
2					
1					
NO.	DATE	REVISIONS	BY	APP'D	
<b>KANSAS DEPARTMENT OF TRANSPORTATION</b> WB US-54 Fr. Rd. Lt. STATION 17+080 SPAN TYPE OVERHEAD SIGN STRUCTURE CONSTRUCTION LAYOUT STEEL ALTERNATE					
PROJ. NO. 54-87 K-6657-01			SEDGWICK CO.		
SHEET NO. 15 OF 44	SCALE	APP'D	DESIGNED	SMB	QUANTITIES
DESIGN CK.	DETAIL CK.	QUAN. CK.	CADD	CK.	CADD CK.