



STATE	PROJECT NO.	YEAR	SHEET NO.	TOTAL SHEETS
KANSAS	54-87 K-6657-01	2002	760	1122

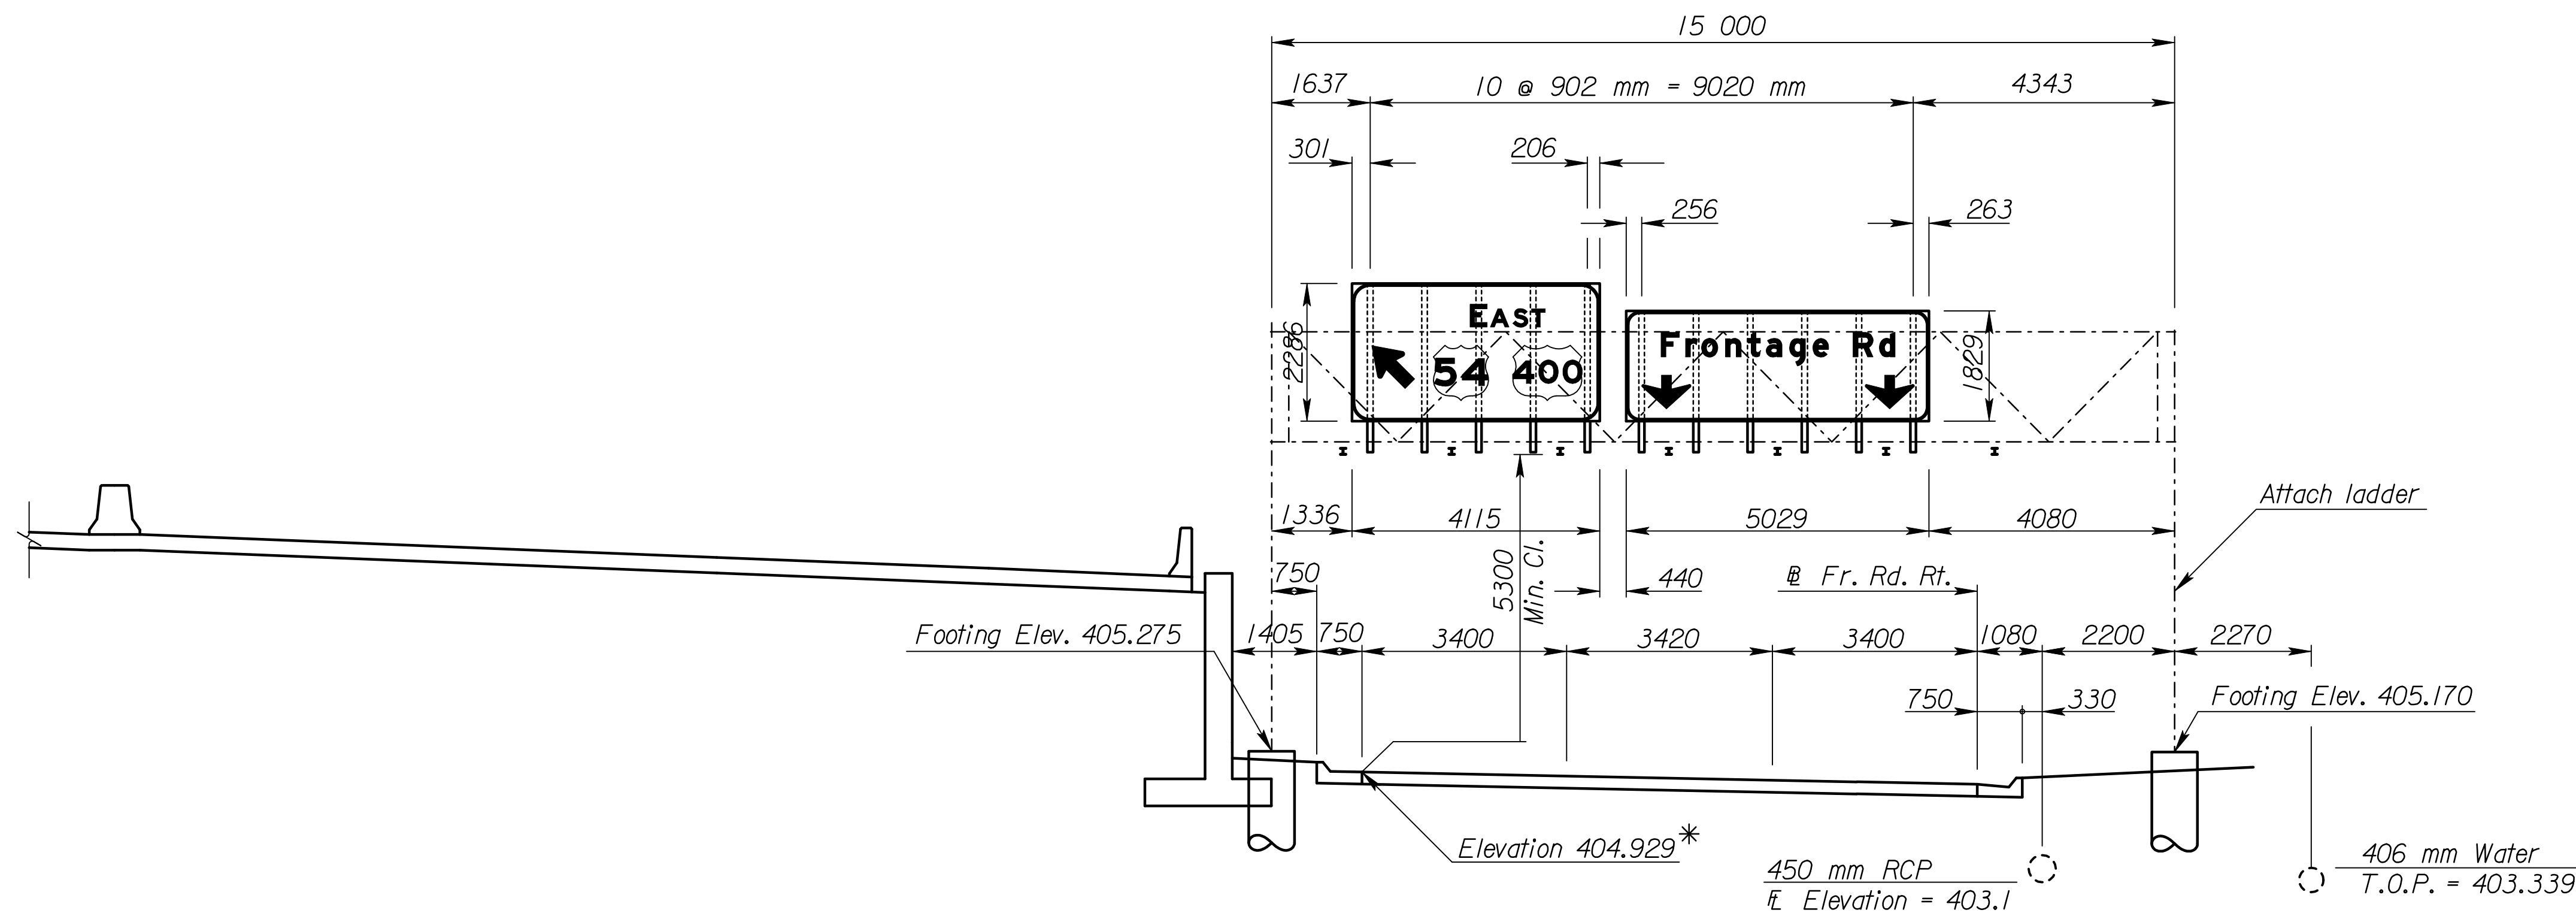

\* Note: Use this point as a control point for all elevations.

ELEVATION

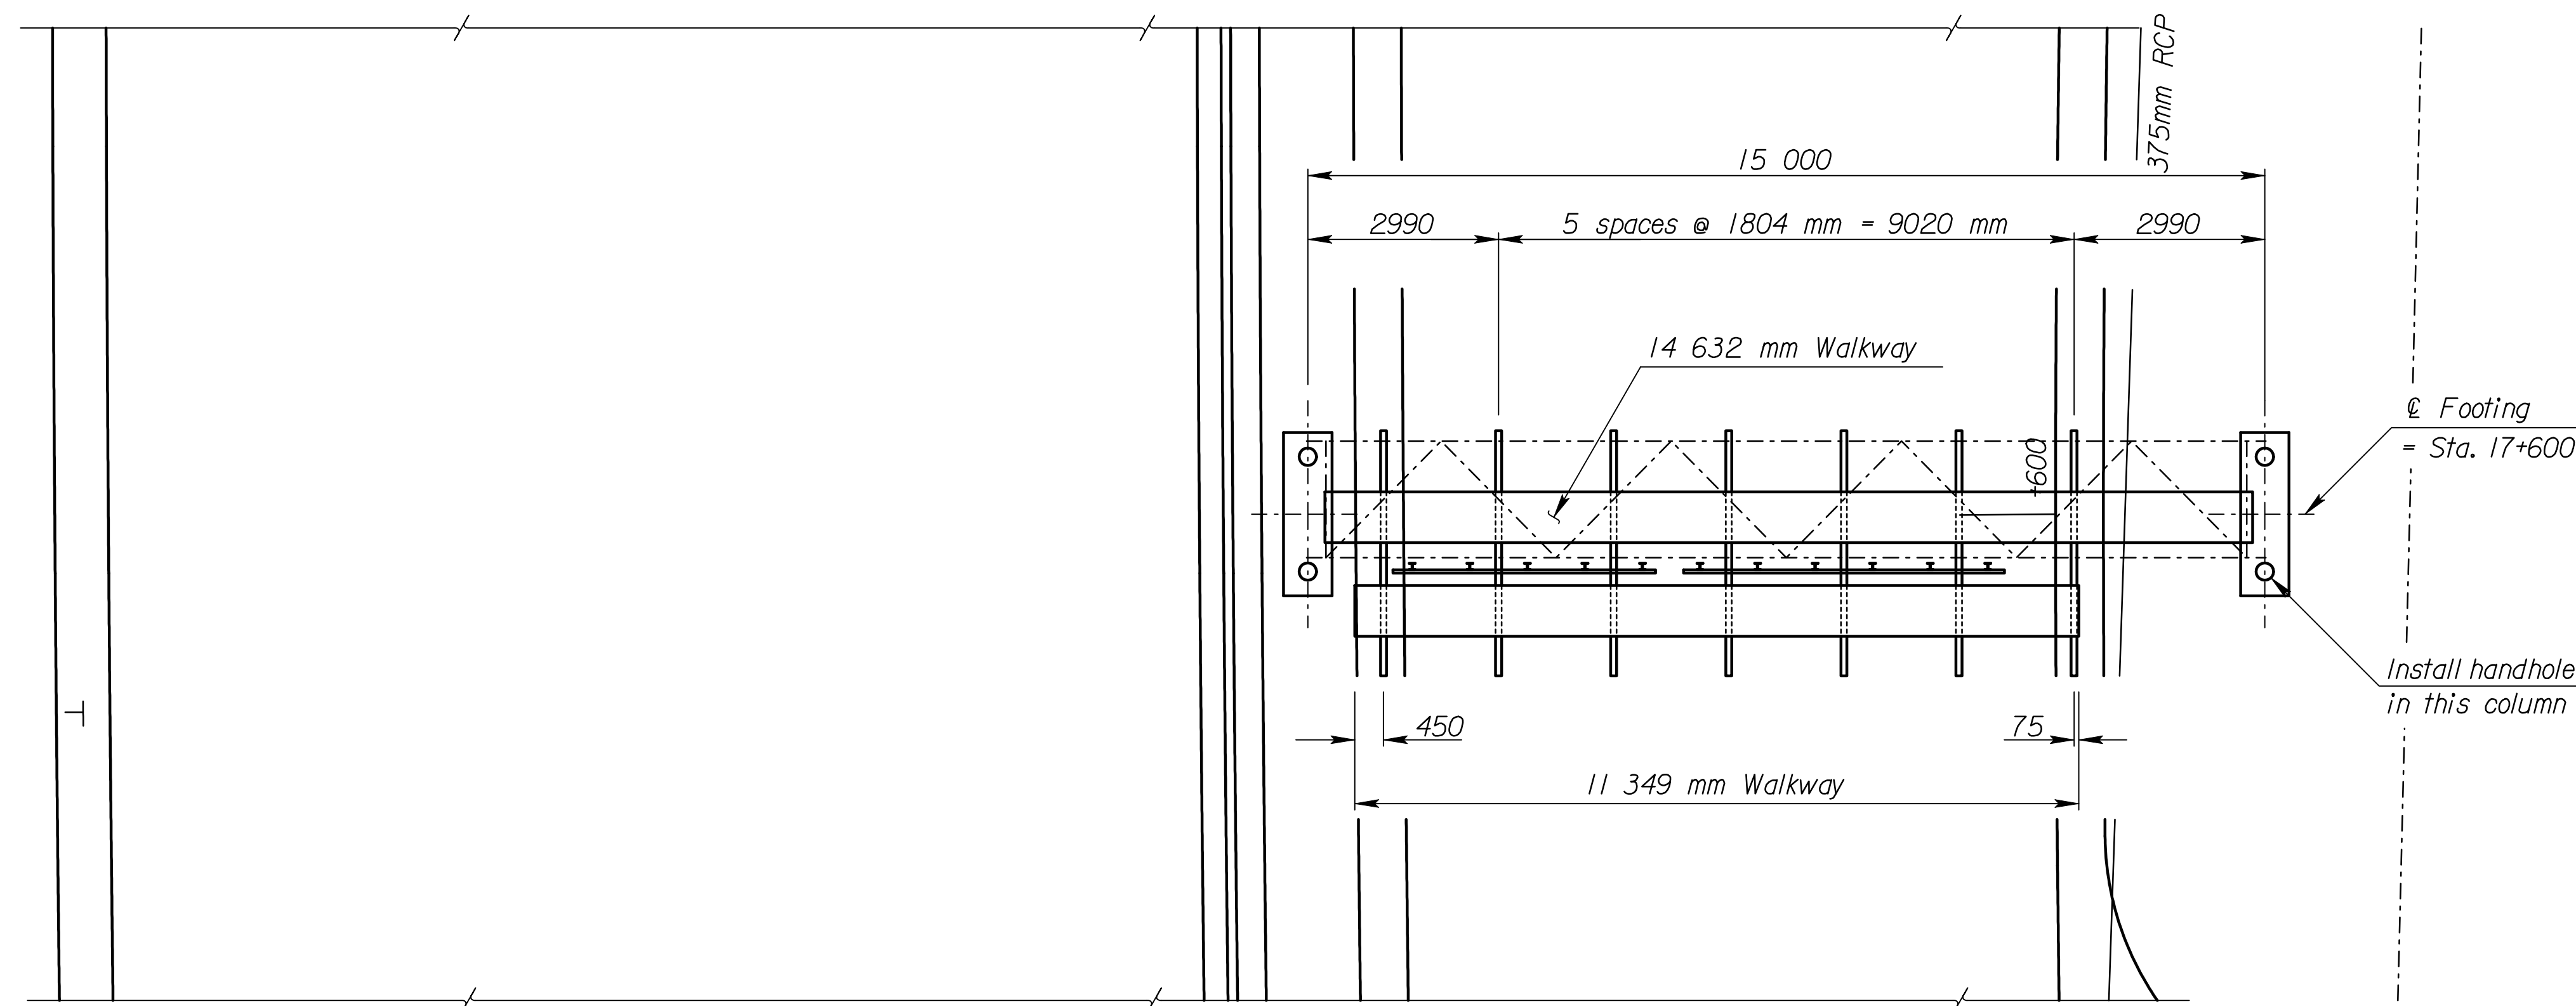

PLAN

ALUMINUM DETAILS				
TRUSS	Member 1 Wall Thickness		3.76	
	Member 2 Wall Thickness		3.05	
	N = 8	X = 284	S = 1804	Camber = 18
END SUPPORTS	Member 1 Wall Thickness		4.19	
	Member 2 Wall Thickness		3.05	
	Left	N = 3	S = 1565	L = 7115
	Right	N = 3	S = 1600	L = 7220
FOOTINGS	Left Type	B	Right Type	B

Scale 1:75

Scale = +/- 75.2  
I:/1997/97362/As-Builts/dgn/s/Vol 4/SH 760-KDOT STD-Sign-17600.dgn Last Rev: 10-3-07 Bjs gdr

RECORD DRAWING

3					
2					
1					
NO.	DATE	REVISIONS	BY	APP'D	
KANSAS DEPARTMENT OF TRANSPORTATION					
EB US-54 Fr. Rd. Rt. STATION 17+600					
SPAN TYPE OVERHEAD SIGN STRUCTURE					
CONSTRUCTION LAYOUT					
ALUMINUM ALTERNATE					
PROJ. NO. 54-87 K-6657-01			SEDGWICK CO.		
SHEET NO. 16 OF 44	SCALE	APP'D			
DESIGNED	SMB	DETAILED	SMB	QUANTITIES	CADD
DESIGN CK.	DETAIL CK.	QUAN. CK.	CADD CK.		