

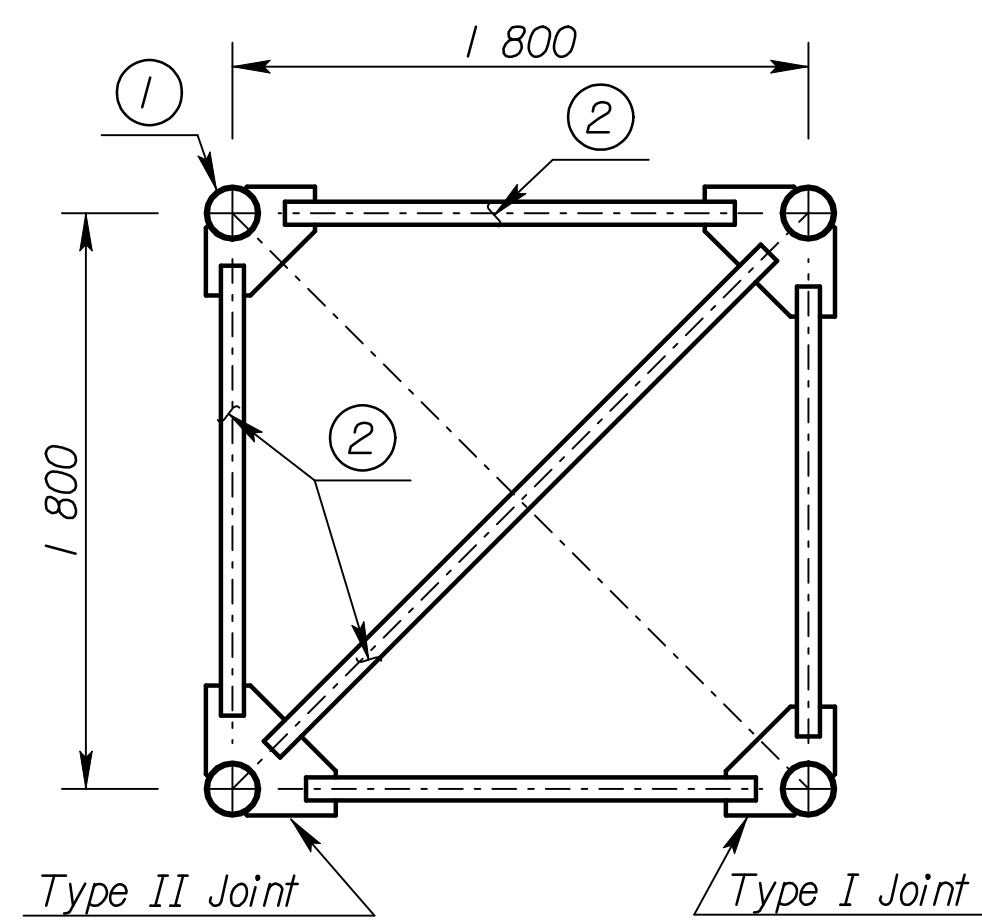
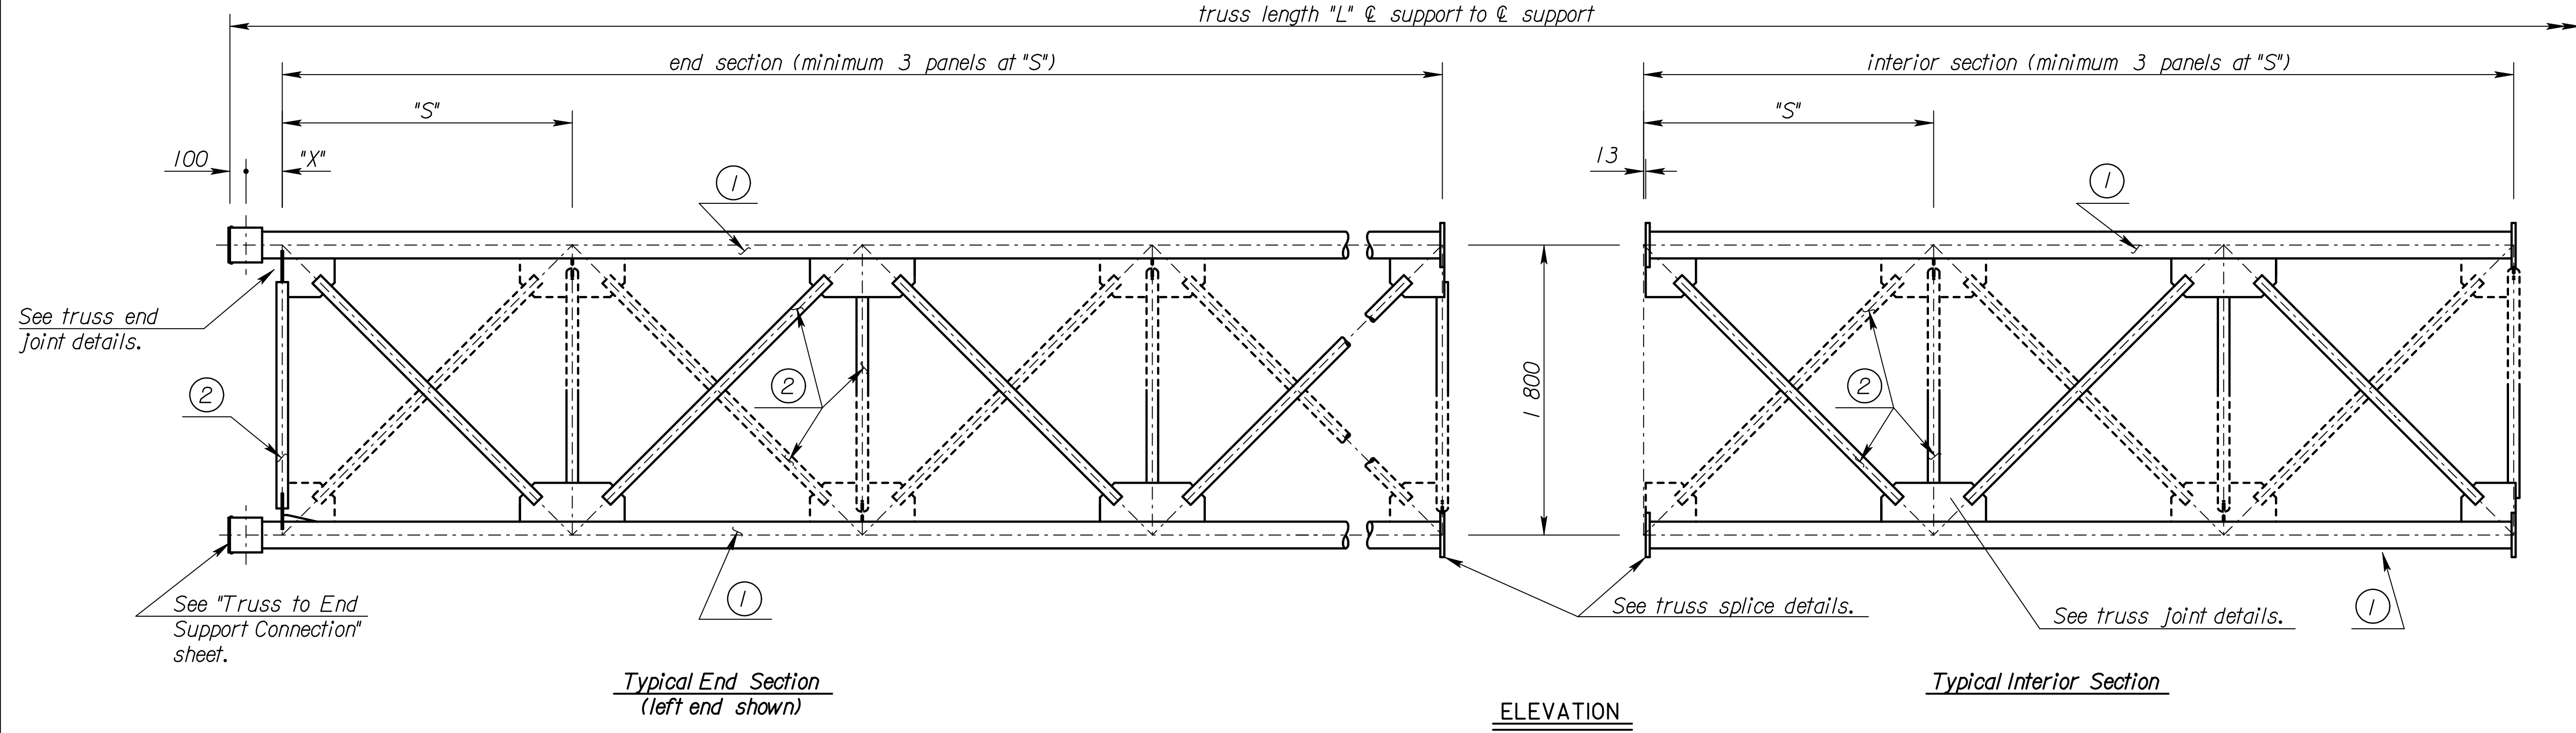



STATE	PROJECT NO.	YEAR	SHEET NO.	TOTAL SHEETS
KANSAS	54-87 K-6657-01	2002	780	1122

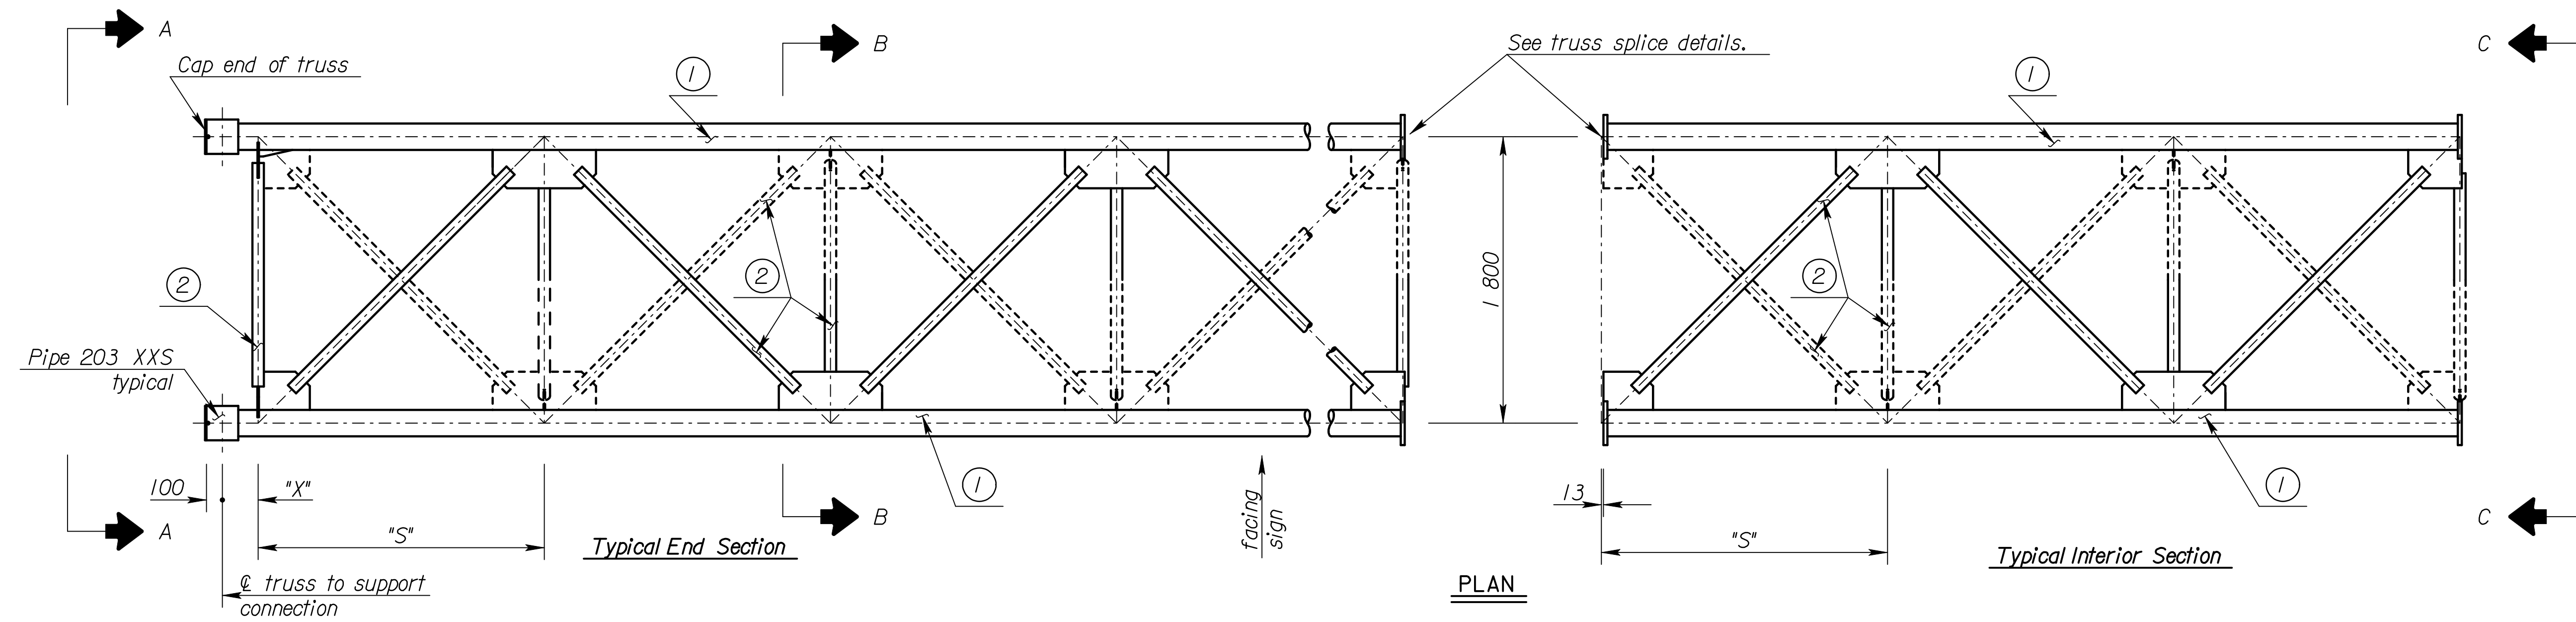

See truss end joint details.

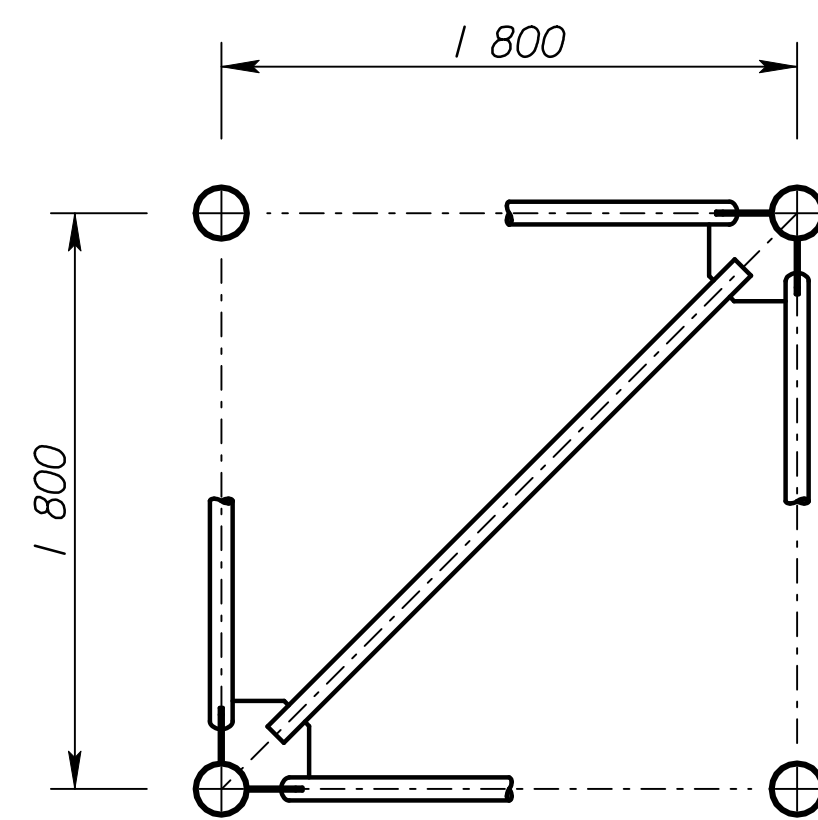

See truss joint details.

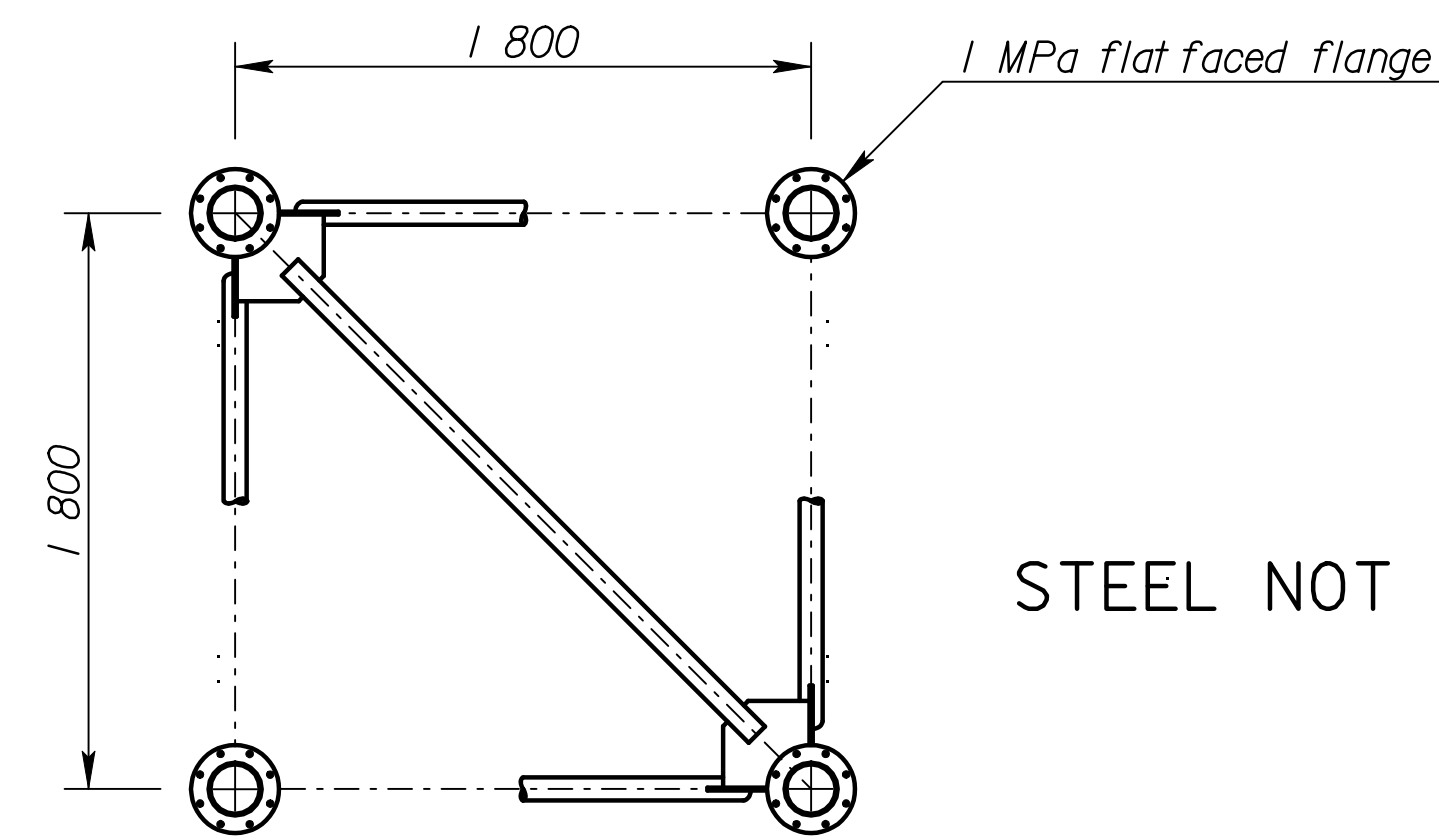

See truss splice details.

STEEL NOT USED

RECORD DRAWING

Note: Dashed lines used in plan and elevation views to distinguish bottom or rear portions of member ②.

Note: See "Construction Layout" for wall thickness, "N", "S", "L" and "X" dimensions.

Member ① is 168 mm O.D. pipe.

Member ② is 73 mm O.D. pipe.

NO.	DATE	REVISIONS	BY	APP'D
KANSAS DEPARTMENT OF TRANSPORTATION				
STANDARD STRUCTURAL SIGN SUPPORTS				
SPAN TYPE OVERHEAD				
STEEL ALTERNATE				
TRUSS FRAMING PLAN AND DETAILS				
SL151C-03 SI SEDGWICK CO.				
DESIGNED	DATE	4-10-97	APP'D	Kenneth F. Hurst
DESIGN CK.	RDH	DETAIL CK.	RDH	QUAN. CK.
			CADD	DJE
			CADD	LES

Scale = 1/8" = 1'-0"
12/1997/97362/As-Builts/dgn/s/Vol 4/SH 780-KDOT STD-Sign-15/csi.dgn Last Rev: 10-4-07 Bjs: gdr