

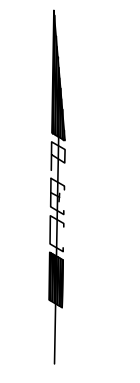


FHWA REGION NO.	STATE	PROJECT NO.	YEAR	SHEET NO.	TOTAL SHEETS
7	KANSAS	54-87 K-6657-01	2002	875	1122

DATE	
BY	
REFERENCES NOTED	
REFERENCES CHECKED	

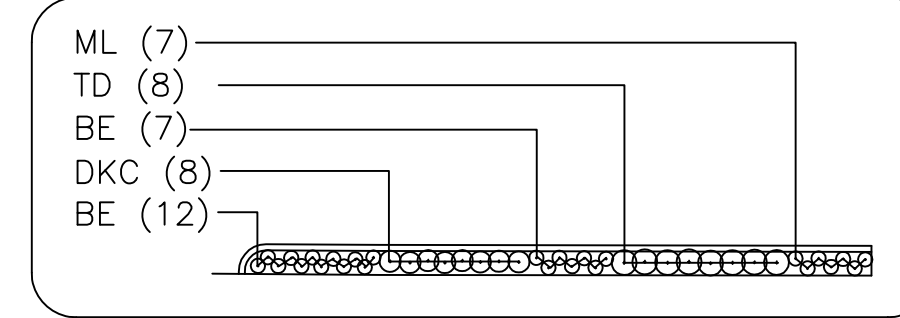

Bledsoe Enterprises, Inc.
D-589-UP

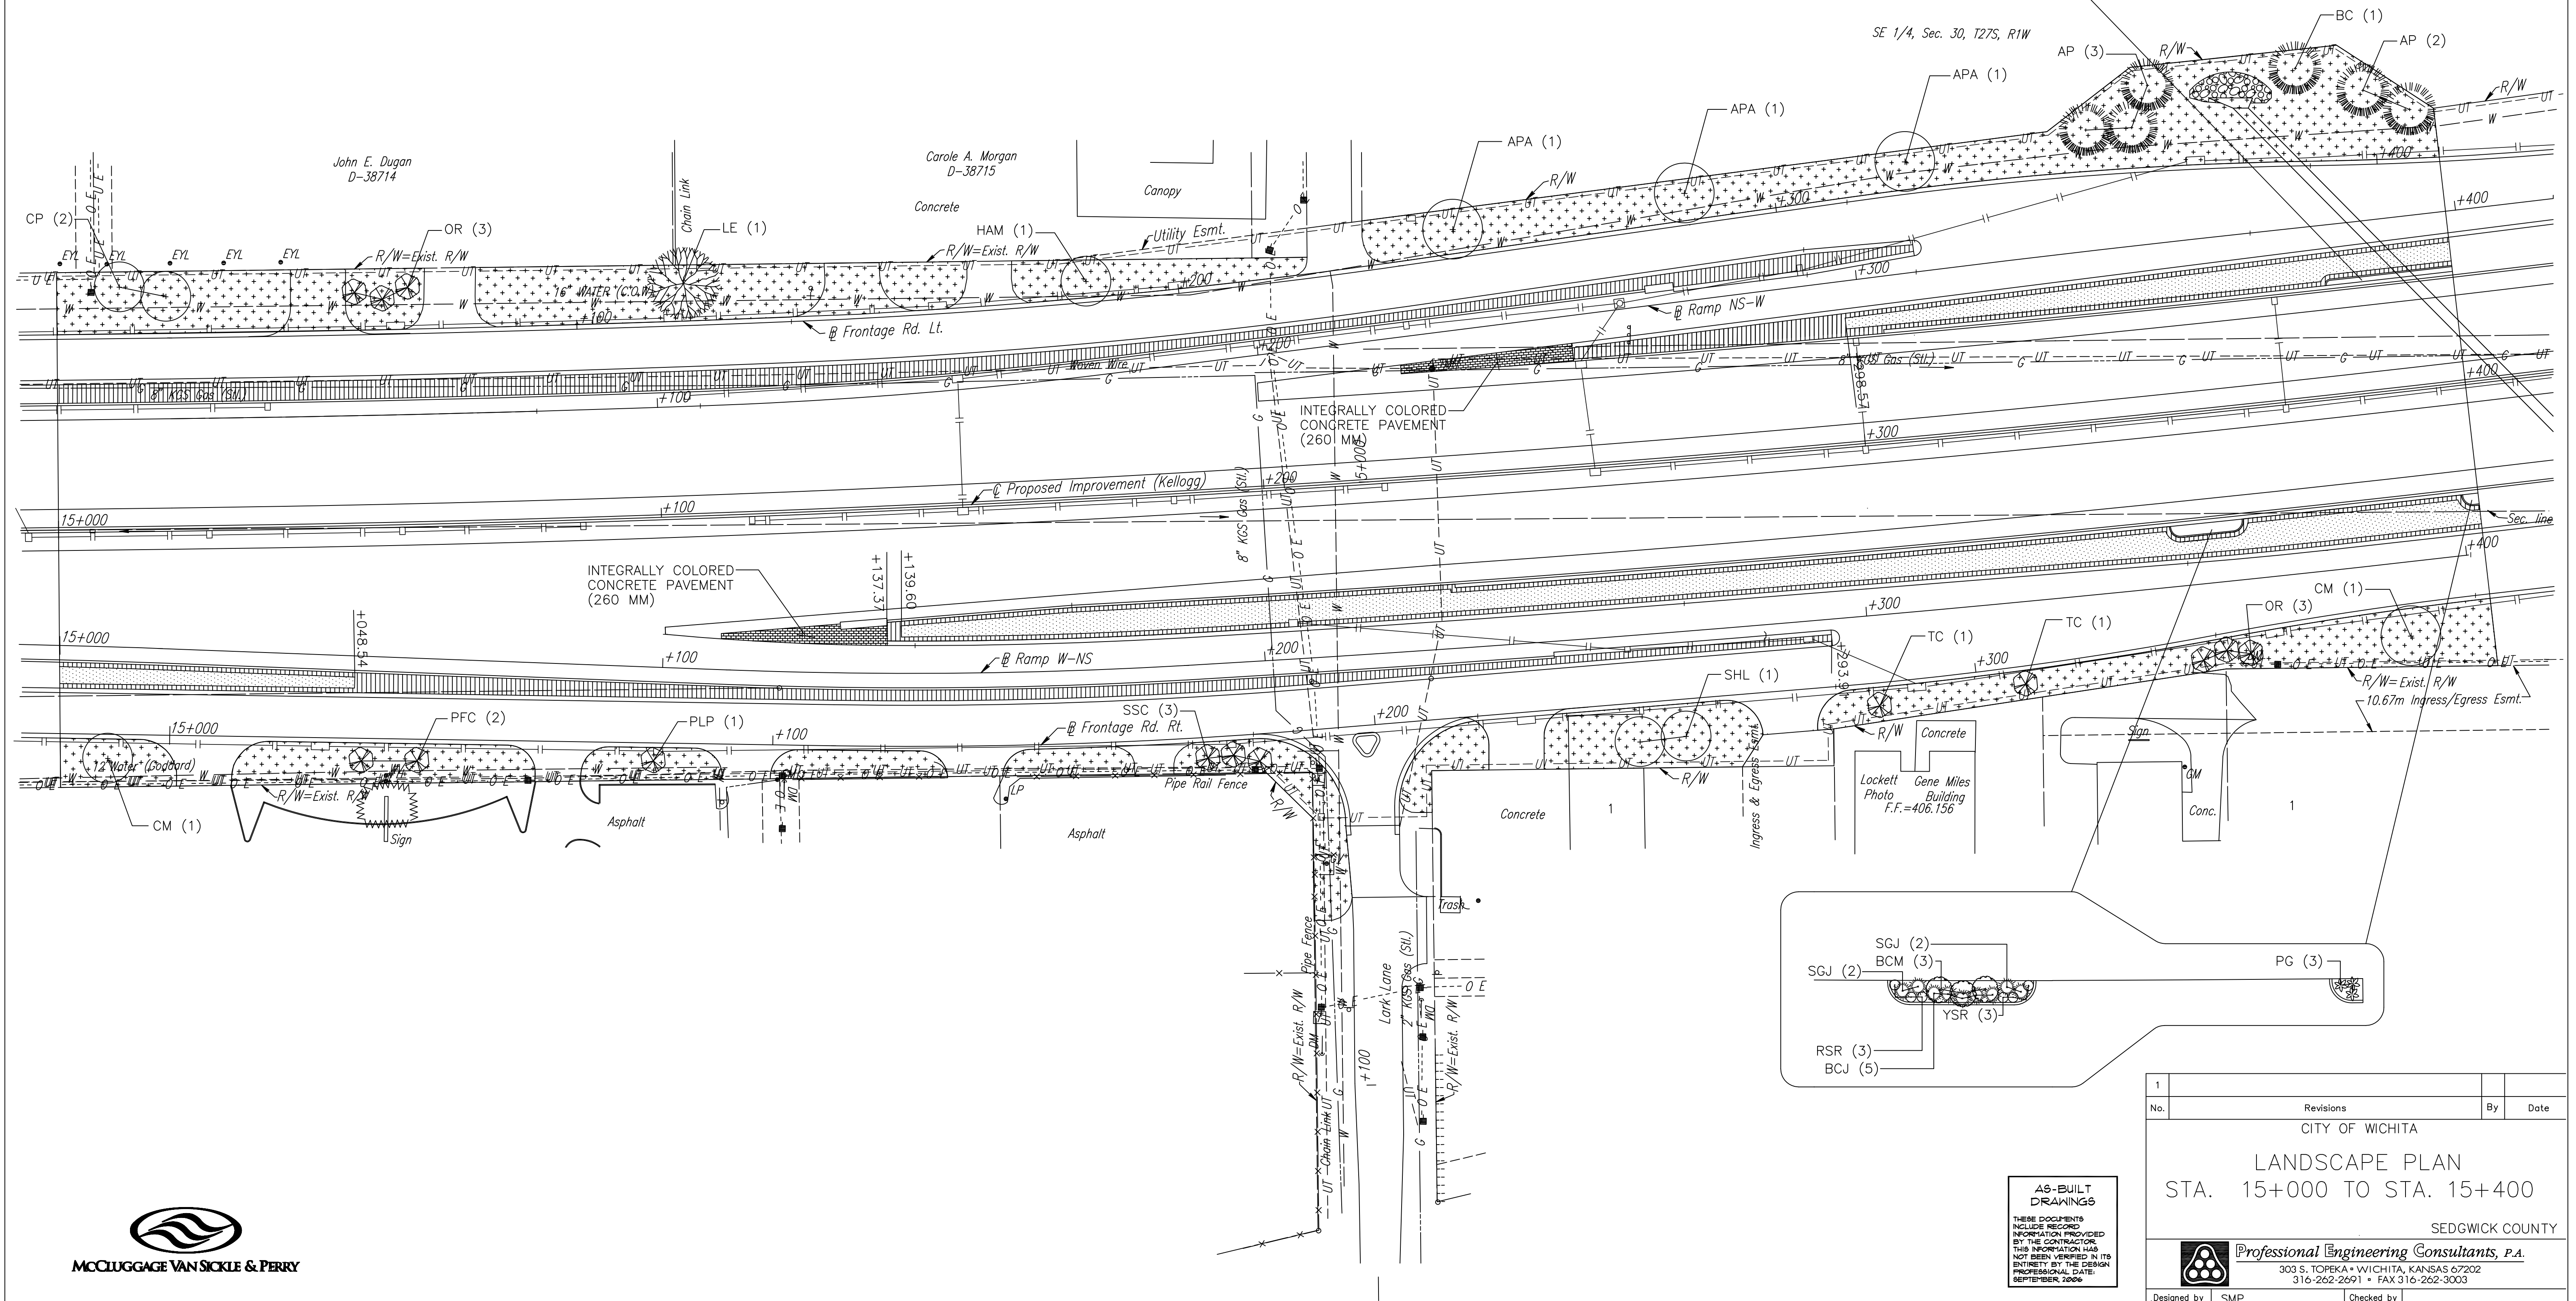

DSNR: OPER: DWR SCALE: 1:500
F: 9934/15150



AS-BUILT DRAWINGS
THESE DOCUMENTS INCLUDE RECORD INFORMATION PROVIDED BY THE CONTRACTOR. THIS INFORMATION HAS NOT BEEN VERIFIED IN ITS ENTIRETY BY THE DESIGN PROFESSIONAL. DATE: SEPTEMBER 2006

1		Revisions		By	Date
CITY OF WICHITA					
LANDSCAPE PLAN					
STA. 15+000 TO STA. 15+400					
SEDGWICK COUNTY					
Professional Engineering Consultants, P.A.					
303 S. TOPEKA • WICHITA, KANSAS 67202 316-262-2671 • FAX 316-262-3003					
Designed by	SMP	Checked by			
Drawn by	DWR	Date	April, 2002	Job No.	97362