


FHWA REGION NO.	STATE	PROJECT NO.	YEAR	SHEET NO.	TOTAL SHEETS
7	KANSAS	54-87 K-6657-01	2002	876	1122

DATE	
BY	
REFERENCES NOTED	
REFERENCES CHECKED	



DSNR: F:79934/15154
 OPER: DWR
 SCALE: 1:500

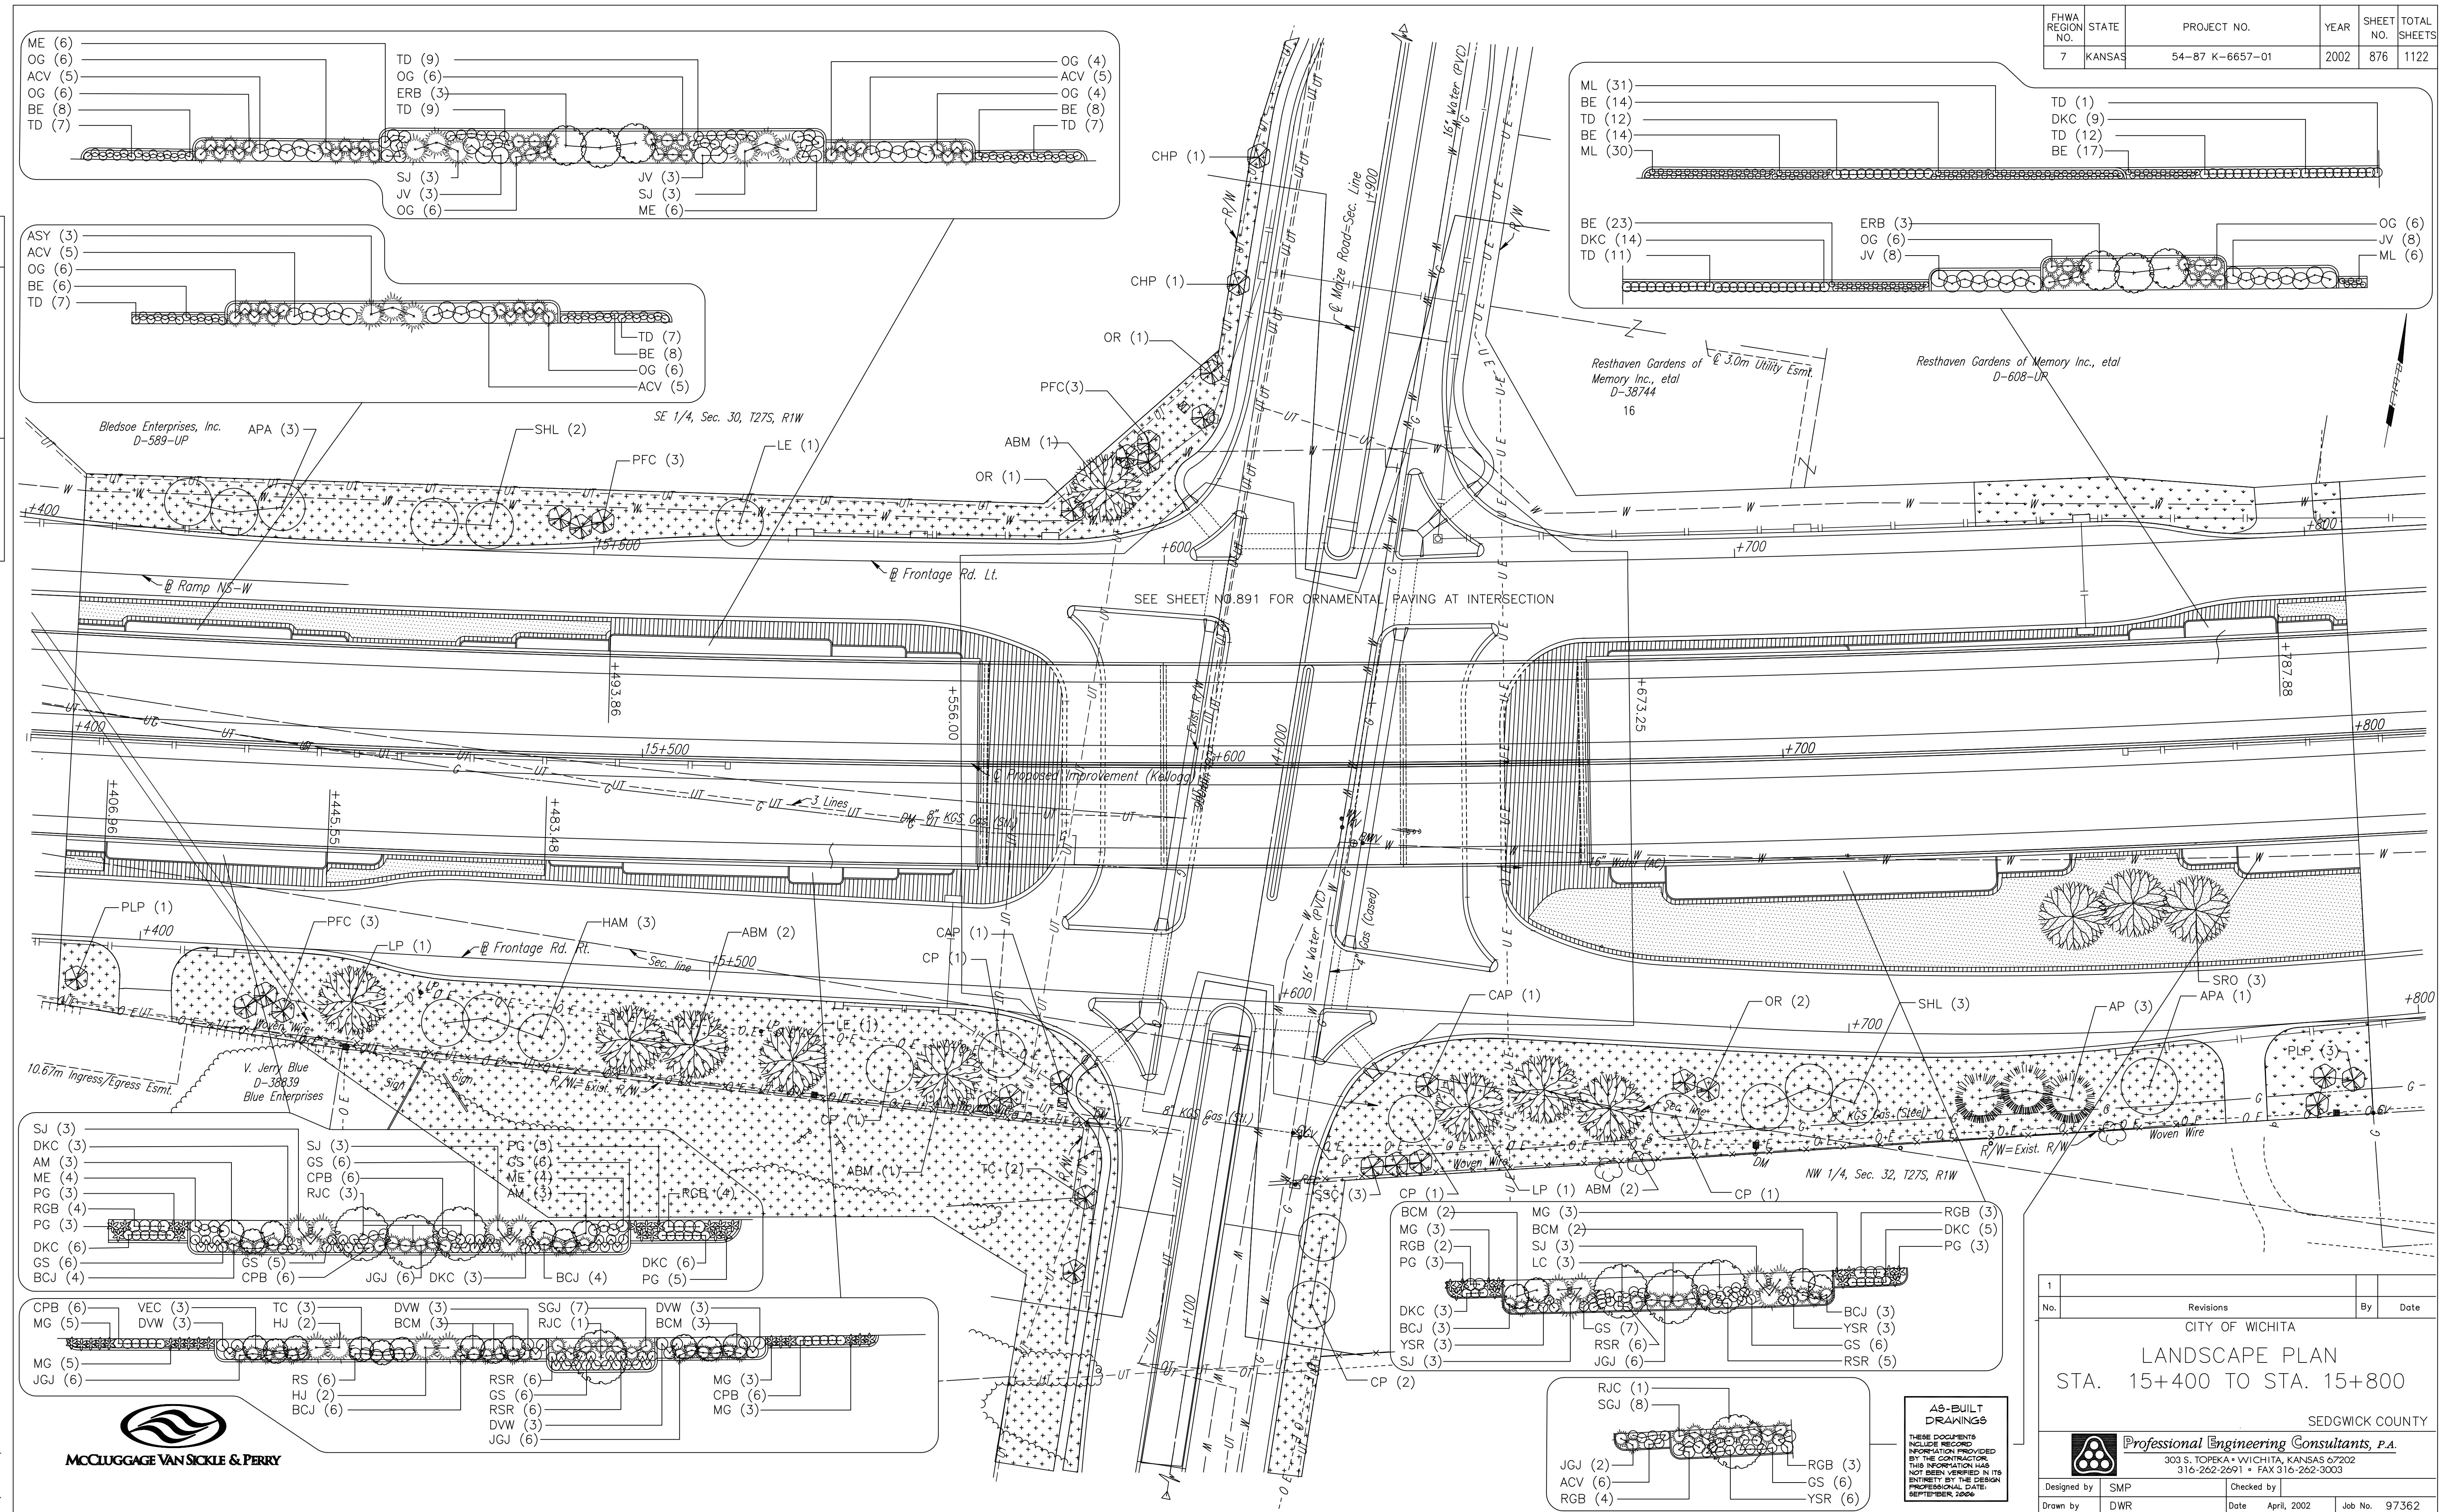

1		Revisions		By		Date	
CITY OF WICHITA							
LANDSCAPE PLAN							
STA. 15+400 TO STA. 15+800							
SEDGWICK COUNTY							
Professional Engineering Consultants, P.A.							
303 S. TOPEKA • WICHITA, KANSAS 67202 316-262-2691 • FAX 316-262-3003							
Designed by	SMP	Checked by		Date	April, 2002	Job No.	97362
Drawn by	DWR	Date	April, 2002	Job No.	97362		

AS-BUILT DRAWINGS
 THESE DOCUMENTS INCLUDE RECORD INFORMATION PROVIDED BY THE CONTRACTOR. THIS INFORMATION HAS NOT BEEN VERIFIED BY THE DESIGN PROFESSIONAL. DATE: SEPTEMBER 2006