

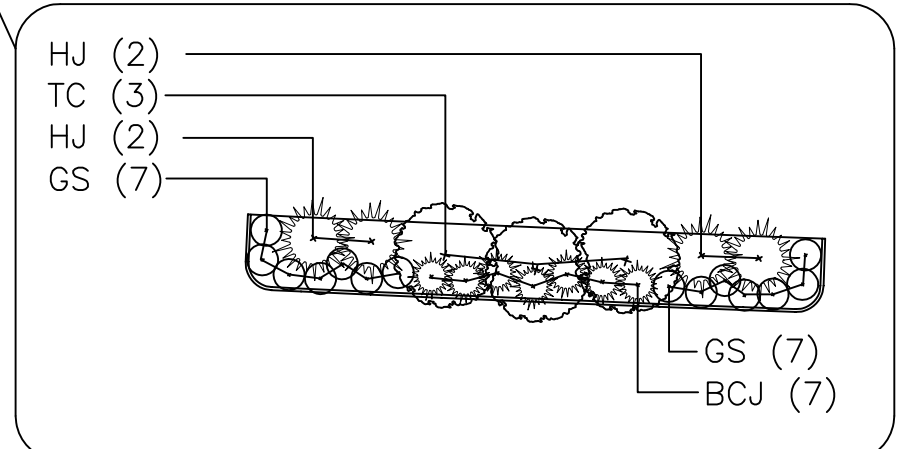
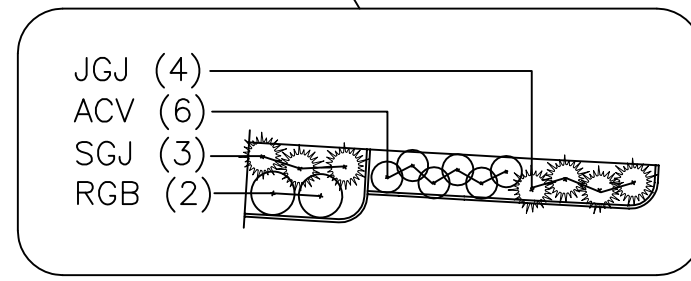


FHWA REGION NO.	STATE	PROJECT NO.	YEAR	SHEET NO.	TOTAL SHEETS
7	KANSAS	54-87 K-6657-01	2002	877	1122

DATE	
BY	
REFERENCES NOTED	
REFERENCES CHECKED	

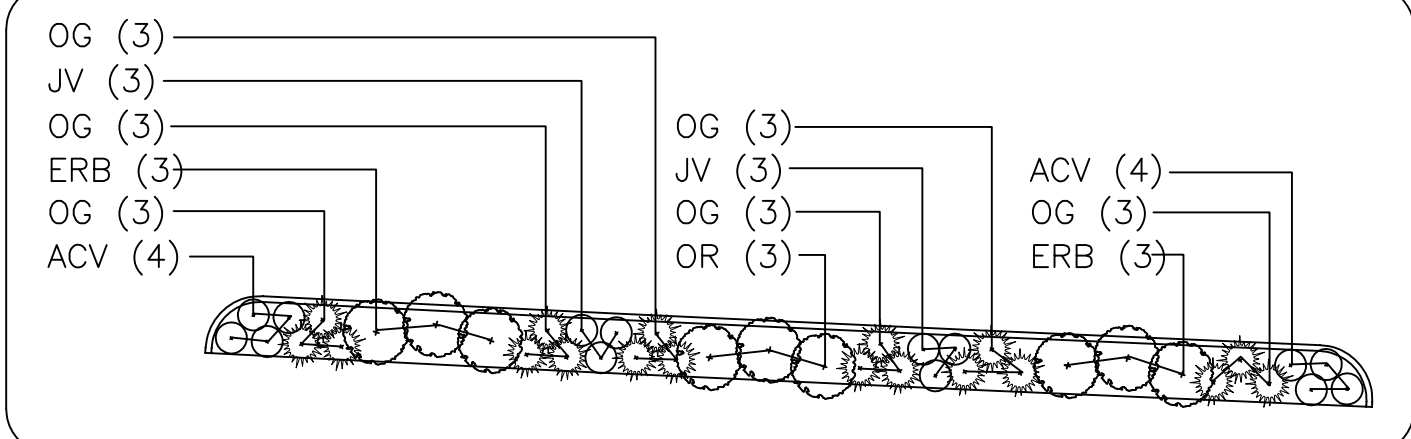

DSNR: F/9934/15158
 OPER: DWR
 SCALE: 1:500

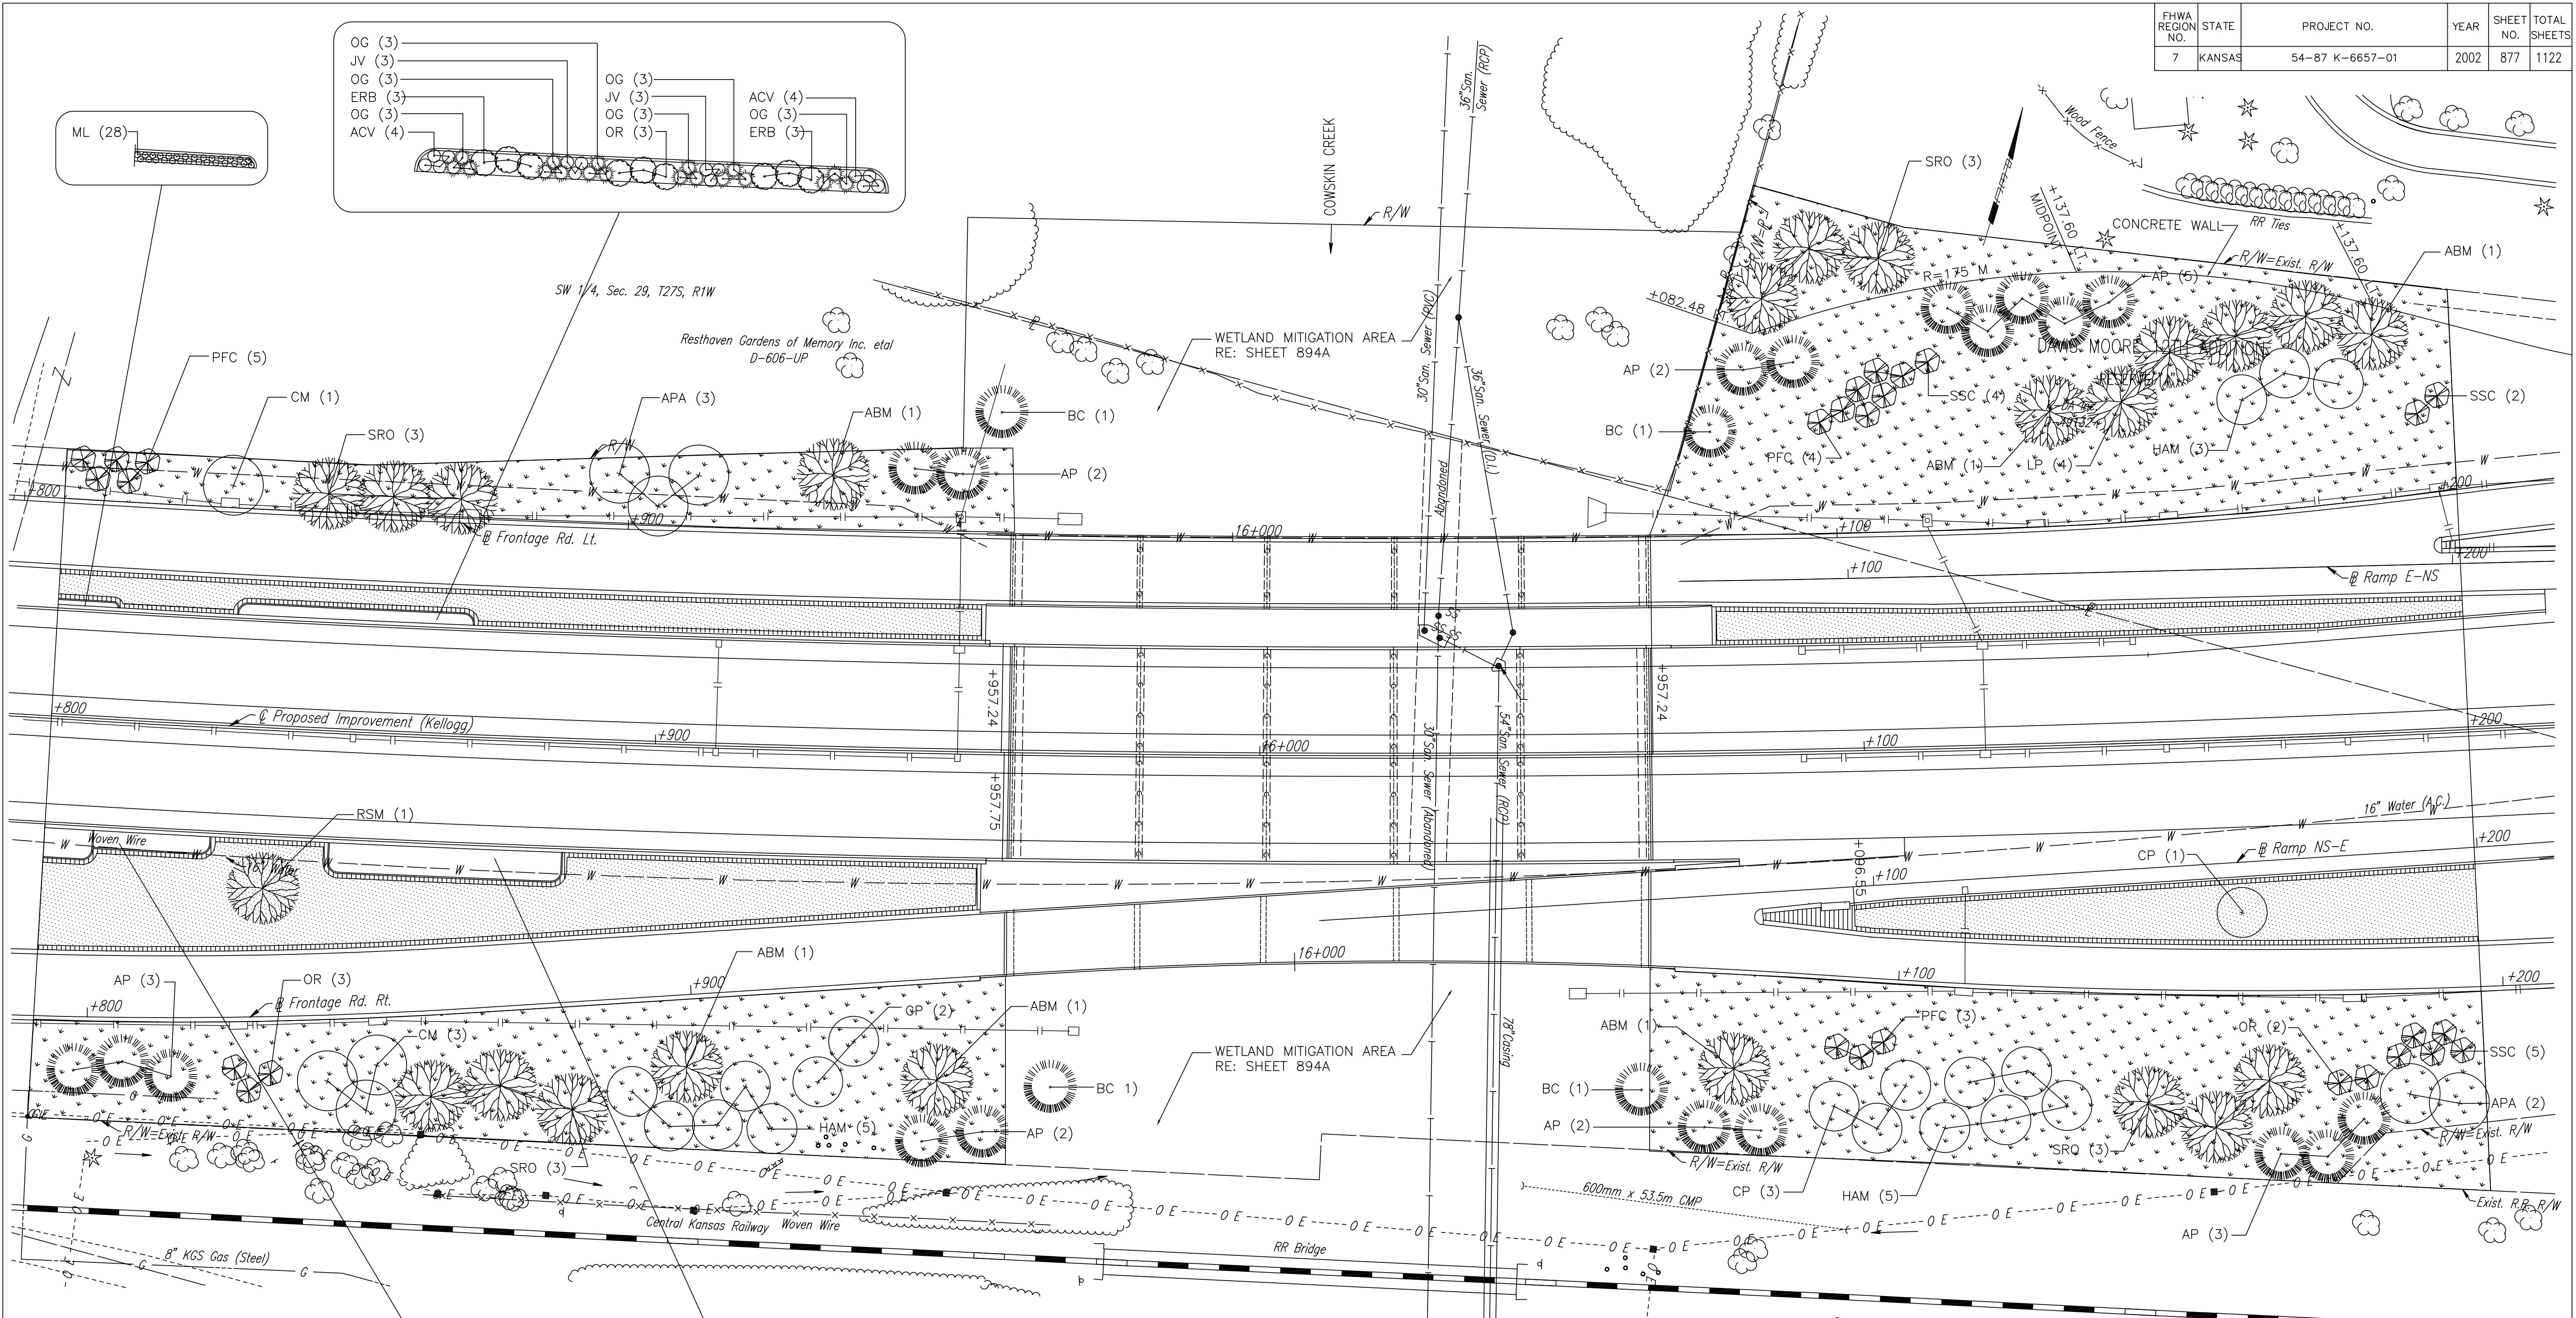

AS-BUILT DRAWINGS
 THESE DOCUMENTS INCLUDE REQUIRED INFORMATION PROVIDED BY THE CONTRACTOR. THIS INFORMATION HAS NOT BEEN VERIFIED IN ITS ENTIRETY BY THE DESIGN PROFESSIONAL DATE: SEPTEMBER, 2006.

1			
No.	Revisions	By	Date
CITY OF WICHITA			
LANDSCAPE PLAN			
STA. 15+800 TO STA. 16+200			
SEDGWICK COUNTY			
Professional Engineering Consultants, P.A.			
303 S. TOPEKA • WICHITA, KANSAS 67202 316-262-2691 • FAX 316-262-3003			
Designed by	SMP	Checked by	
Drawn by	DWR	Date	April, 2002
		Job No.	97362