


FHWA REGION NO.	STATE	PROJECT NO.	YEAR	SHEET NO.	TOTAL SHEETS
7	KANSAS	54-87 K-6657-01	2002	878	1122

DATE	
BY	
REFERENCES NOTED	
REFERENCES CHECKED	



DSWR: F./9934/162  
 OPER: DWR  
 SCALE: 1:500

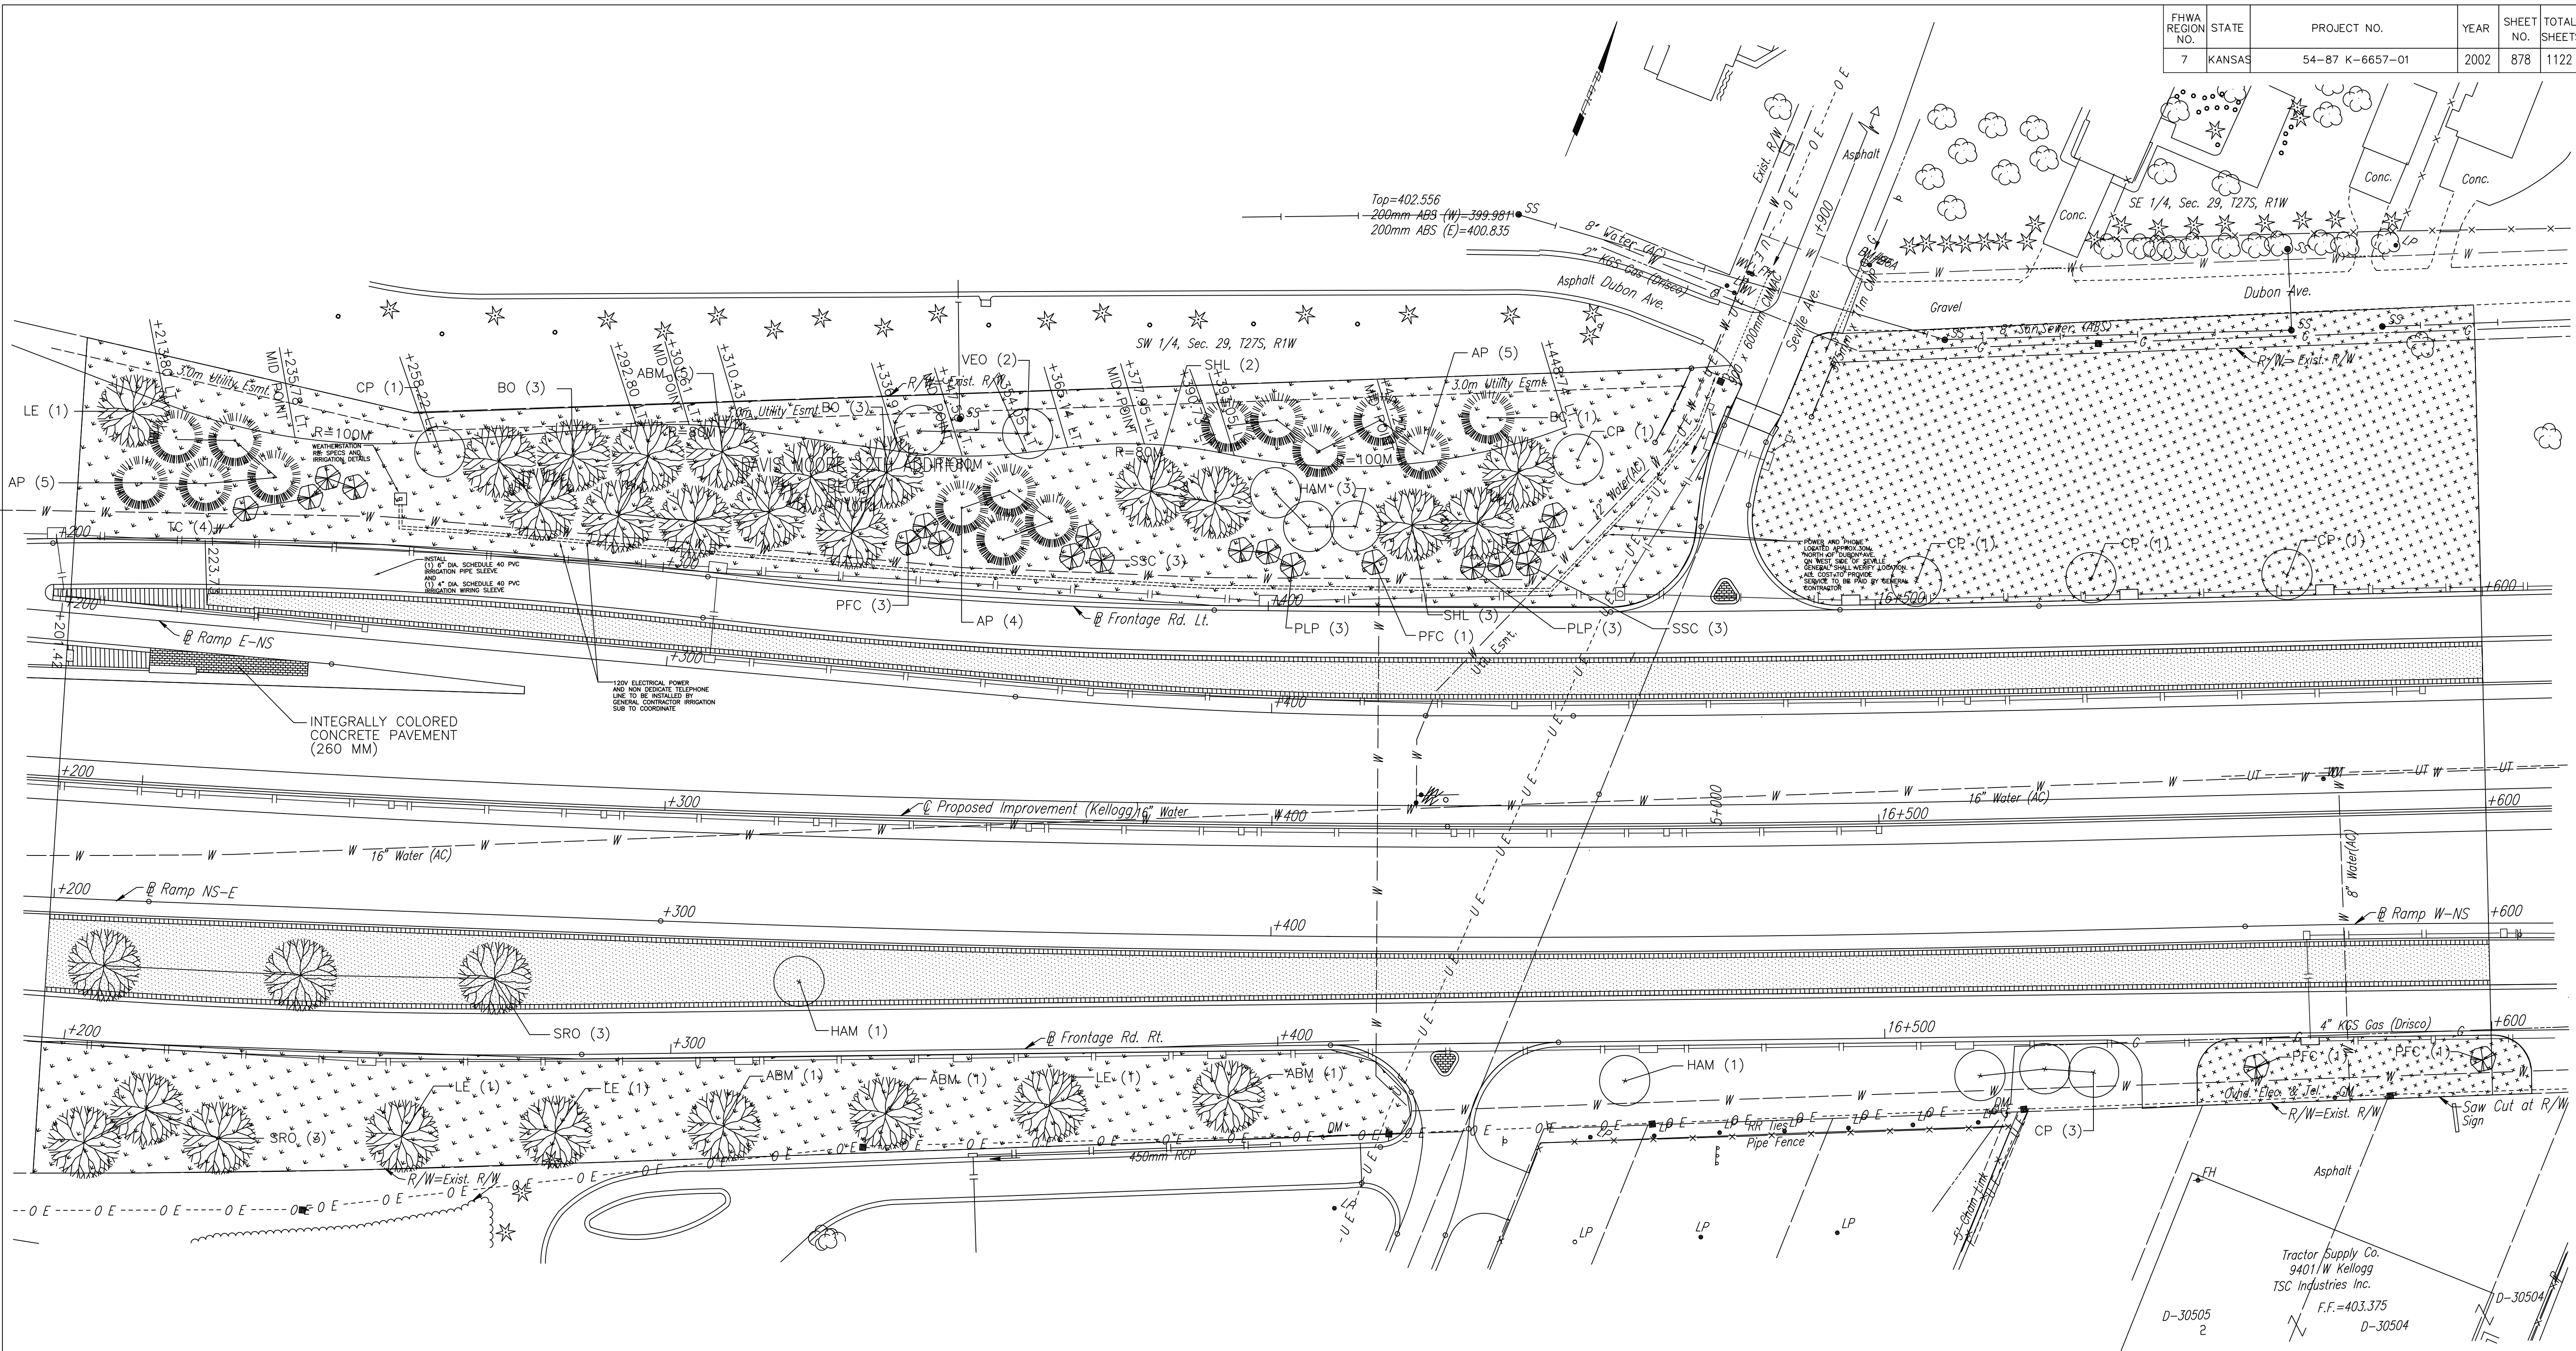

AS-BUILT DRAWINGS  
 THESE DOCUMENTS INCLUDE RECORD INFORMATION PROVIDED BY THE CONTRACTOR. THIS INFORMATION HAS NOT BEEN VERIFIED IN ITS ENTIRETY BY THE DESIGN PROFESSIONAL. DATE: SEPTEMBER 2006

No.	Revisions	By	Date
1			

CITY OF WICHITA  
 LANDSCAPE PLAN  
 STA. 16+200 TO STA. 16+600  
 SEDGWICK COUNTY

Professional Engineering Consultants, P.A.  
 303 S. TOPEKA • WICHITA, KANSAS 67202  
 316-262-2691 • FAX 316-262-3003

Designed by	SMP	Checked by	
Drawn by	DWR	Date	April, 2002
		Job No.	97362