


FHWA REGION NO.	STATE	PROJECT NO.	YEAR	SHEET NO.	TOTAL SHEETS
7	KANSAS	54-87 K-6657-01	2002	879	1122

DATE	
BY	
REFERENCES NOTED	
REFERENCES CHECKED	



DSNR: OPER. DMR SCALE: 1:500  
 F: 9934/15166

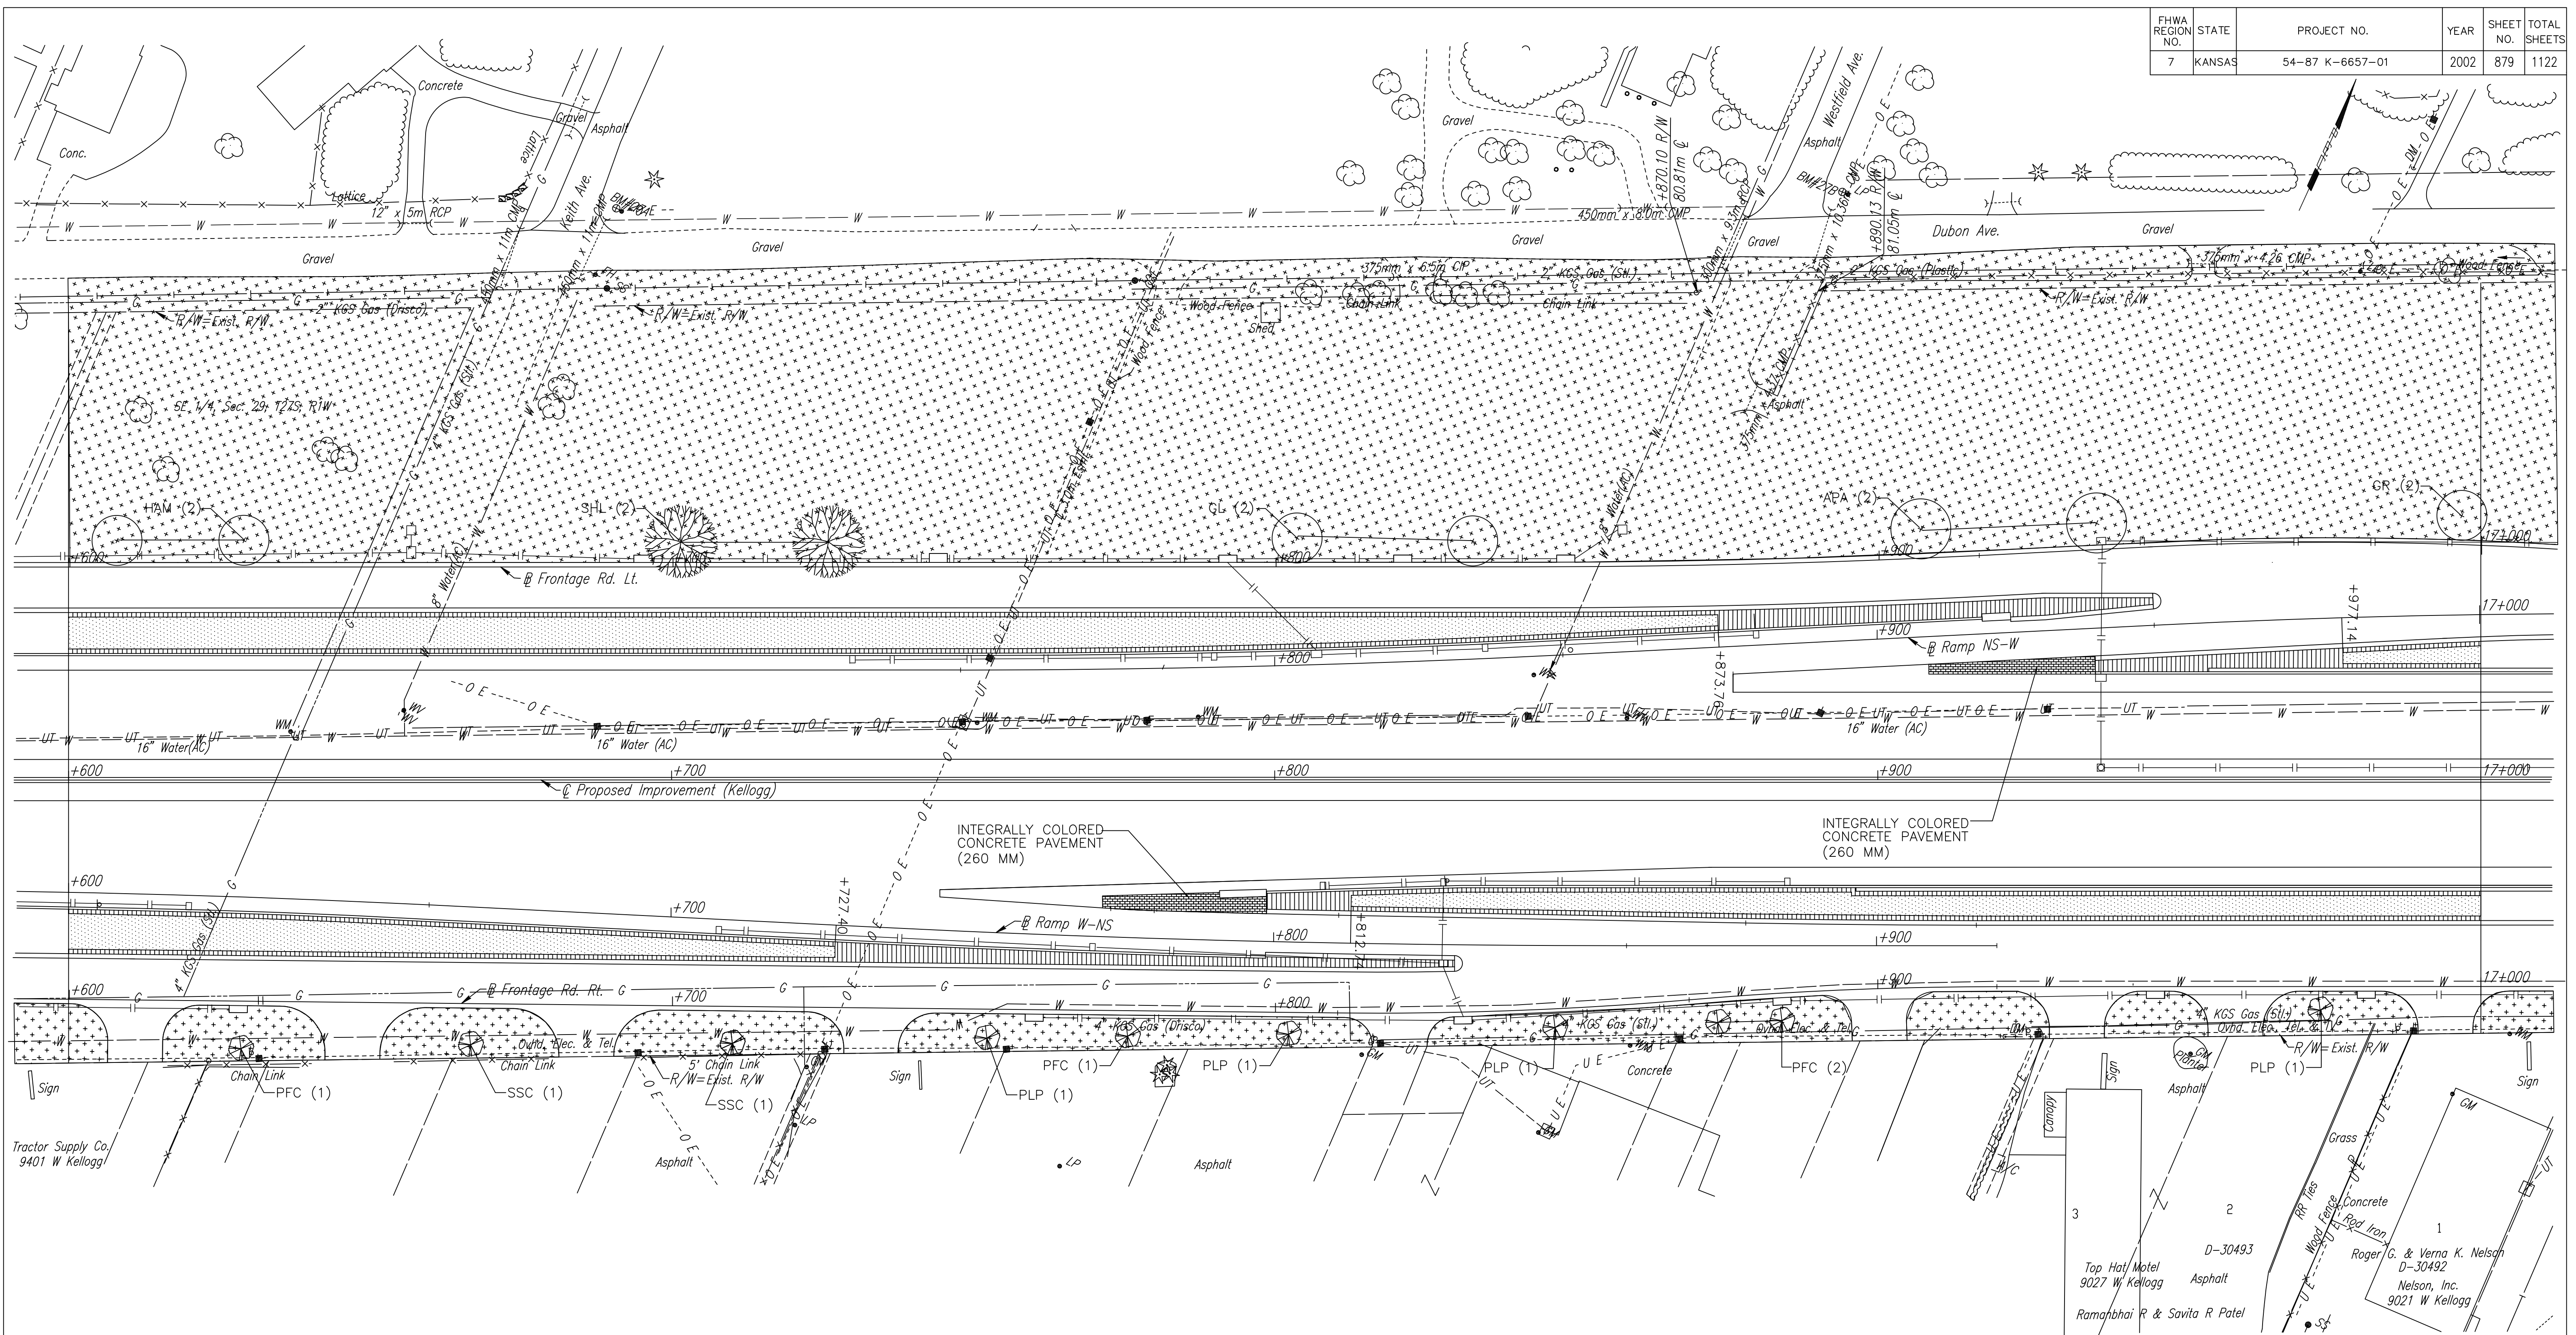

- K-31 FESCUE SEED
- BUFFALO/BLUE GRAMA SEED
- BUFFALO SEED

**AS-BUILT DRAWINGS**  
 THESE DOCUMENTS INCLUDE RECORD INFORMATION PROVIDED BY THE CONTRACTOR. THIS INFORMATION HAS NOT BEEN VERIFIED IN ITS ENTIRETY BY THE DESIGN PROFESSIONAL DATE: SEPTEMBER 2006.

No.	Revisions	By	Date
1			

CITY OF WICHITA  
**LANDSCAPE PLAN**  
 STA. 16+600 TO STA. 17+000  
 SEDGWICK COUNTY

**Professional Engineering Consultants, P.A.**  
 303 S. TOPEKA • WICHITA, KANSAS 67202  
 316-262-2691 • FAX 316-262-3003

Designed by	SMP	Checked by	
Drawn by	DWR	Date	April, 2002
		Job No.	97362