


FHWA REGION NO.	STATE	PROJECT NO.	YEAR	SHEET NO.	TOTAL SHEETS
7	KANSAS	54-87 K-6657-01	2002	881	1122

DATE	
BY	
REFERENCES NOTED	
REFERENCES CHECKED	

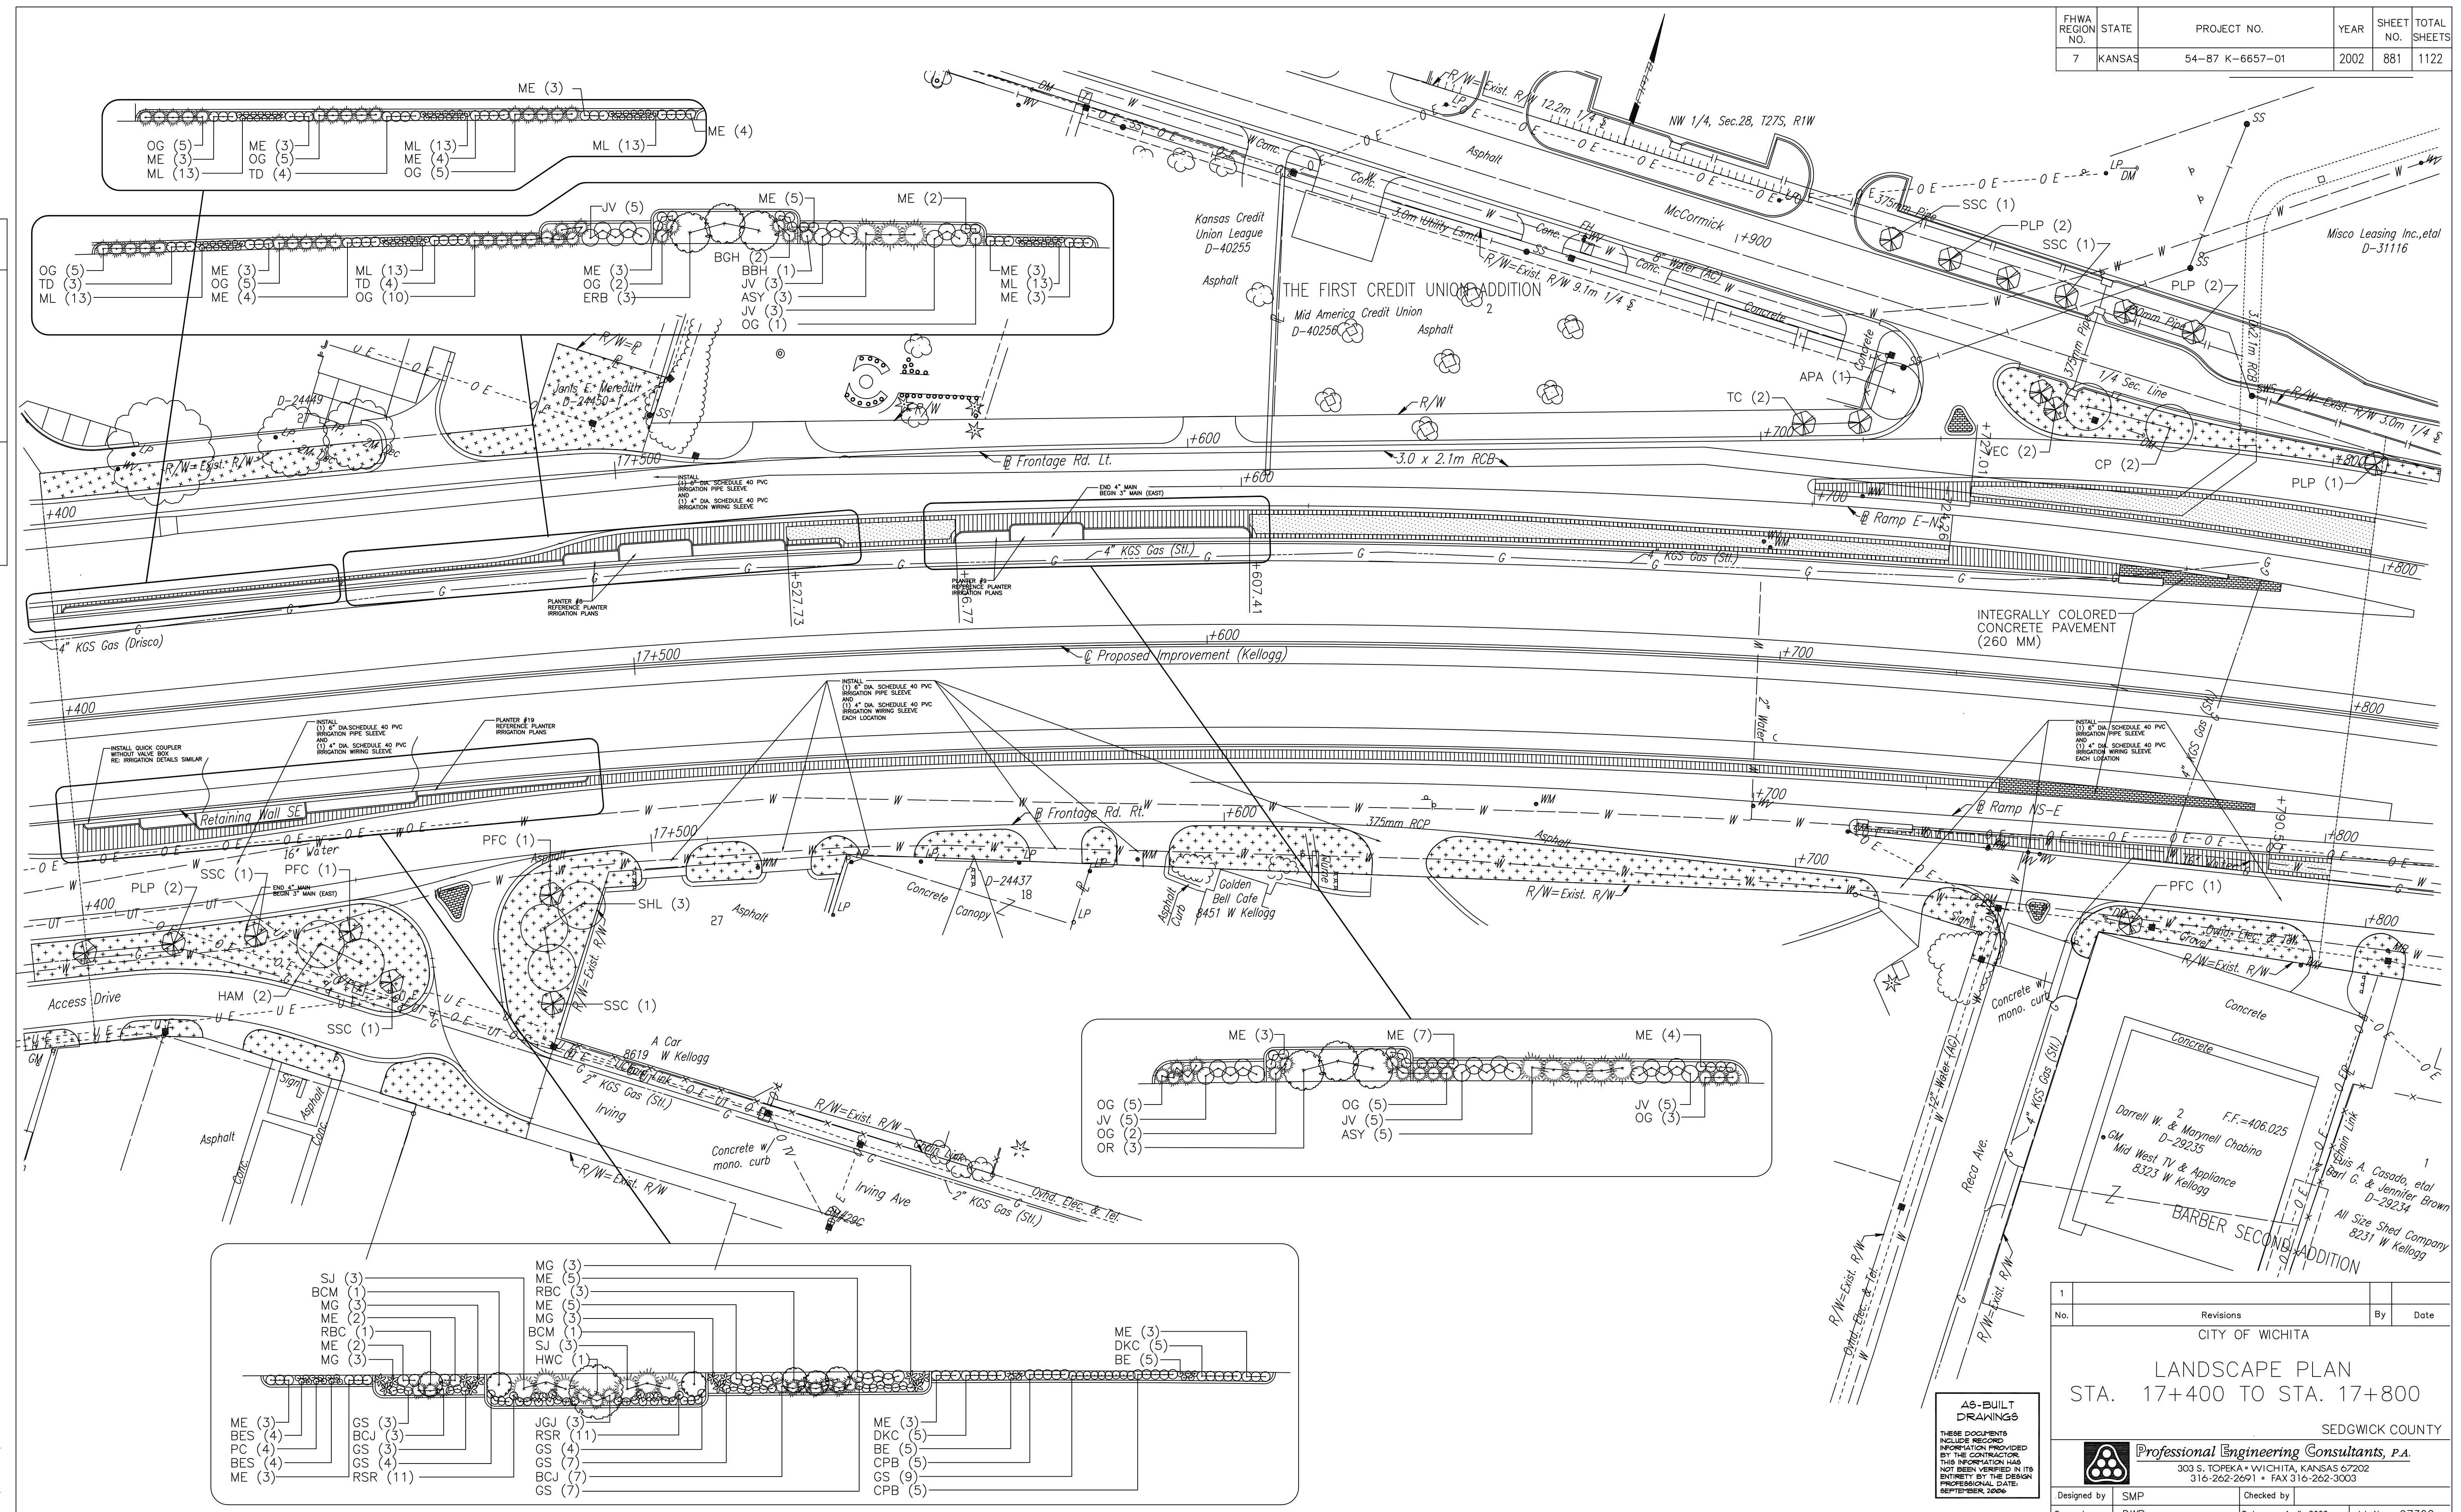

DSNR: OPER: DWR SCALE: 1:500
 F: 9934/1S174

No.	Revisions	By	Date
1			

CITY OF WICHITA
 LANDSCAPE PLAN
 STA. 17+400 TO STA. 17+800
 SEDGWICK COUNTY

Professional Engineering Consultants, P.A.
 303 S. TOPEKA • WICHITA, KANSAS 67202
 316-262-2691 • FAX 316-262-3003
 Designed by SMP Checked by
 Drawn by DWR Date April, 2002 Job No. 97362

AS-BUILT DRAWINGS
 THESE DOCUMENTS INCLUDE RECORD INFORMATION PROVIDED BY THE CONTRACTOR. THIS INFORMATION HAS NOT BEEN VERIFIED IN ITS ENTIRETY BY THE DESIGN PROFESSIONAL. DATE: SEPTEMBER 2006