


FHWA REGION NO.	STATE	PROJECT NO.	YEAR	SHEET NO.	TOTAL SHEETS
7	KANSAS	54-87 K-6657-01	2002	884	1122

DATE	
BY	
REFERENCES NOTED	
REFERENCES CHECKED	

Scale: 1:500

SW 1/4, Sec. 29, T27S, R1W

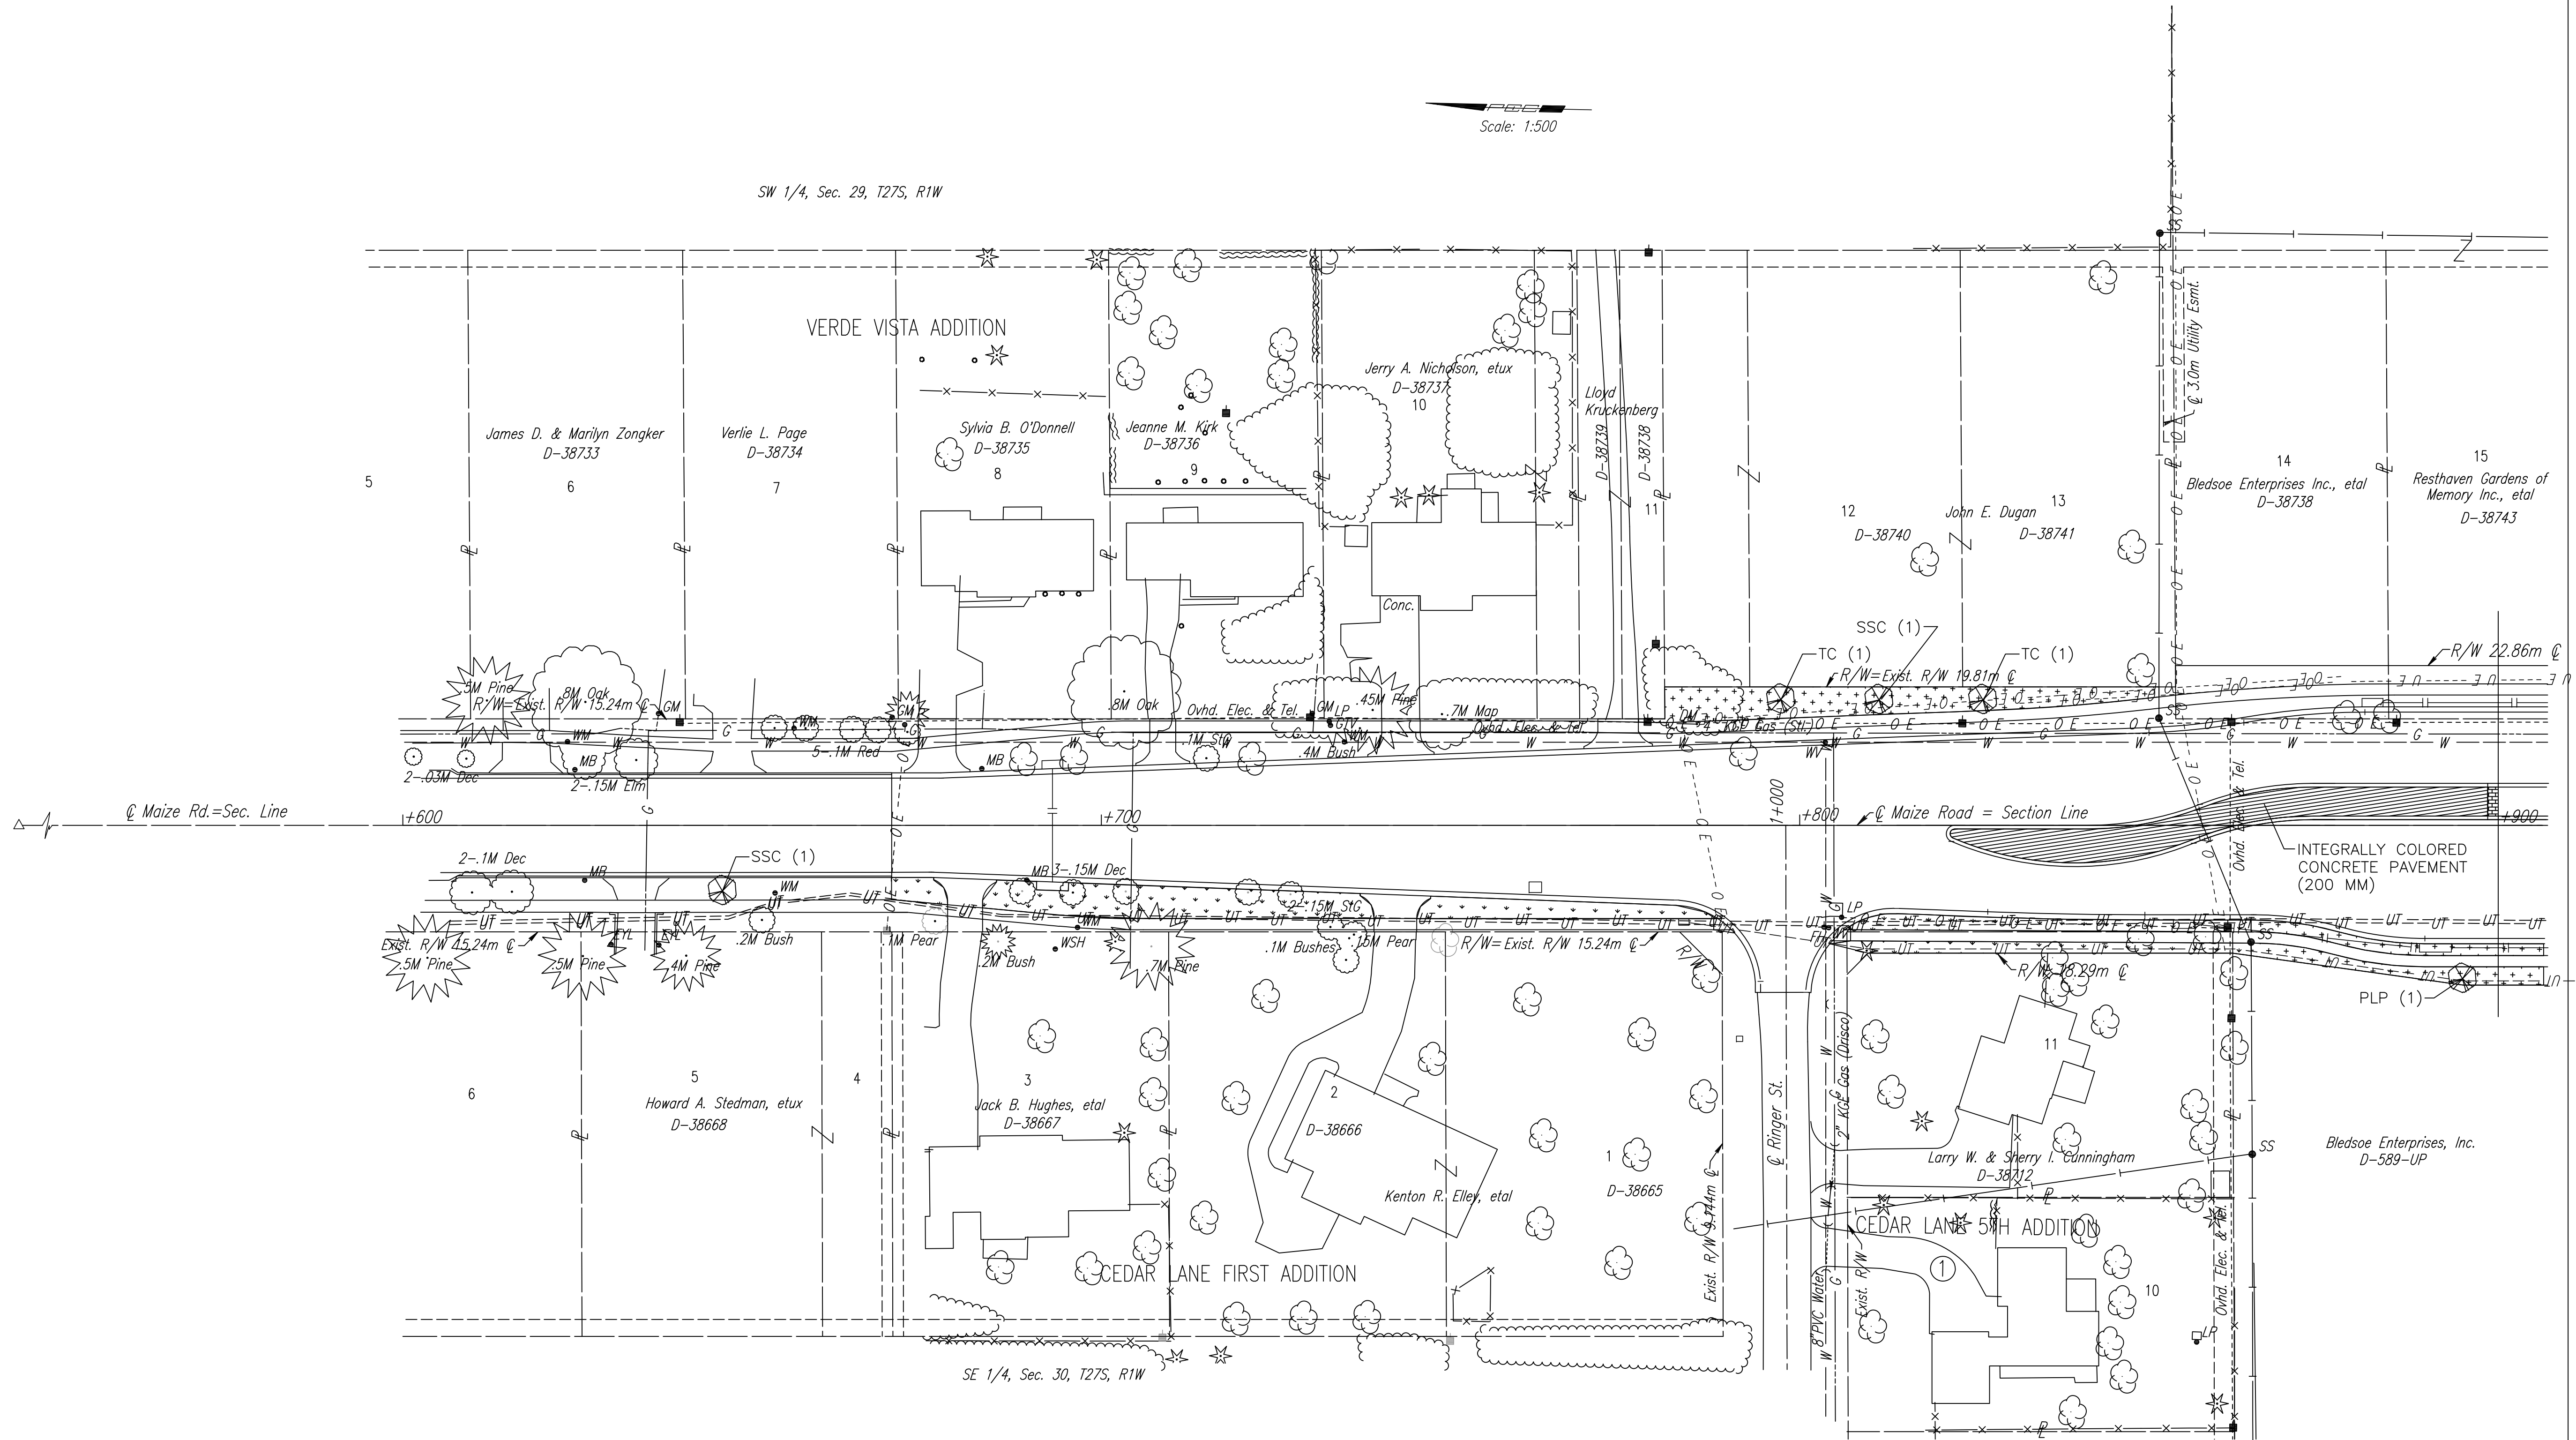

DSNR: WDH OPER: DMR SCALE: 1:500
F:/9934/MZLS3670

UTILITIES
 Power - K G E
 Telephone - Southwestern Bell
 Gas - Kansas Gas Service
 Cable TV - Cox Communications
 Water - City of Wichita Water Dept.
 San. Sewer - City of Wichita Sewer Dept.

AS-BUILT DRAWINGS
 THESE DOCUMENTS INCLUDE REVISION INFORMATION PROVIDED BY THE CONTRACTOR. THIS INFORMATION HAS NOT BEEN VERIFIED IN ITS ENTIRETY BY THE DESIGN PROFESSIONAL DATE: SEPTEMBER 2006

1			
No.	Revisions	By	Date
CITY OF WICHITA LANDSCAPE PLAN MAIZE ROAD STA. 3+670 TO STA. 3+900 SEDGWICK COUNTY			
Professional Engineering Consultants, P.A. 303 S. TOPEKA • WICHITA, KANSAS 67202 316-262-2691 • FAX 316-262-3003			
Designed by	SMP	Checked by	
Drawn by	DWR	Date	April, 2002
		Job No.	97362