




DATE	
BY	
REFERENCES NOTED	
REFERENCES CHECKED	

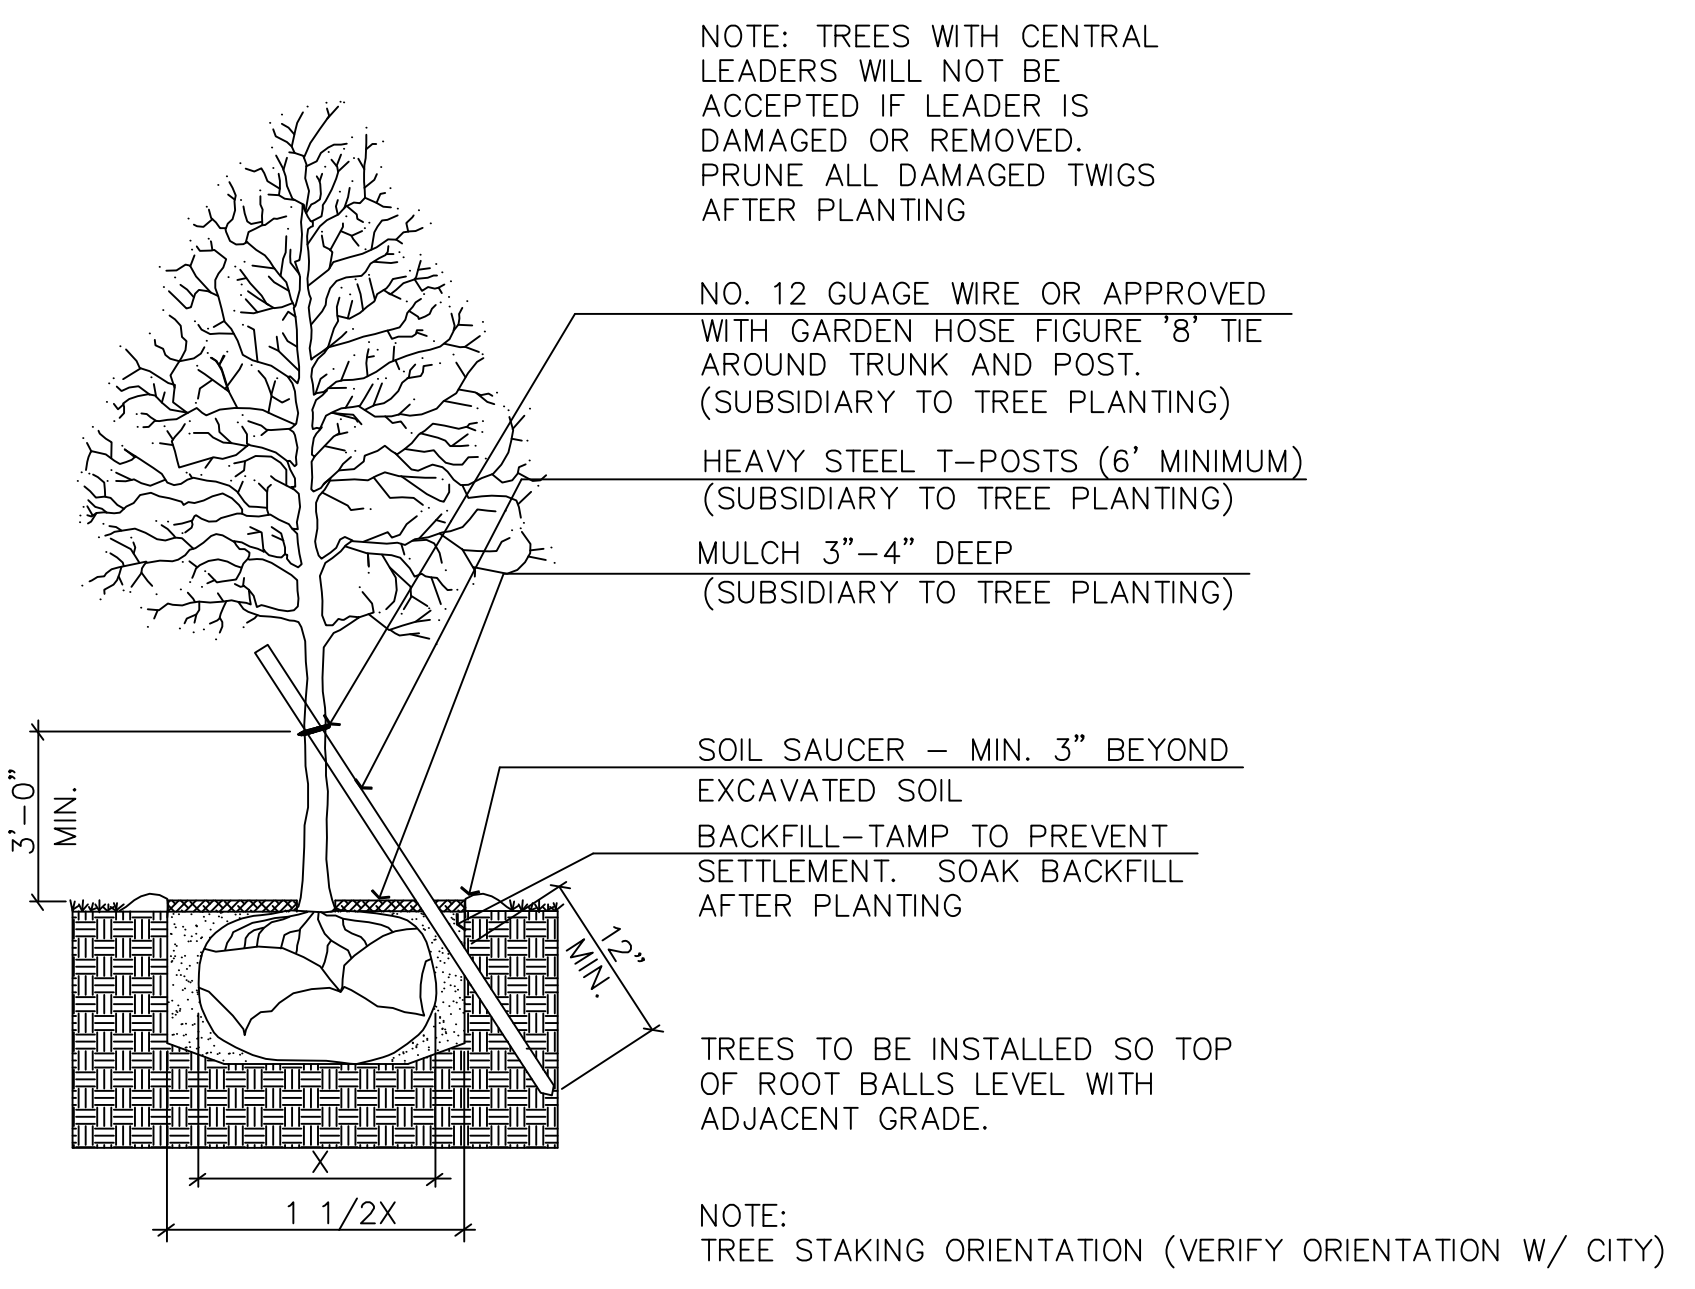


1 TREE PLANTING & STAKING DETAIL
1 3/4" CALIPER AND SMALLER NO SCALE

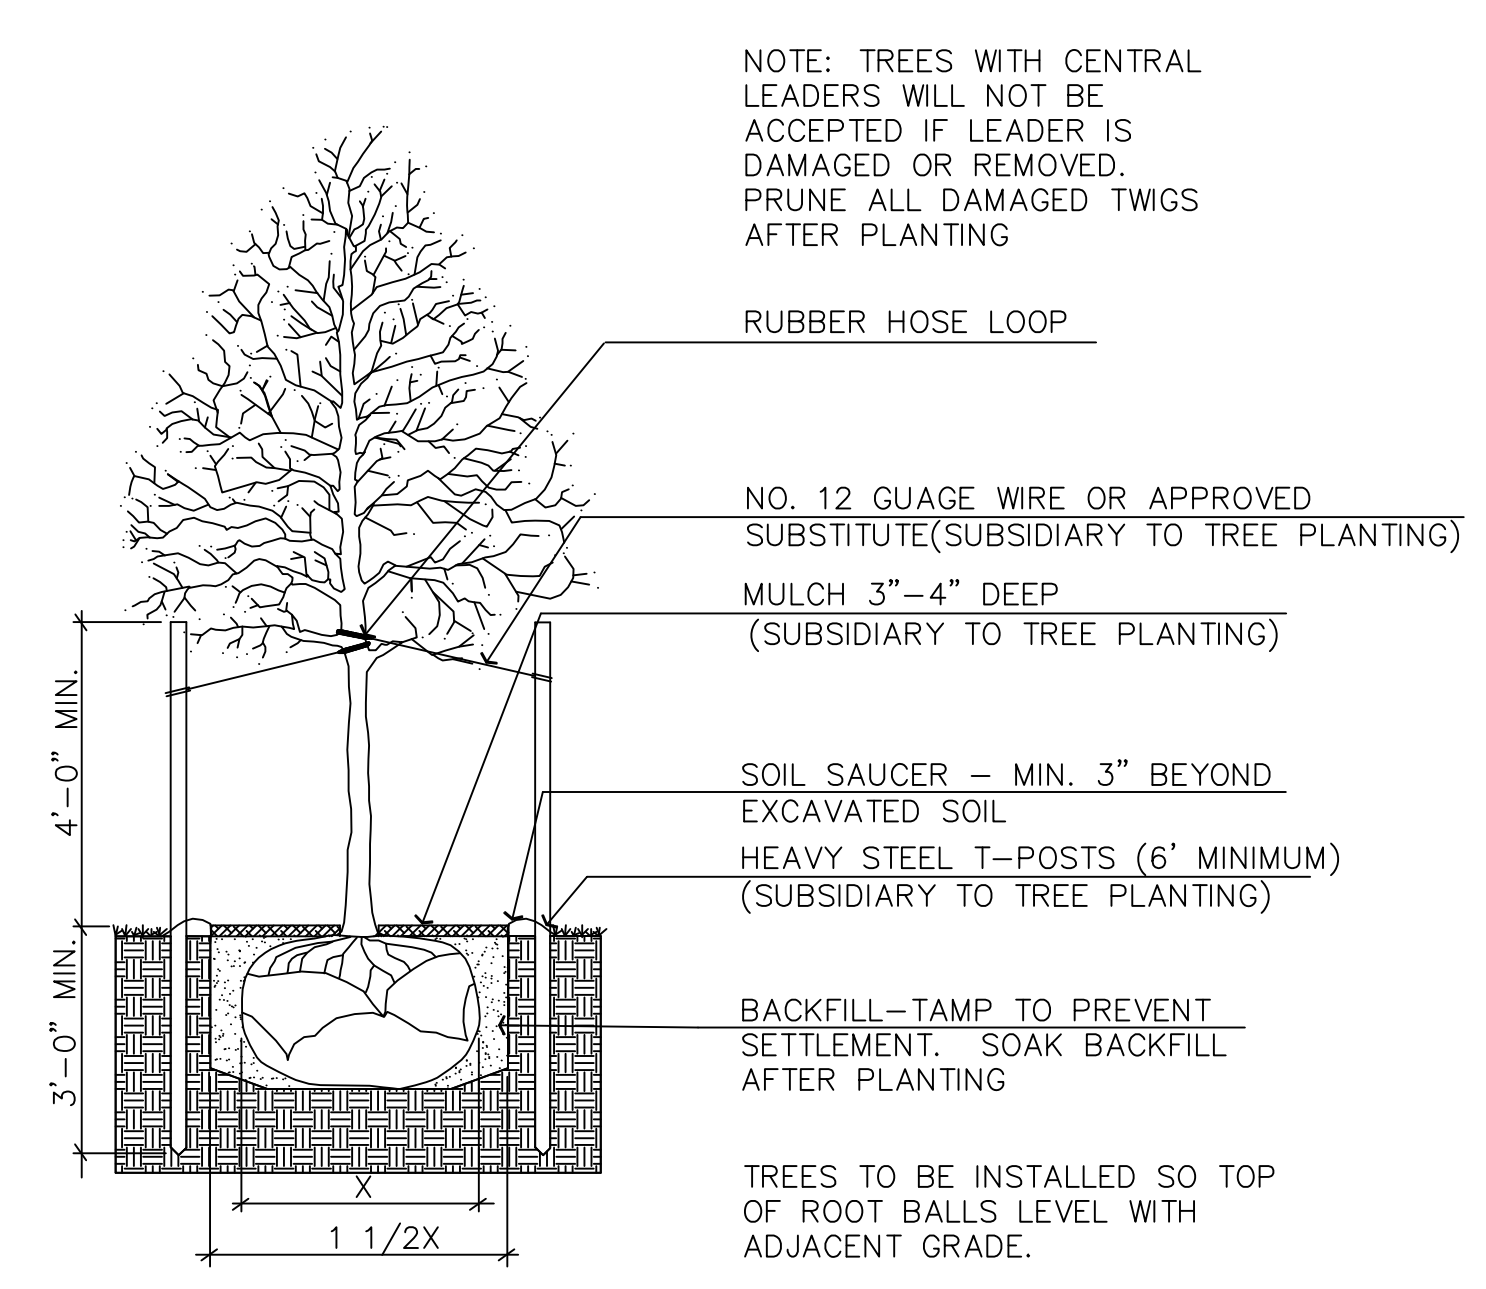


2 TREE PLANTING & STAKING DETAIL
2" CALIPER AND LARGER NO SCALE

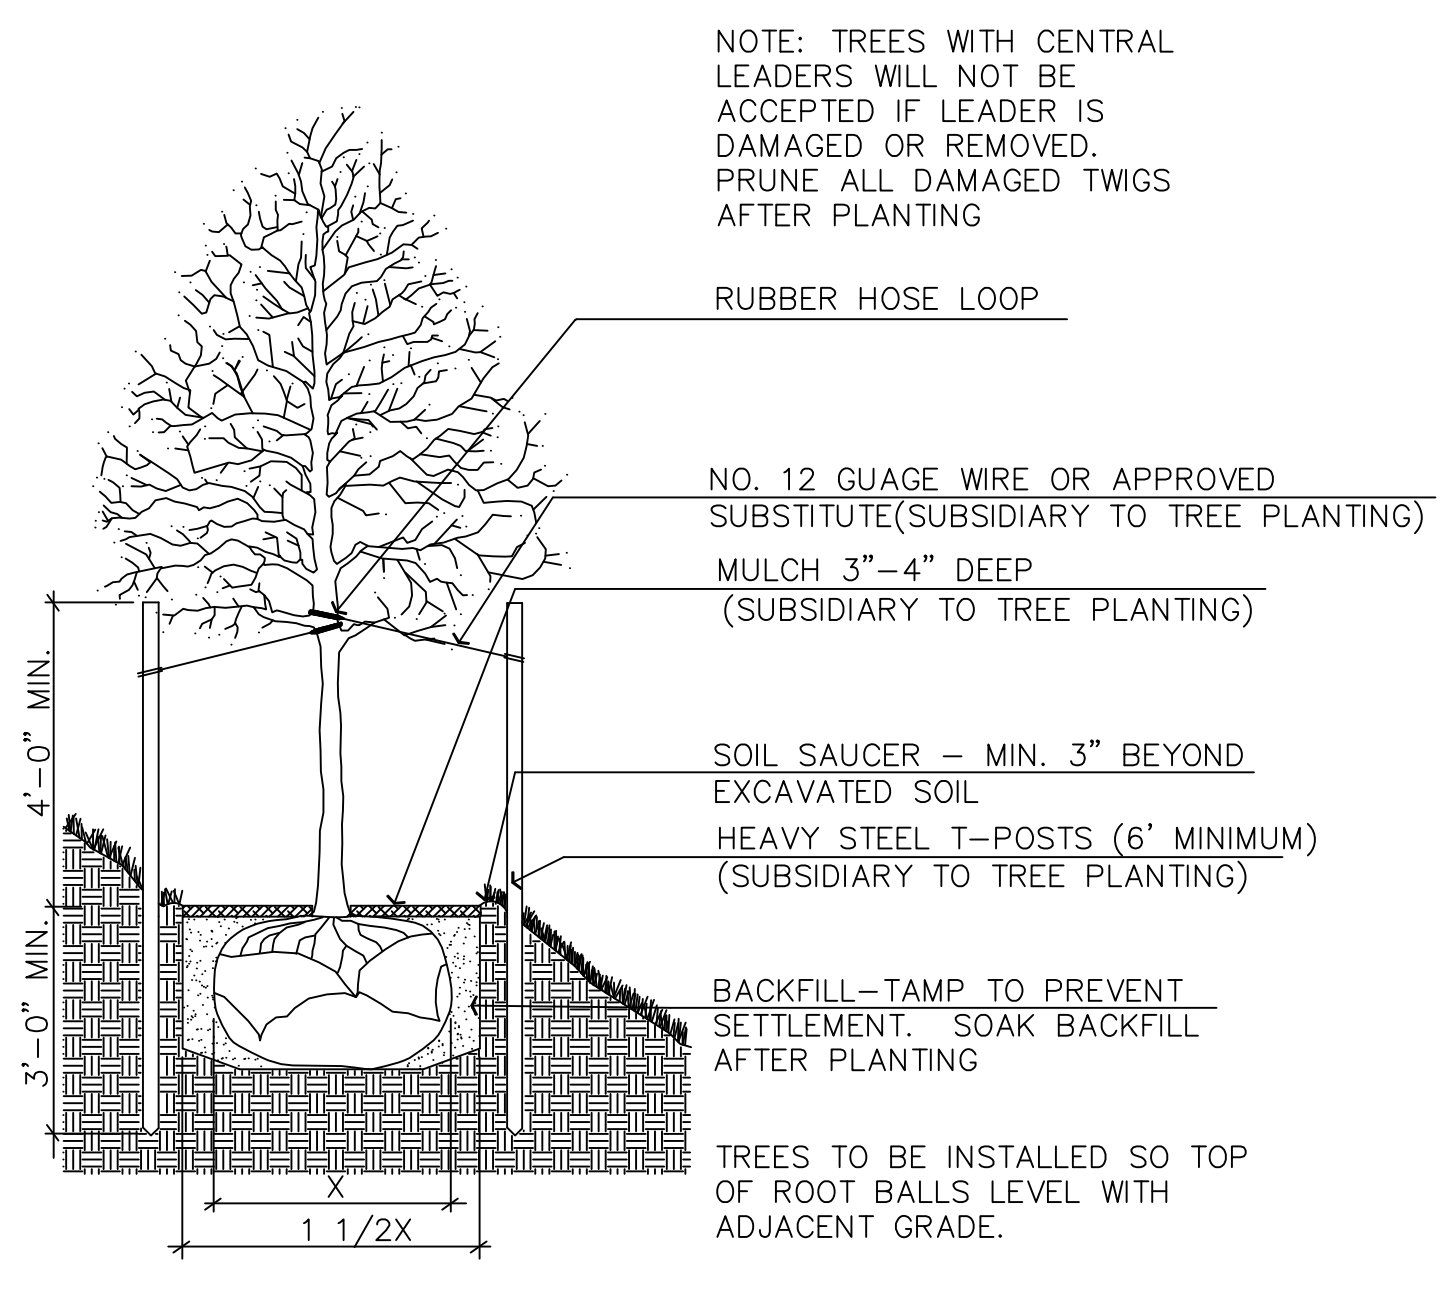


3 TREE PLANTING & STAKING DETAIL
SLOPE AREA PLANTING LARGER THAN 2" CALIPER NO SCALE

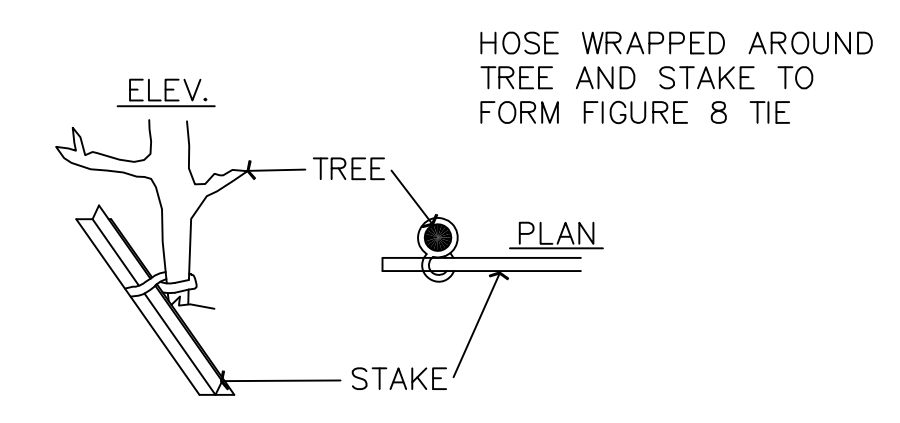

5 FIGURE '8' DETAIL
NO SCALE

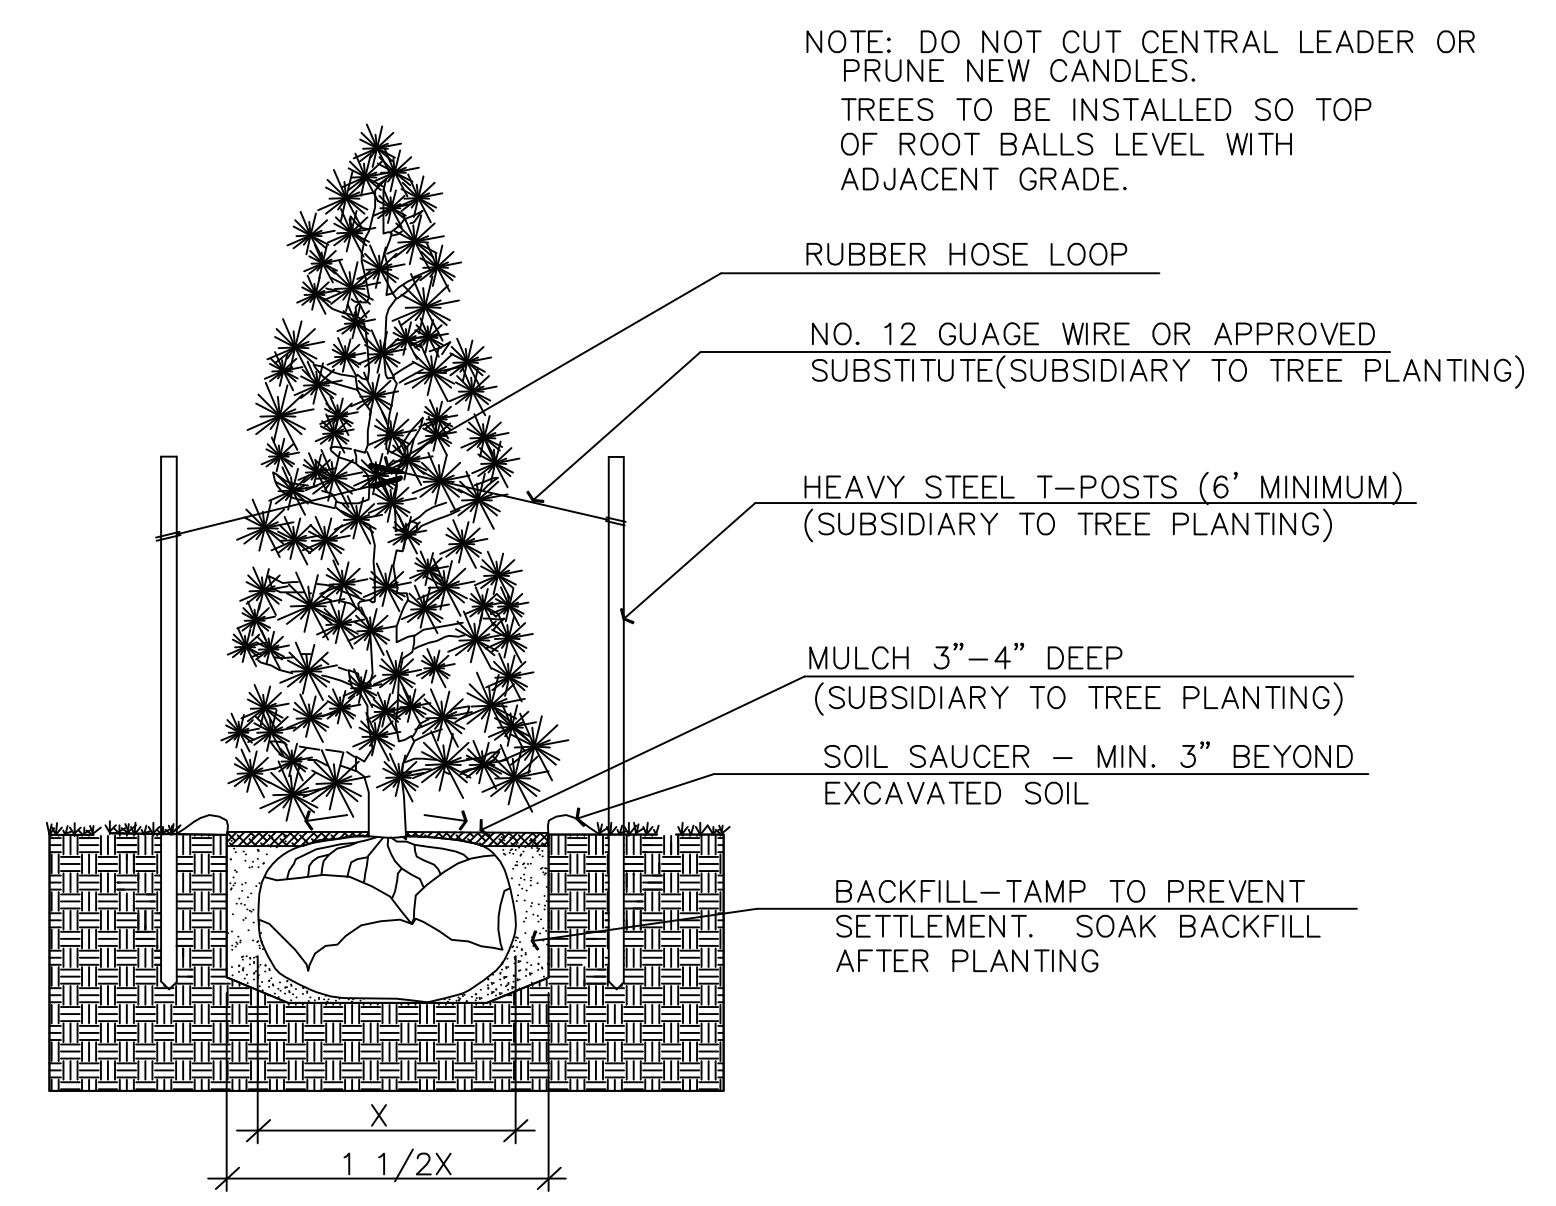

4 EVERGREEN PLANTING & STAKING DETAIL
NO SCALE

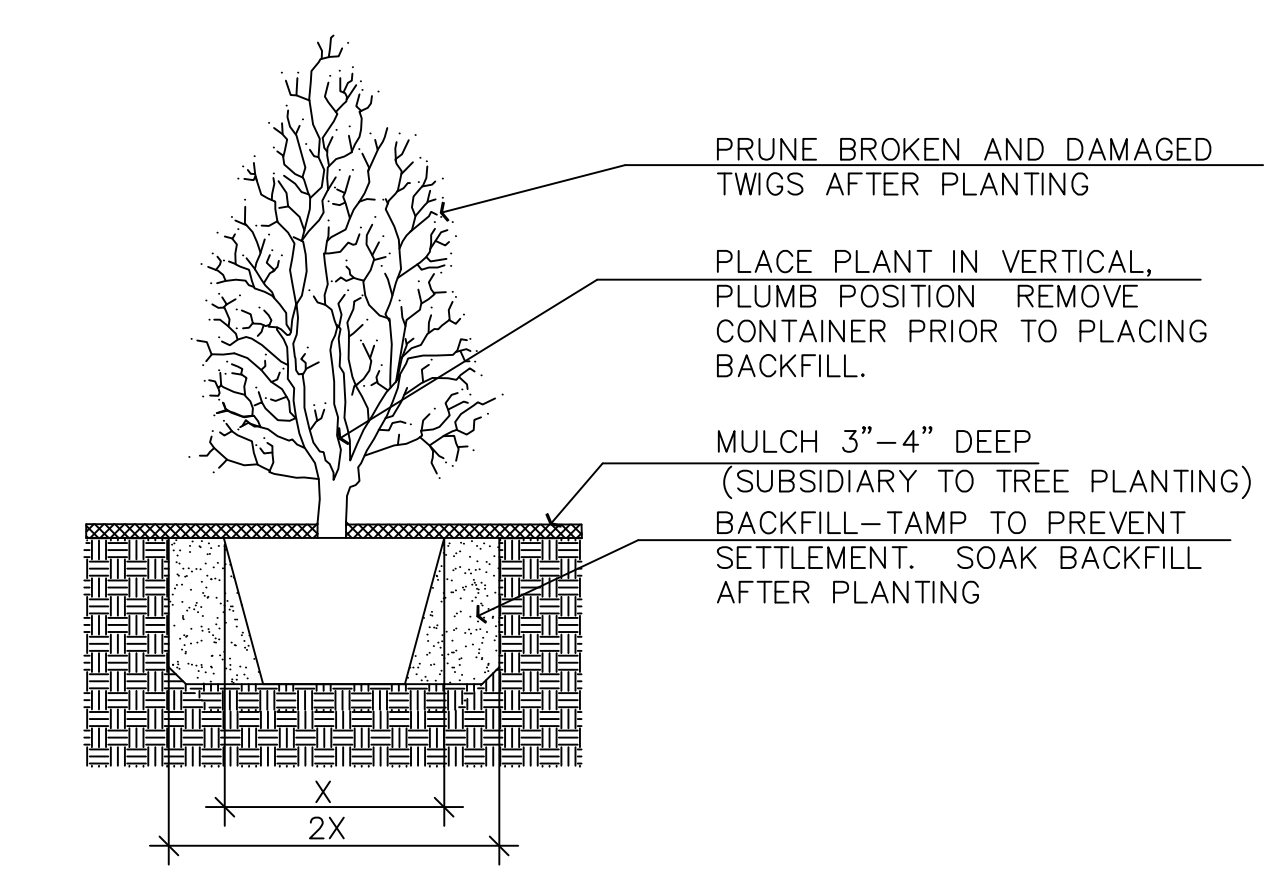

6 SHRUB PLANTING DETAIL
NO SCALE

PLANT LIST					
KEY	QTY.	COMMON NAME	BOTANICAL NAME	SIZE	COND.
SHADE TREES TOTAL = 193					
ABM	20	AUTUMN BLAZE MAPLE	ACER RUBRUM X FREEMANII 'AUTUMN BLAZE'	2" CAL.	B & B
APA	31	AUTUMN PURPLE ASH	FRAXINUS AMERICANA 'AUTUMN PURPLE'	2" CAL.	B & B
BC	6	BALDCYPRESS	TAXODIUM DISTICHUM	2" CAL.	B & B
BO	6	BURR OAK	QUERCUS MACROCARPA	2" CAL.	B & B
CP	15	CADDO MAPLE	ACER SACCHARUM 'CADDO'	2" CAL.	B & B
CP	43	CHINESE PISTACHE	PISTACHE CHINENSIS	2" CAL.	B & B
LE	10	LACEBARK ELM	ULMUS PARVIFOLIA	2" CAL.	B & B
LP	6	LONDON PLANETREE	PLATANUS X ACERIFOLIA 'BLOODGOOD'	2" CAL.	B & B
PPH	2	RAIRIE PRIDE HACKBERRY	CELTIS OCCIDENTALIS 'RAIRIE PRIDE'	2" CAL.	B & B
RSM	1	RED SUNSET MAPLE	ACER RUBRUM 'FRANKSRED'	2" CAL.	B & B
SHL	16	SHADEMASTER HONEYLOCUST	GLEDITSIA TRIACANTHOS 'INERMIS' 'SHADEMASTER'	2" CAL.	B & B
SRO	21	SHUMARD RED OAK	QUERCUS SHUMARDII	2" CAL.	B & B
UEO	2	UPRIGHT ENGLISH OAK	QUERCUS ROBUR 'FASTIGIATA'	2" CAL.	B & B
EVERGREEN TREES TOTAL = 41					
AP	41	AUSTRIAN PINE	PINUS NIGRA	6' HT.	B & B
ORNAMENTAL TREES TOTAL = 375					
AM	6	AMUR MAPLE	ACER GINNALA	6' CLUMP	B & B
BCM	18	BAILEY COMPACT AMUR MAPLE	ACER GINNALA 'BAILEY COMPACT'	4' HT.	B & B
CAP	2	CAPITAL PEAR	PYRUS CALLERYANA 'CAPITAL'	1.5" CAL.	B & B
CHP	2	CHANTICLEER PEAR	PYRUS CALLERYANA 'CLEVELAND SELECT'	1.5" CAL.	B & B
ERB	19	EASTERN REDBUD	CERCIS CANADENSIS	1.5" CAL.	B & B
GR	2	GOLDENRAIN TREE	KOELREUTERIA PANICULATA	1.5" CAL.	B & B
GC	8	GOLDENRAINDROPS CRABAPPLE	MALUS X 'GOLDENRAINDROPS'	1.5" CAL.	B & B
HAM	67	HEDGE OR AMUR MAPLE	ACER CAMPESTRE L. OR ACER GINNALA MAXIM	1.5" CAL.	B & B
HWC	3	HIGAN WEeping CHERRY	PRUNUS SUBHIRELLA 'PENDULA'	1.5" CAL.	B & B
LC	3	LOUISA CRABAPPLE	MALUS 'LOUISA'	1.5" CAL.	B & B
OR	29	OKLAHOMA REDBUD	CERCIS RENIFORMIS 'OKLAHOMA'	1.5" CAL.	B & B
PFC	51	PRAIRIFIRE CRABAPPLE	MALUS X 'PRAIRIFIRE'	1.5" CAL.	B & B
PLP	46	PURPLELEAF PLUM	PRUNUS CERASIFERA 'KRAUTER VESUVIUS'	1.5" CAL.	B & B
RJC	6	RED JADE CRABAPPLE	MALUS X 'RED JADE'	1.5" CAL.	B & B
SPD	6	STELLAR PINK DOGWOOD	CORNUS FLORIDA 'STELLAR PINK'	1.5" CAL.	B & B
SSC	63	SPRING SNOW CRABAPPLE	MALUS X 'SPRING SNOW'	1.5" CAL.	B & B
TC	30	THUNDERCHILD CRABAPPLE	MALUS X 'THUNDERCHILD'	1.5" CAL.	B & B
VPC	5	VELVET PILLAR CRABAPPLE	MALUS X 'VELVET PILLAR'	1.5" CAL.	B & B
SHRUBS TOTAL = 1519					
ACV	65	ALFREDO COMPACT AMERICAN CRANBERRYBUSH VIBURNUM	VIBURNUM TRILOBUM 'COMPACTUM'	5 GAL.	CONT.
ASY	27	ANDERSON SPREADING YEW	TAXUS CUSPIDATA 'ANDERSON'	5 GAL.	CONT.
BBH	1	BLUE BOY HOLLY	ILEX X MESERVEAE 'BLUE BOY'	5 GAL.	CONT.
BGH	2	BLUE GIRL HOLLY	ILEX X MESERVEAE 'BLUE GIRL'	5 GAL.	CONT.
BCJ	58	BLUE CHIP JUNIPER	JUNIPERUS HORIZONTALIS 'BLUE CHIP'	5 GAL.	CONT.
BE	224	BOXLEAF EUONYMUS	EUONYMUS JAPONICUS 'MICROPHYLLUS'	5 GAL.	CONT.
CPB	84	CRIMSON PIGMY BARBERRY	BERBERIS THUNBERGII 'ATROPURPUREA NANA'	5 GAL.	CONT.
DVW	12	DWARF VARIATED WIEGELA	WIEGELA FLORIDA 'VARIATED NANA'	5 GAL.	CONT.
GS	133	GOLDFLAME SPIREA	SPIREA X BUMALDA 'GOLDFLAME'	5 GAL.	CONT.
HJ	8	HILLSPIRE JUNIPER	JUNIPERUS CHINENSIS 'HILLSPIRE'	6' HT.	B & B
JGJ	48	JAPANESE GARDEN JUNIPER	JUNIPERUS PROCUMBENS	5 GAL.	CONT.
JV	66	JUDD VIBURNUM	VIBURNUM X JUDDII	5 GAL.	CONT.
ME	186	MANHATTAN EUONYMUS	EUONYMUS KIAUTSCHOVICUS 'MANHATTAN'	5 GAL.	CONT.
OG	162	OREGON GRAPEHOLLY MAHONIA	MAHONIA AQUIFOLIUM	5 GAL.	CONT.
RGB	22	ROSE GLOW BARBERRY	BERBERIS THUNBERGII ATROPURPUREA	5 GAL.	CONT.
RSR	76	DREAM RED HARDY SHRUB ROSE	ROSA 'DREAM RED SHRUB'	2 GAL.	CONT.
SGJ	22	SEA GREEN JUNIPER	JUNIPERUS CHINENSIS 'SEA GREEN'	5 GAL.	CONT.
SJ	36	SPARTAN JUNIPER	JUNIPERUS CHINENSIS 'SPARTAN'	6' HT.	B & B
TD	106	TATARIAN DOGWOOD	CORNUS ALBA 'SIBIRICA'	5 GAL.	CONT.
YSR	28	DREAM YELLOW HARDY SHRUB ROSE	ROSA 'DREAM YELLOW SHRUB'	2 GAL.	CONT.
GROUNDCOVERS/PERENNIALS/GRASSES TOTAL = 577					
BES	36	BLACK-EYED SUSAN (RUBBECKIA)	RUBBECKIA FULGIDA	2 GAL.	CONT.
DKC	95	DARK KNIGHT CARYOPTERIS	CARYOPTERIS X CLANDONENSIS 'DARK KNIGHT'	3 GAL.	CONT.
DL	16	"HAPPY DAYS" DAYLILLY	HEMEROCALIS 'HAPPY DAYS'	1 GAL.	CONT.
KG	20	KANSAS GAYFEATHER	LIATRIS SPICATA	2 GAL.	CONT.
MG	44	MAIDEN GRASS	MISCANTHUS SINENSIS 'GRACILLIMUS'	5 GAL.	CONT.
ML	220	MAJESTIC LIRIOPE	LIRIOPE MUSCARI	1 GAL.	CONT.
PC	21	PURPLE CONEFLOWER	ECHINACEA PURPUREA 'MAGNUS'	2 GAL.	CONT.
PG	31	HARDY PAMPAS GRASS	ERIANTHUS RAVENNAE	5 GAL.	CONT.
RS	15	RUSSIAN SAGE	PEROVSKIA ATRIPLICIFOLIA	2 GAL.	CONT.

AS-BUILT DRAWINGS
THESE DOCUMENTS INCLUDE RECORD INFORMATION PROVIDED BY THE CONTRACTOR. THIS INFORMATION HAS NOT BEEN VERIFIED IN ITS ENTIRETY BY THE DESIGN PROFESSIONAL DATE: SEPTEMBER, 2006

1		Revisions		By	Date
CITY OF WICHITA LANDSCAPE DETAILS SEDGWICK COUNTY					
Professional Engineering Consultants, P.A. 303 S. TOPEKA • WICHITA, KANSAS 67202 316-262-2691 • FAX 316-262-3003					
Designed by	SMP	Checked by			
Drawn by	DWR	Date	April, 2002	Job No.	97362

DSNR: OPER: DWR SCALE: 1:500 F/9934/S146 BY:DWR

