


FHWA REGION NO.	STATE	PROJECT NO.	YEAR	SHEET NO.	TOTAL SHEETS
7	KANSAS	54-87 6657-01	2002	891	1122


DATE	
BY	
REFERENCES NOTED	
REFERENCES CHECKED	

DSNR: WDH OPER: JGP SCALE: 1:250
 i:/1997/97362/INTERSECTIONS/MAIZE_rmp.dgn 12-21-2000 15:07:39 LAST REV: 10-16-01 BY: JGP

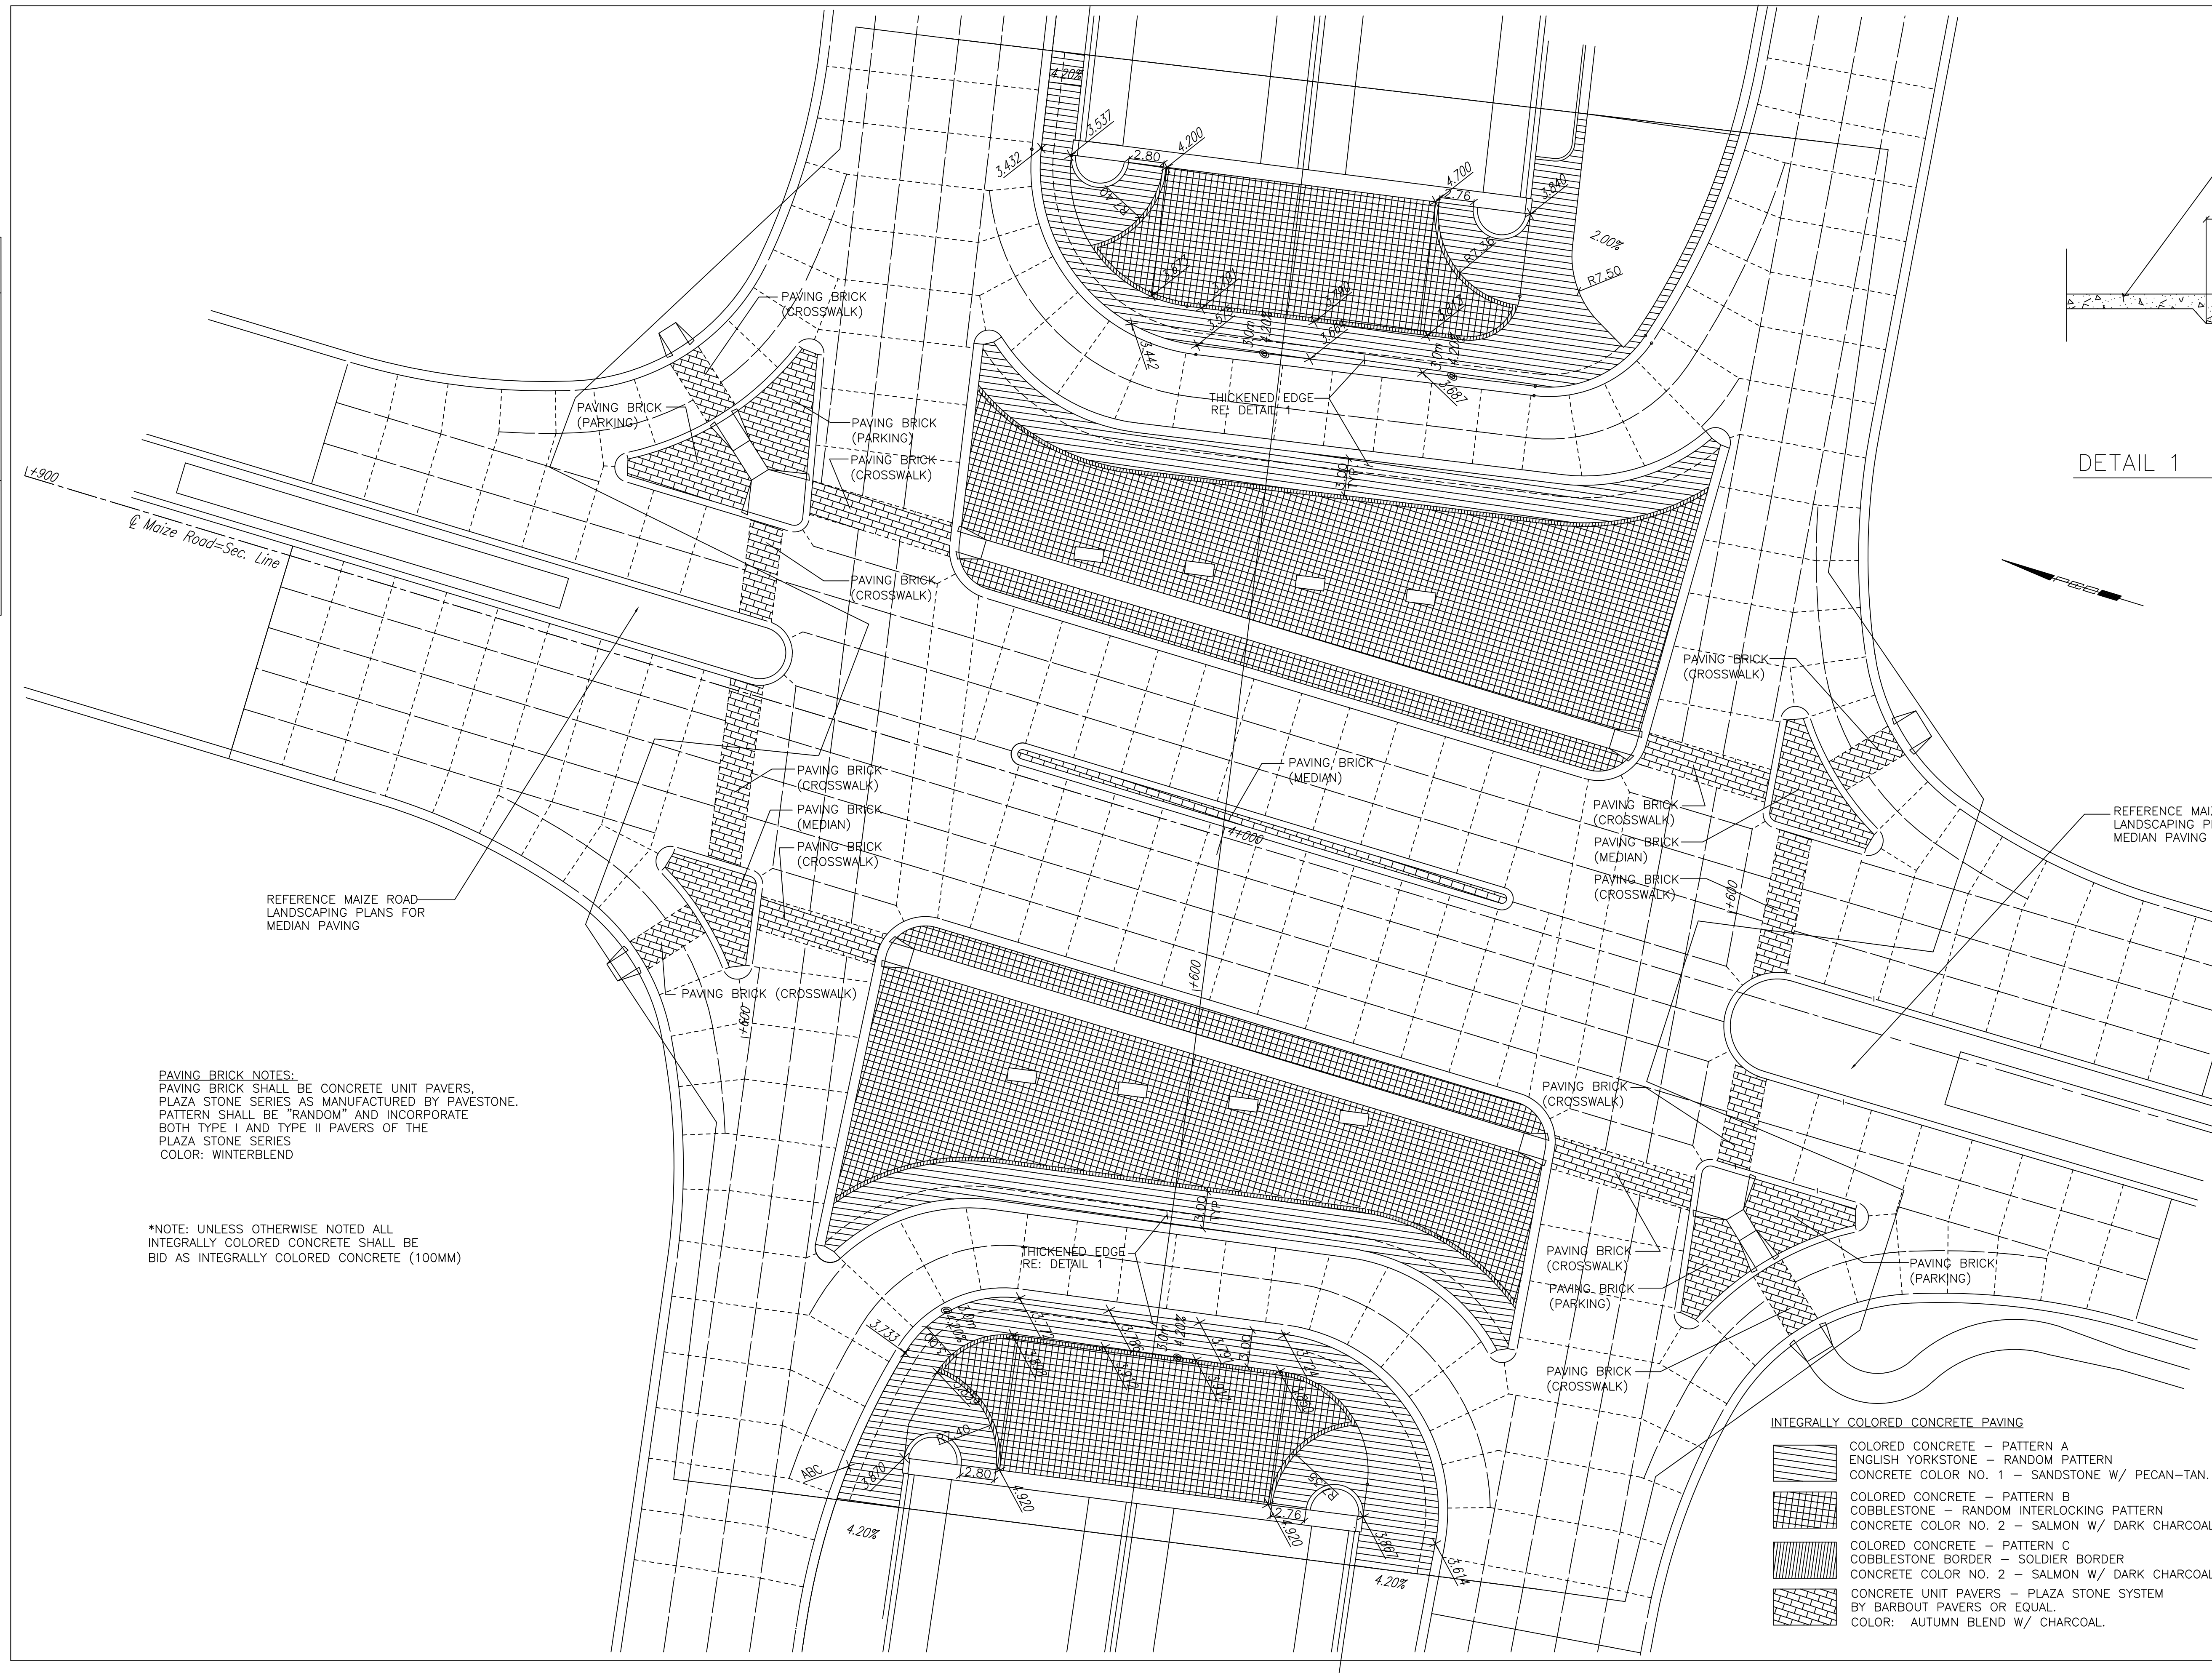

PAVING BRICK NOTES:
 PAVING BRICK SHALL BE CONCRETE UNIT PAVERS, PLAZA STONE SERIES AS MANUFACTURED BY PAVESTONE. PATTERN SHALL BE "RANDOM" AND INCORPORATE BOTH TYPE I AND TYPE II PAVERS OF THE PLAZA STONE SERIES.
 COLOR: WINTERBLEND

*NOTE: UNLESS OTHERWISE NOTED ALL INTEGRALLY COLORED CONCRETE SHALL BE BID AS INTEGRALLY COLORED CONCRETE (100MM)

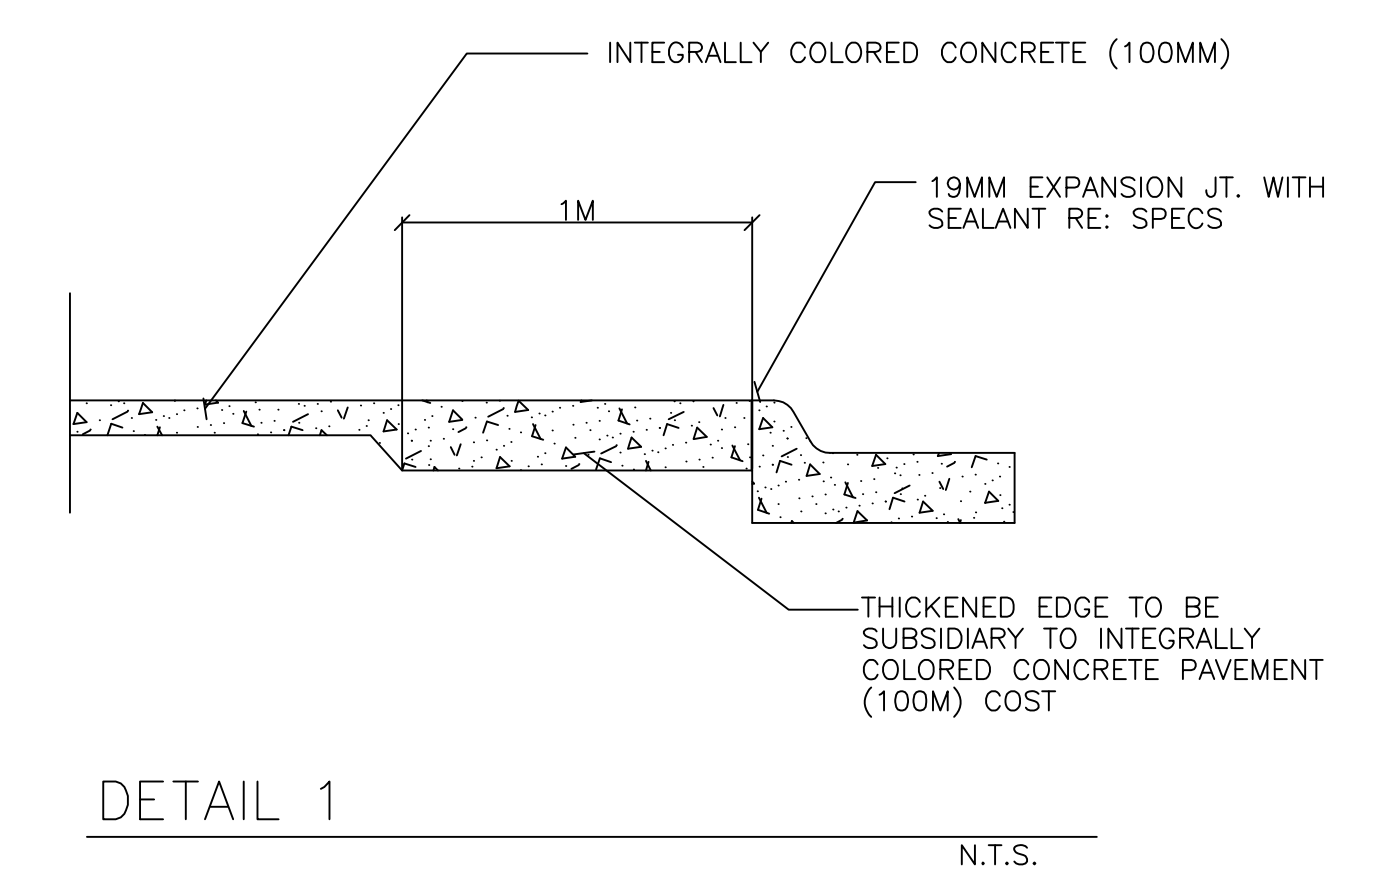

- INTEGRALLY COLORED CONCRETE PAVING**
- COLORED CONCRETE - PATTERN A
 ENGLISH YORKSTONE - RANDOM PATTERN
 CONCRETE COLOR NO. 1 - SANDSTONE W/ PECAN-TAN.
 - COLORED CONCRETE - PATTERN B
 COBBLESTONE - RANDOM INTERLOCKING PATTERN
 CONCRETE COLOR NO. 2 - SALMON W/ DARK CHARCOAL.
 - COLORED CONCRETE - PATTERN C
 COBBLESTONE BORDER - SOLDIER BORDER
 CONCRETE COLOR NO. 2 - SALMON W/ DARK CHARCOAL.
 - CONCRETE UNIT PAVERS - PLAZA STONE SYSTEM
 BY BARBOUT PAVERS OR EQUAL.
 COLOR: AUTUMN BLEND W/ CHARCOAL.

AS-BUILT DRAWINGS
 THESE DOCUMENTS REFLECT RECORD INFORMATION PROVIDED BY THE CONTRACTOR. THIS INFORMATION HAS NOT BEEN VERIFIED IN ITS ENTIRETY BY THE DESIGN PROFESSIONAL. DATE: SEPTEMBER 2006.

1			
No.	Revisions	By	Date
CITY OF WICHITA			
ORNAMENTAL PAVING PLAN MAIZE ROAD			
SEDGWICK COUNTY			
Professional Engineering Consultants, P.A. 303 S. TOPEKA • WICHITA, KANSAS 67202 316-262-2691 • FAX 316-262-3003			
Designed by	SMP	Checked by	JPM
Drawn by	DWR	Date	April, 2002
		Job No.	97362