


FHWA REGION NO.	STATE	PROJECT NO.	YEAR	SHEET NO.	TOTAL SHEETS
7	KANSAS	54-87 K-6657-01	2002	681	1122

Scale: 1:500

DATE	BY
REFERENCES NOTED	REFERENCES CHECKED

DSNR: WDH OPER: JGP SCALE: 1:500
 i:/1997/97362/As-Builts/dgn's/Vol. 4/Sh 681-pl238.dgn Last Rev: 9-20-07 By: gdr

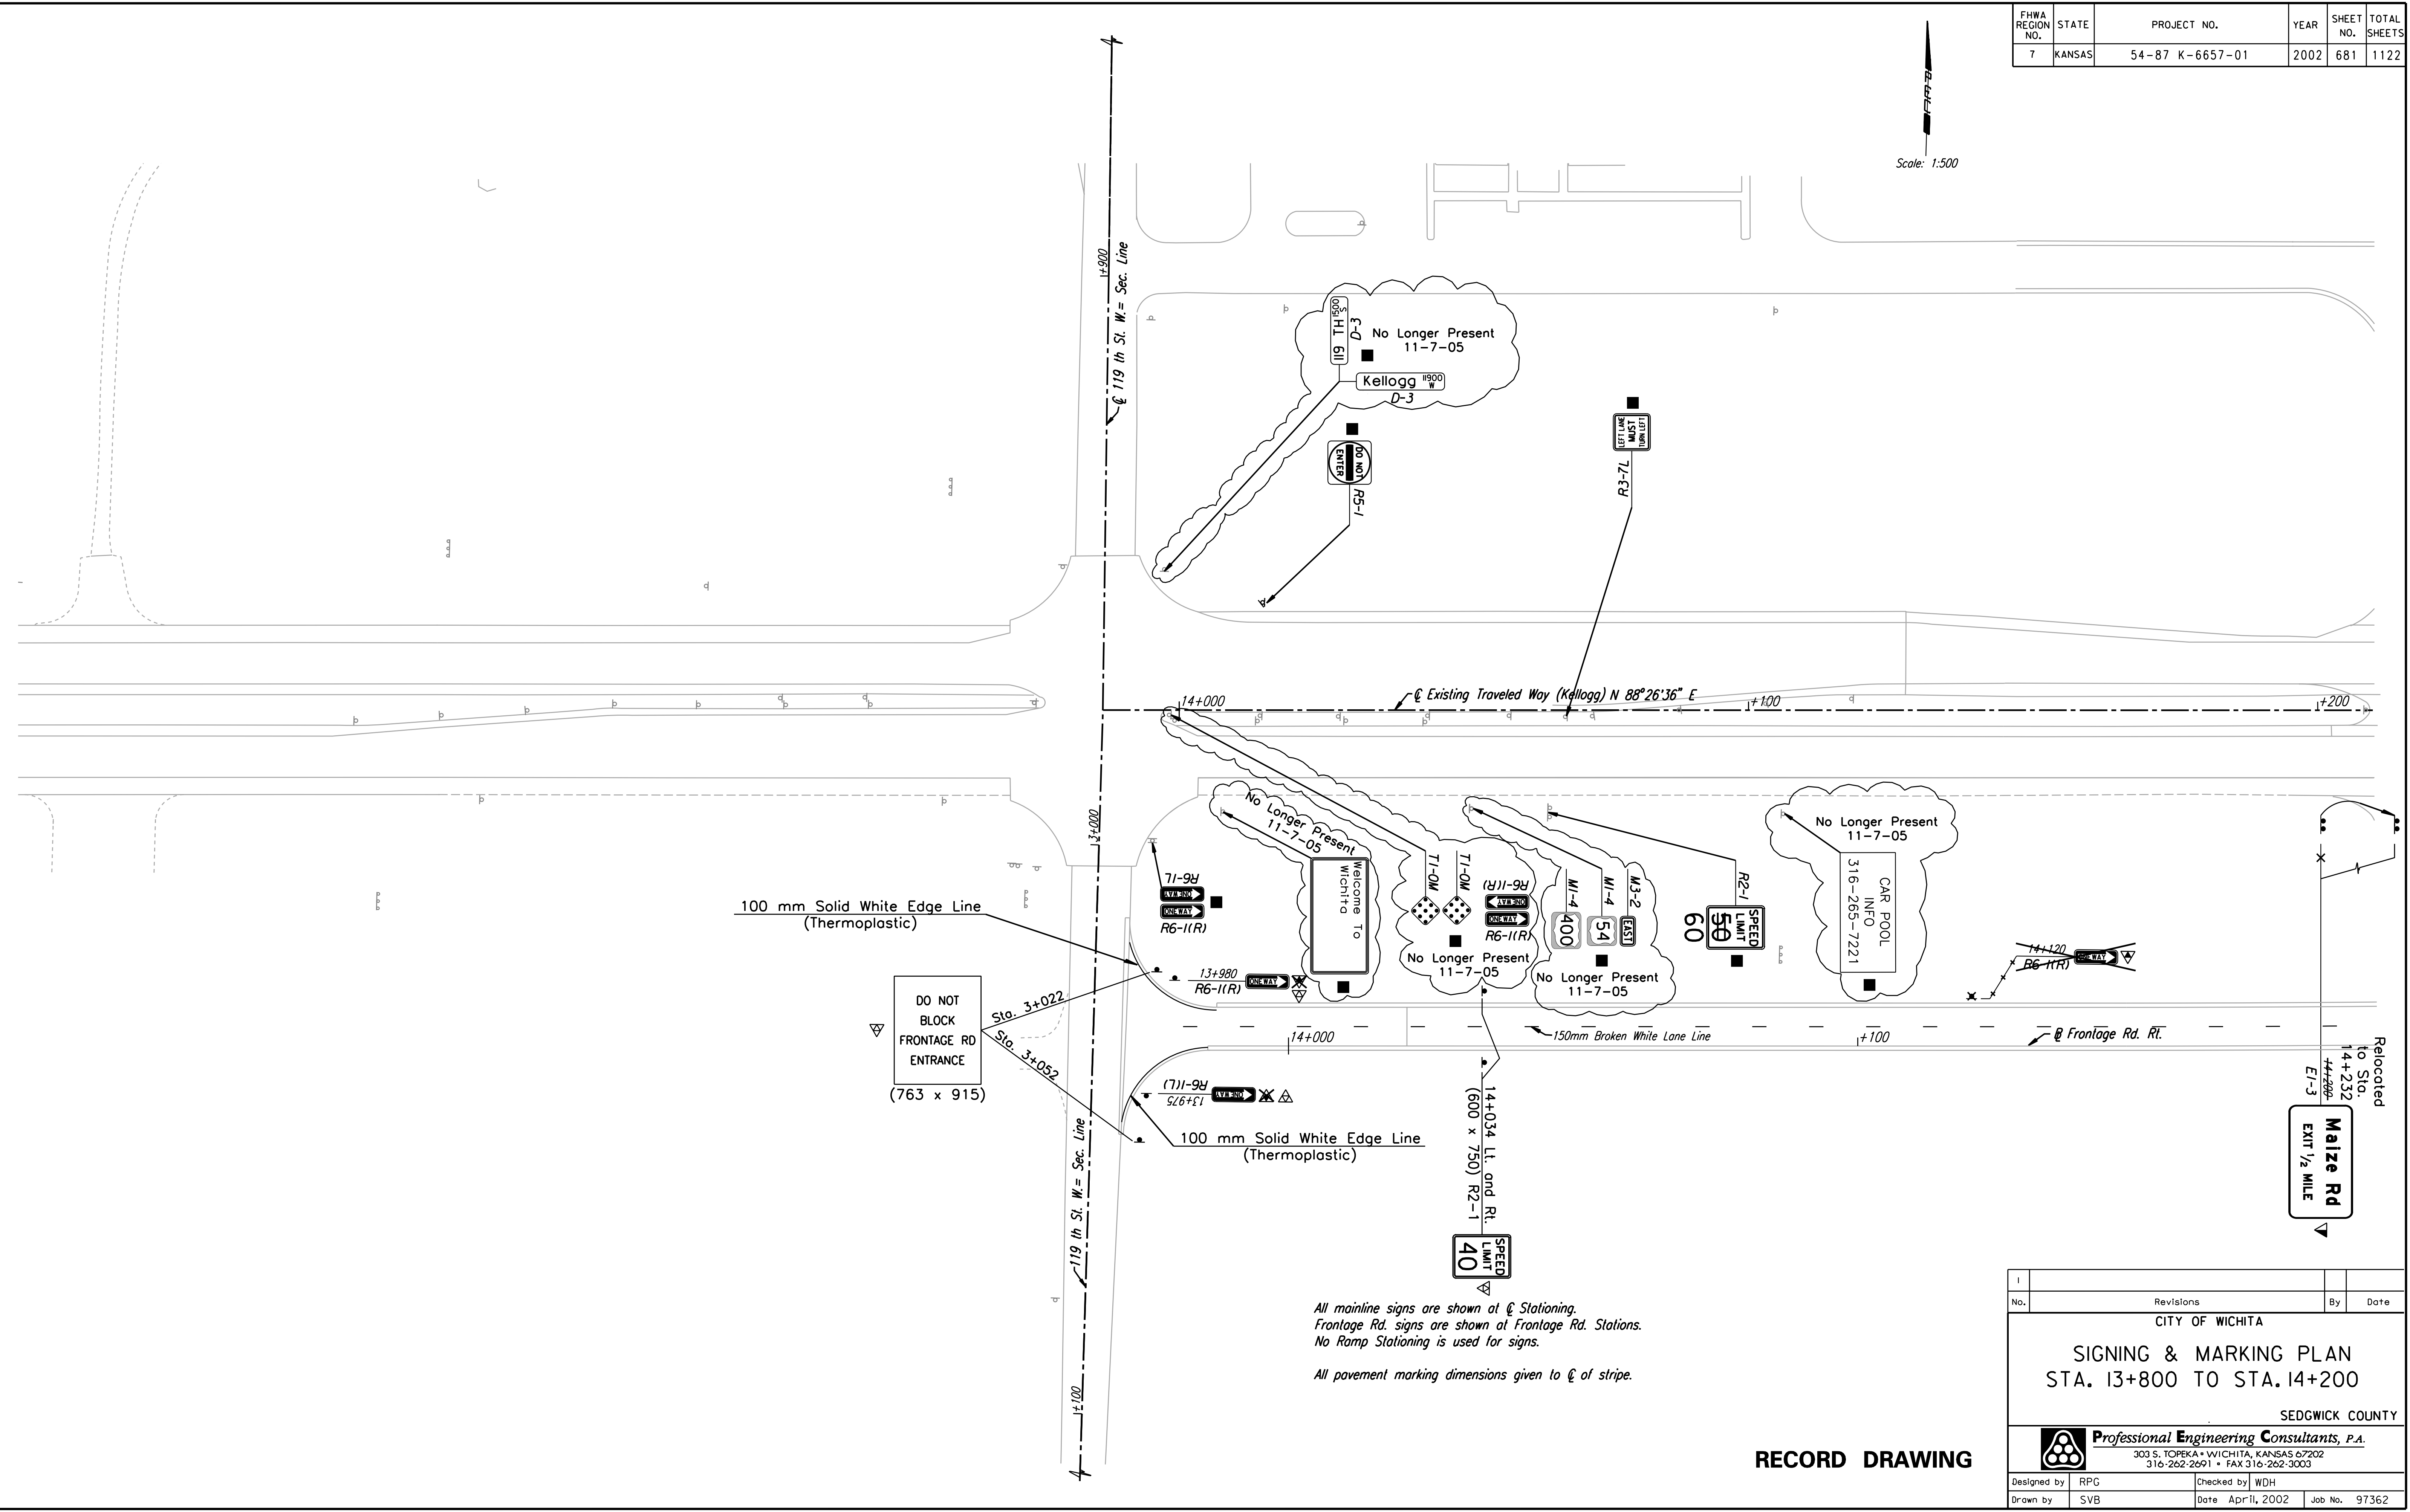

All mainline signs are shown at @ Stationing.
 Frontage Rd. signs are shown at Frontage Rd. Stations.
 No Ramp Stationing is used for signs.
 All pavement marking dimensions given to @ of stripe.

RECORD DRAWING

No.	Revisions	By	Date
CITY OF WICHITA			
SIGNING & MARKING PLAN STA. 13+800 TO STA. 14+200			
SEDGWICK COUNTY			
Professional Engineering Consultants, P.A. 303 S. TOPEKA • WICHITA, KANSAS 67202 316-262-2691 • FAX 316-262-3003			
Designed by	RPG	Checked by	WDH
Drawn by	SVB	Date	April, 2002
		Job No.	97362