


FHWA REGION NO.	STATE	PROJECT NO.	YEAR	SHEET NO.	TOTAL SHEETS
7	KANSAS	54-87 K-6657-01	2002	684	1122

2-(R2-5a) Signs replaced with 2-(W3-3) Signs. Also 2-wood posts deleted and 2-steel posts and concrete footings added.

DATE	
BY	
REFERENCES NOTED	
REFERENCES CHECKED	

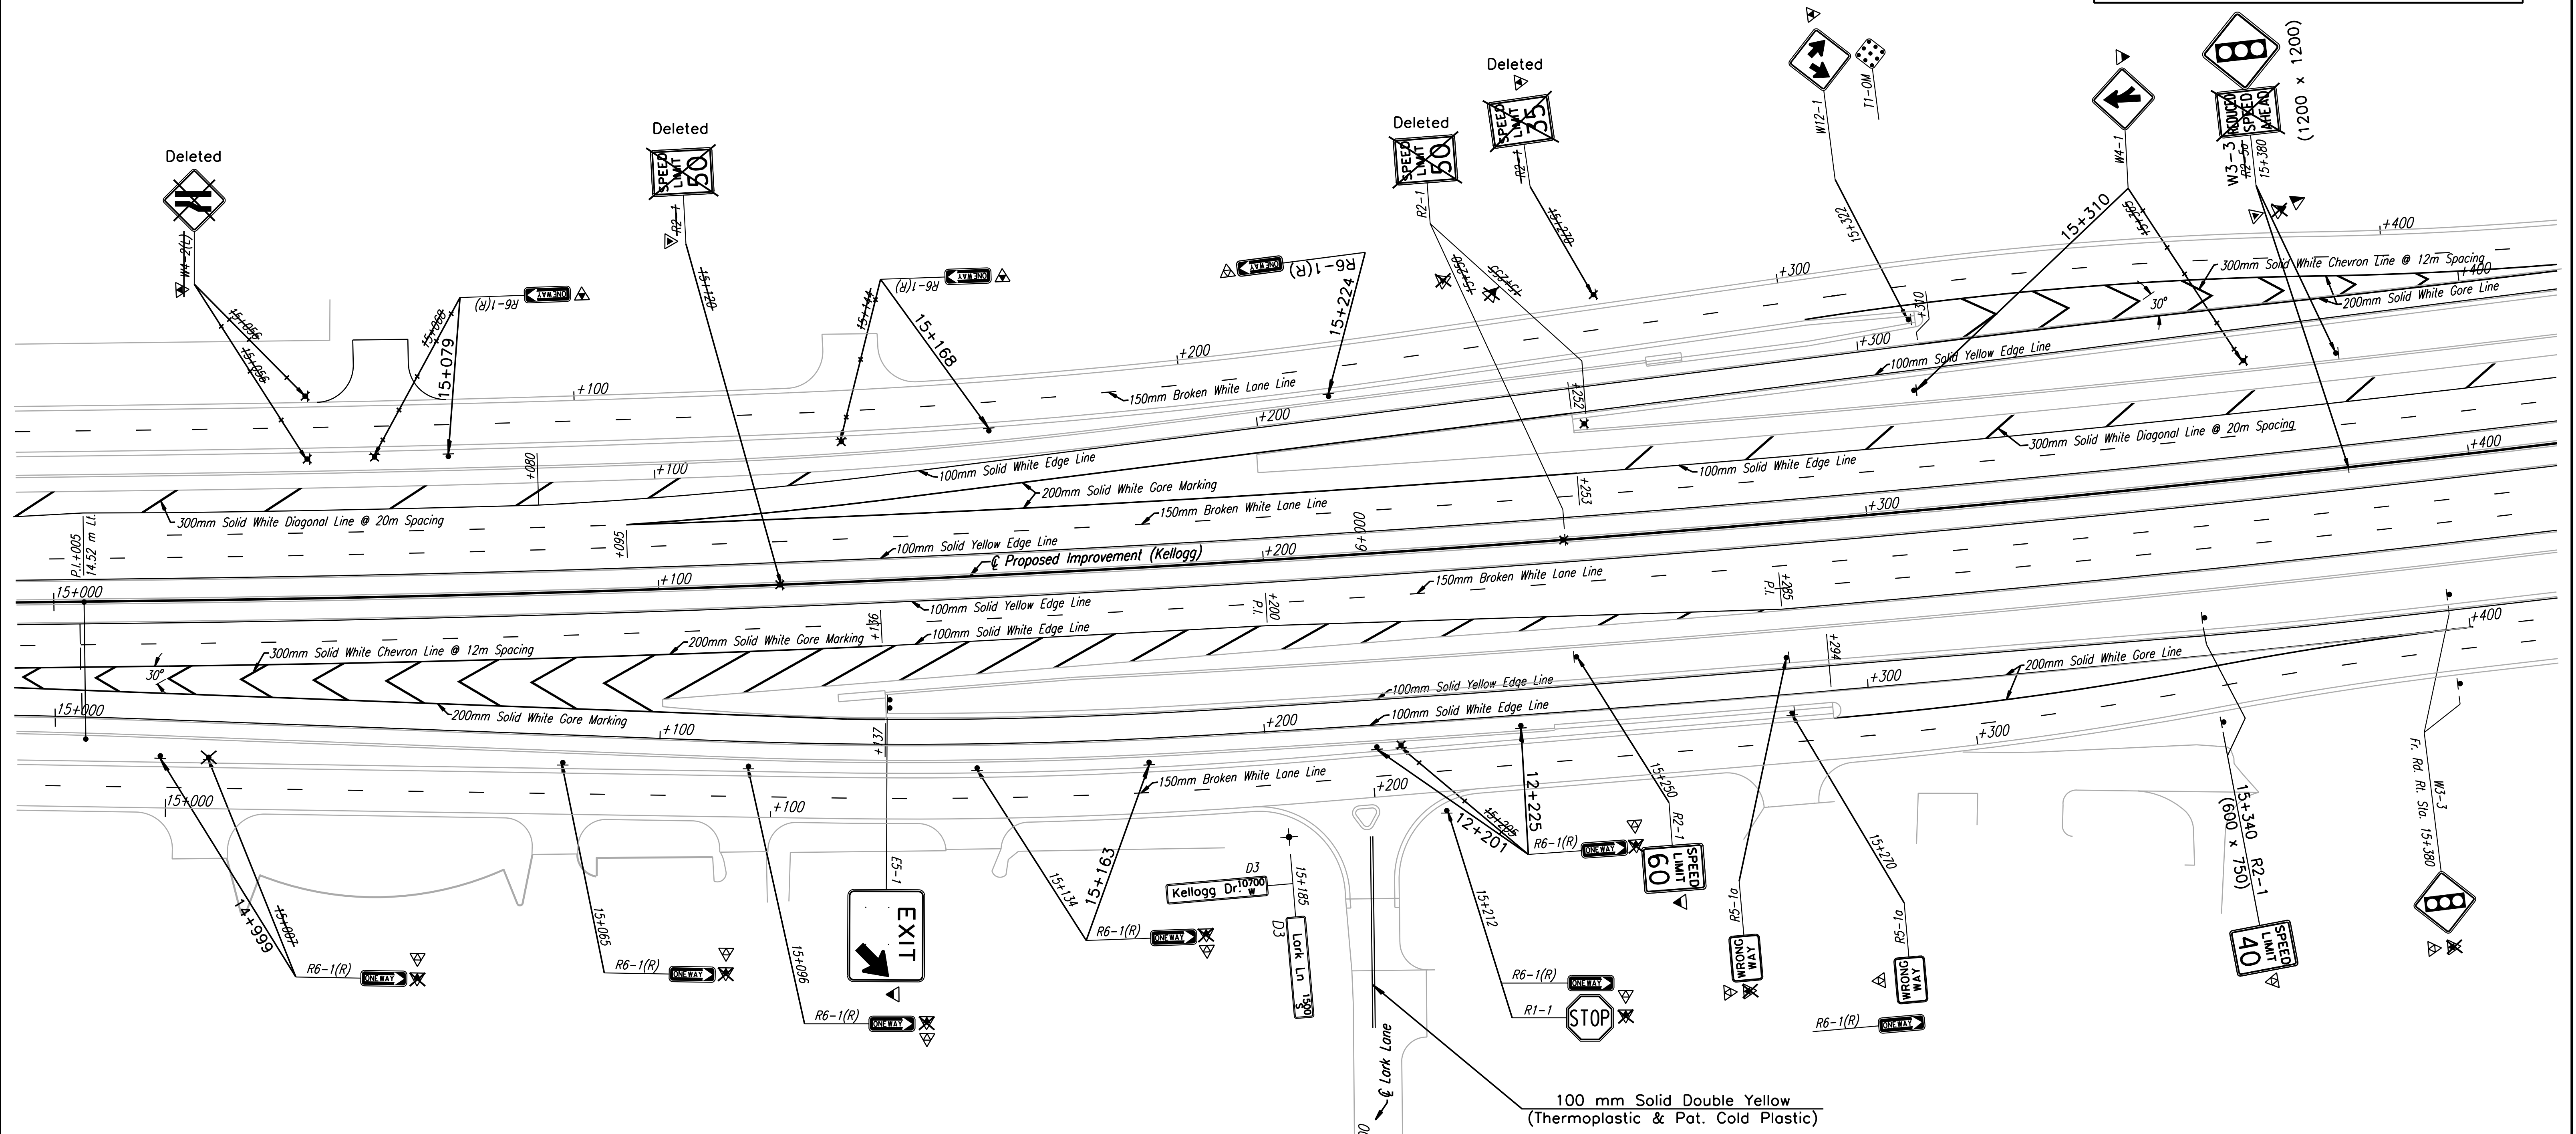

DSNR: WDH OPER: JGP SCALE: 1:500
 i:/1997/97362/As-Builts/dgn s/VoL 4/Sh 684-p1150.dgn Last Rev: 9-21-07 By: gar

RECORD DRAWING

No.	Revisions	By	Date
CITY OF WICHITA			
SIGNING & MARKING PLAN			
STA. 15+000 TO STA. 15+400			
SEDGWICK COUNTY			
Professional Engineering Consultants, P.A. 303 S. TOPEKA • WICHITA, KANSAS 67202 316-262-2691 • FAX 316-262-3003			
Designed by	RPG	Checked by	WDH
Drawn by	SVB	Date	April, 2002
		Job No.	97362