


FHWA REGION NO.	STATE	PROJECT NO.	YEAR	SHEET NO.	TOTAL SHEETS
7	KANSAS	54-87 K-6657-01	2002	685	1122

NOTE:
Install 150 mm Solid White Edge Lines (Pat. Cold Plastic) around all Islands, except don't install on paving brick at crosswalks

DATE	BY
REFERENCES NOTED	REFERENCES CHECKED

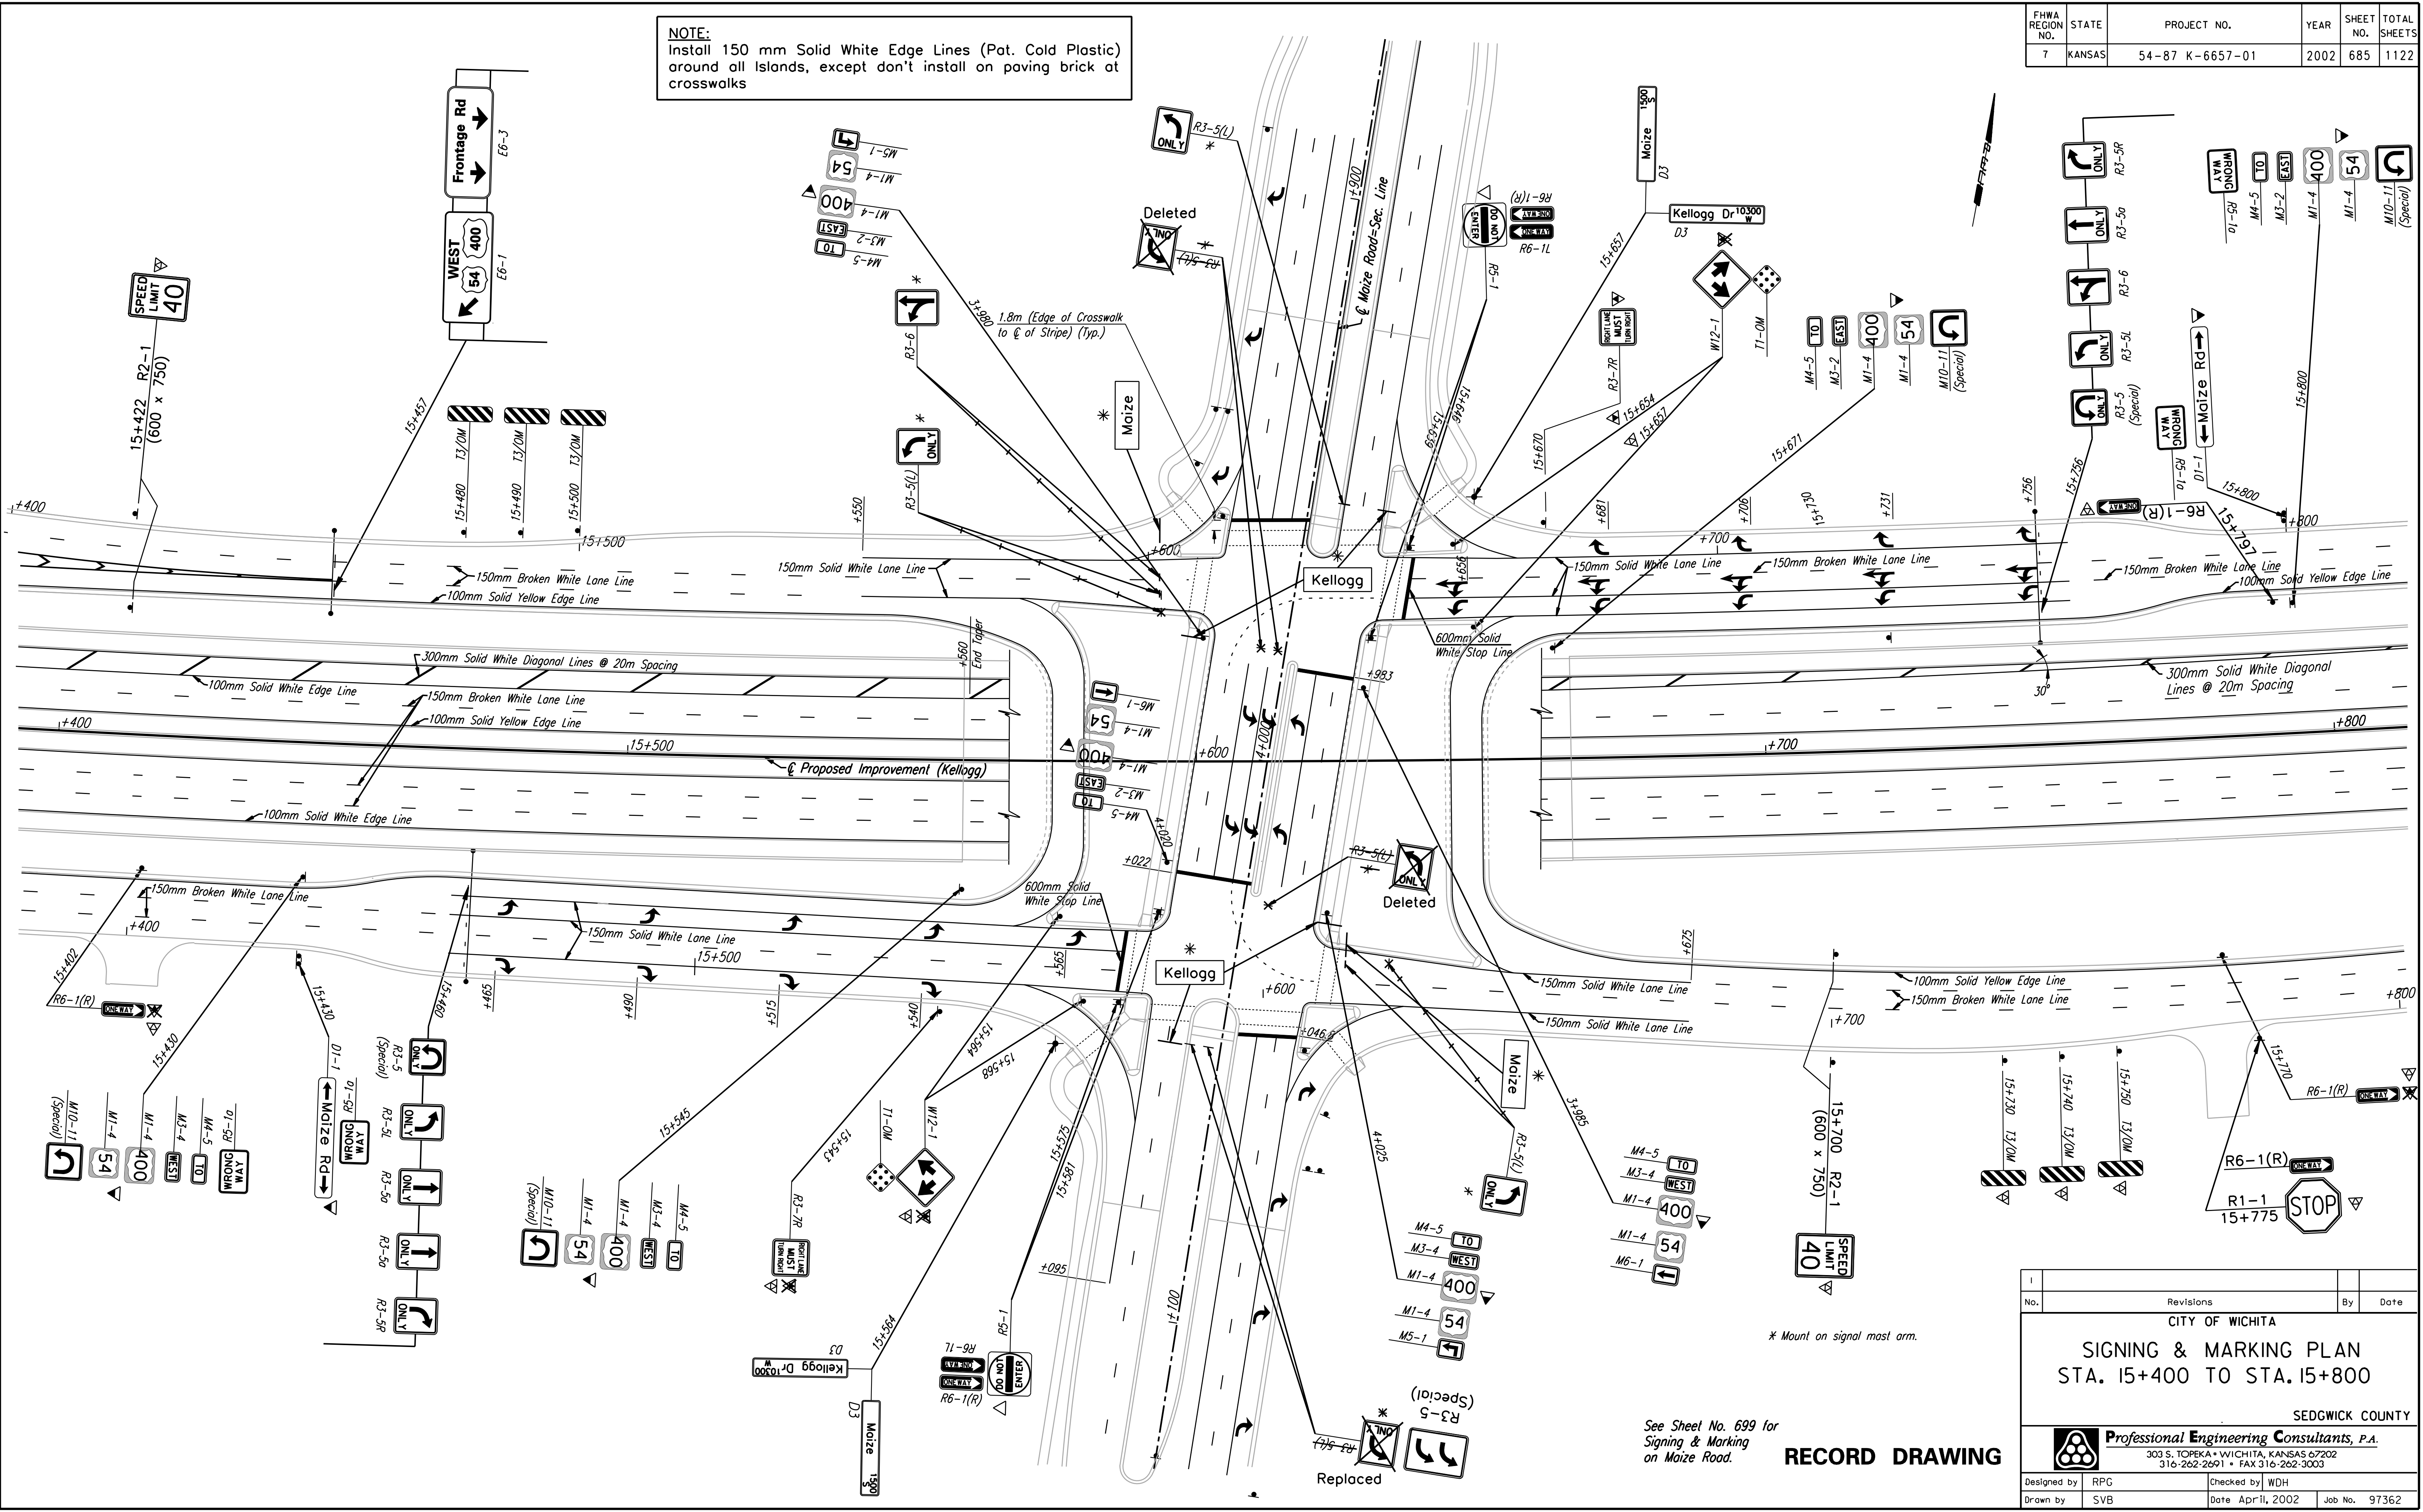

DSNR: WDH OPER: JGP SCALE: 1:500
 I:/1997/97362/As-Builts/dgn s/VoL4/Sh 685-p1154.dgn Last Rev: 10-1-07 By: gdr

See Sheet No. 699 for Signing & Marking on Maize Road.

RECORD DRAWING

Revisions		By	Date
No.			
CITY OF WICHITA			
SIGNING & MARKING PLAN			
STA. 15+400 TO STA. 15+800			
SEDGWICK COUNTY			
Professional Engineering Consultants, P.A.			
303 S. TOPEKA • WICHITA, KANSAS 67202 316-262-2691 • FAX 316-262-3003			
Designed by	RPG	Checked by	WDH
Drawn by	SVB	Date	Apr 11, 2002
Job No.		97362	