


FHWA REGION NO.	STATE	PROJECT NO.	YEAR	SHEET NO.	TOTAL SHEETS
7	KANSAS	54-87 K-6657-01	2002	686	1122

BY	DATE
REFERENCES NOTED	REFERENCES CHECKED

DSNR: WDH OPER: JGP SCALE: 1:500
 i:/1997/97362/As-Builts/dgn's/VoL_4/Sh 686-p158.dgn Lost Rev: 10-1-07 By: gdr

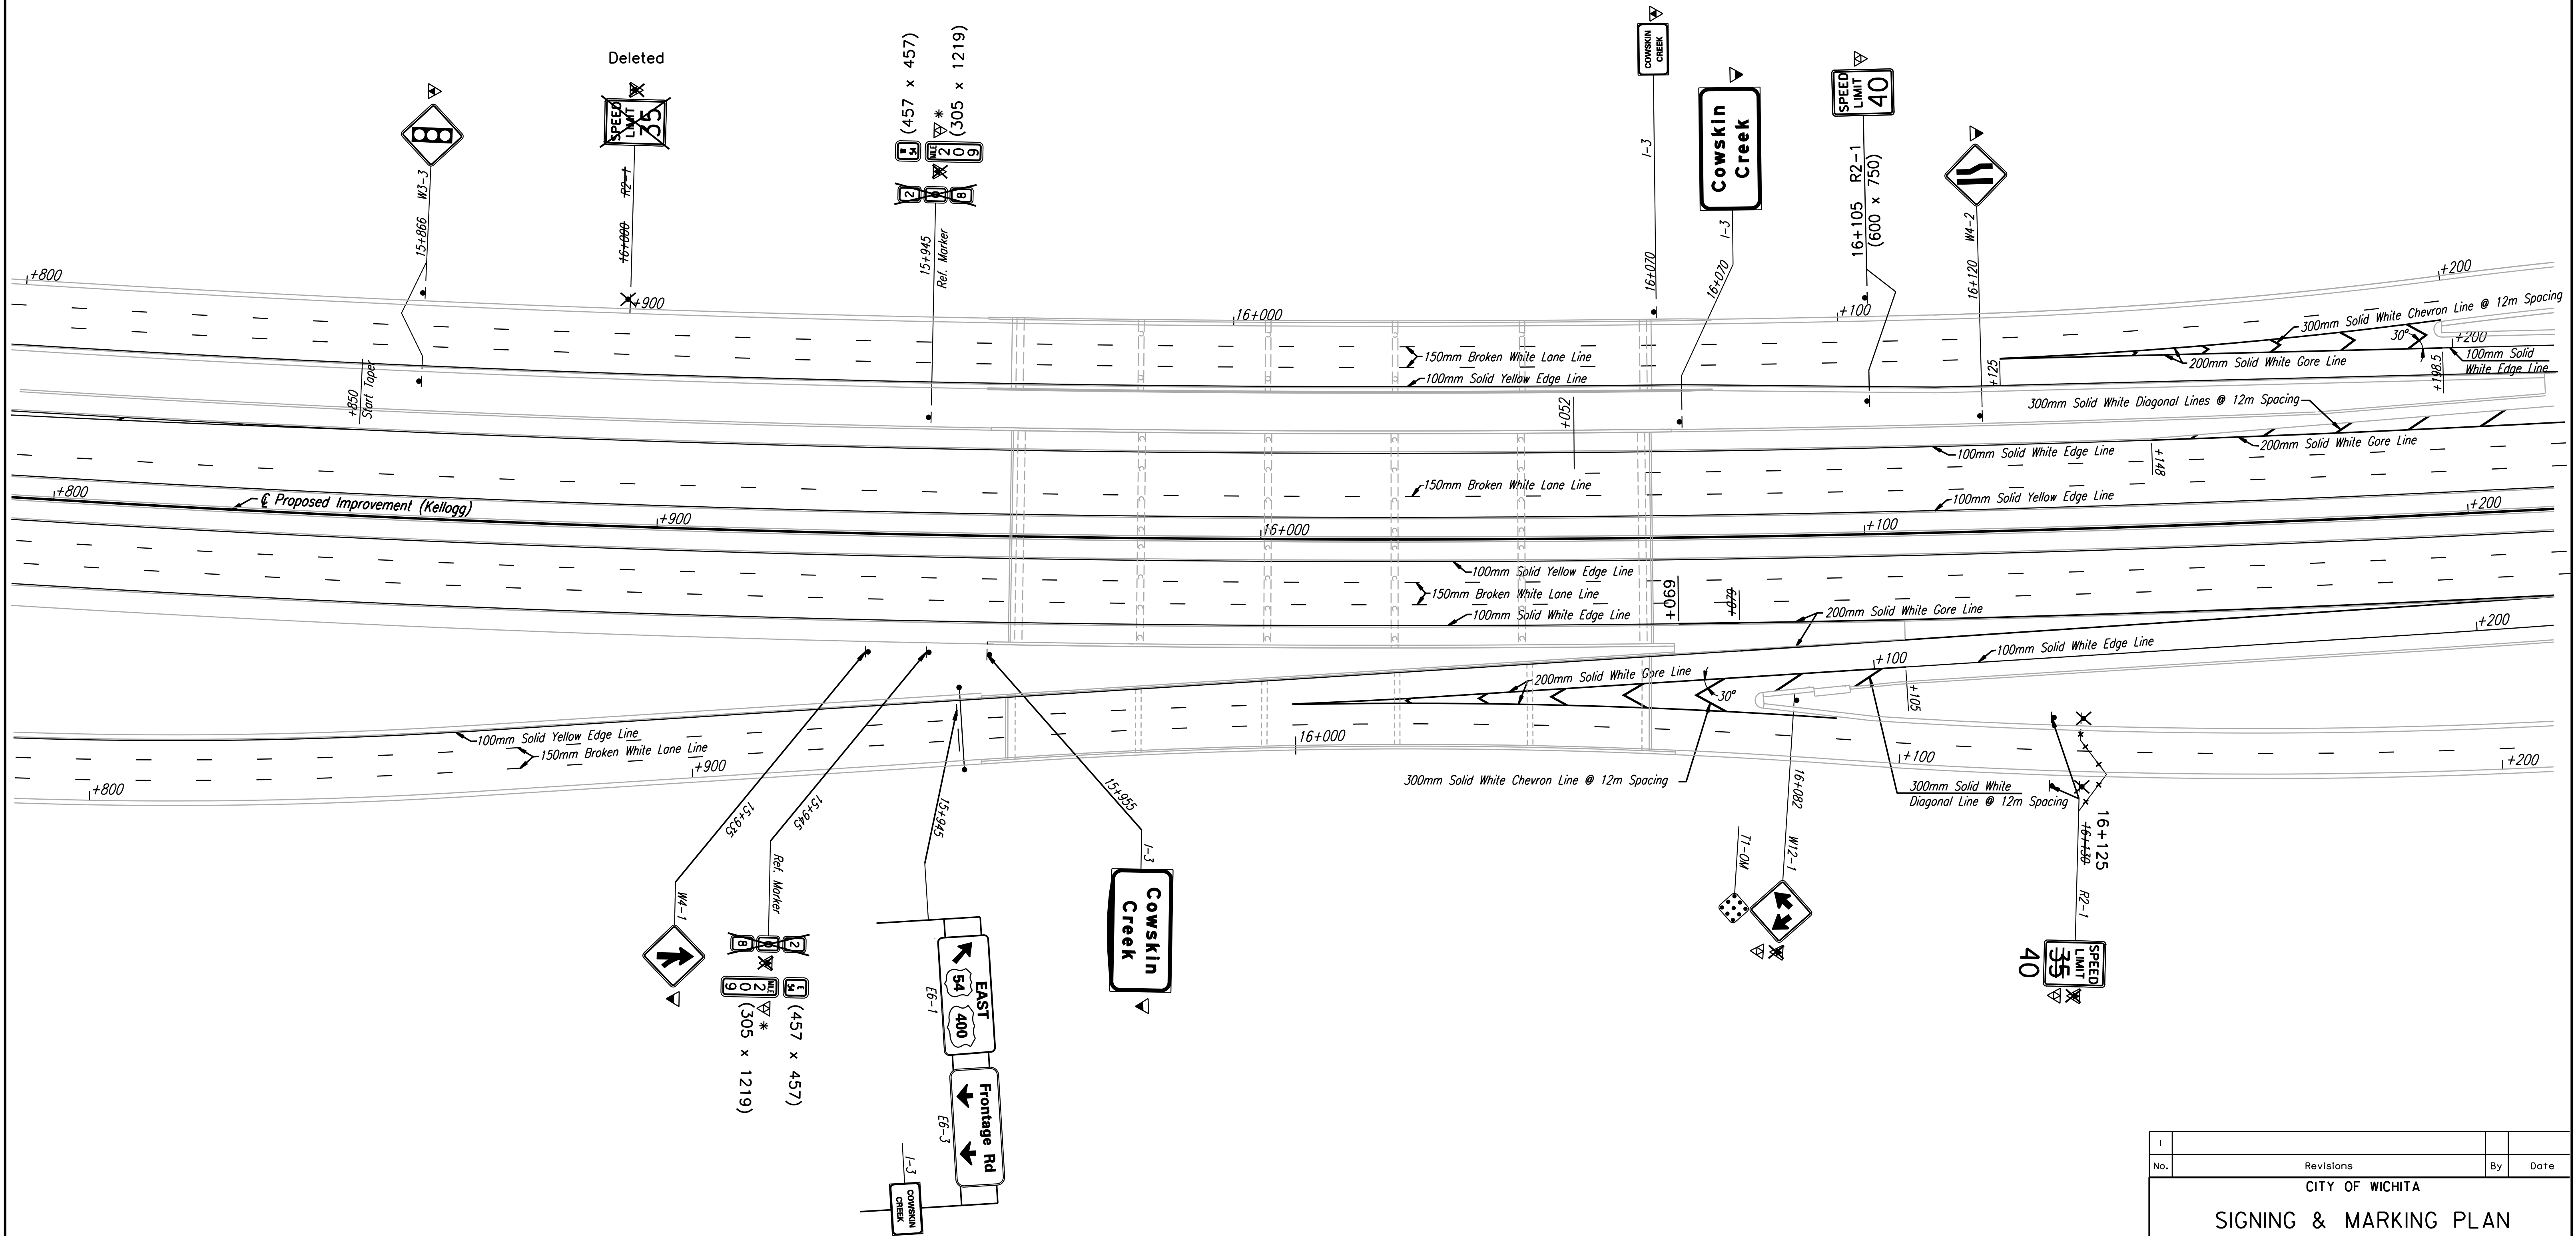

* Square Steel Post was mounted on the outside face of the MSE Wall Coping behind Concrete Safety Barrier.

RECORD DRAWING

No.	Revisions	By	Date

CITY OF WICHITA
SIGNING & MARKING PLAN
 STA. 15+800 TO STA. 16+200

SEDGWICK COUNTY

Professional Engineering Consultants, P.A.
 303 S. TOPEKA • WICHITA, KANSAS 67202
 316-262-2691 • FAX 316-262-3003

Designed by	RPG	Checked by	WDH
Drawn by	SVB	Date	April, 2002
		Job No.	97362