


FHWA REGION NO.	STATE	PROJECT NO.	YEAR	SHEET NO.	TOTAL SHEETS
7	KANSAS	54-87 K-6657-01	2002	689	1122

NOTE:
Install 150 mm Solid White Edge Lines (Pat. Cold Plastic) around all Islands, except don't install on paving brick at crosswalks.

DATE	
BY	
REFERENCES NOTED	
REFERENCES CHECKED	

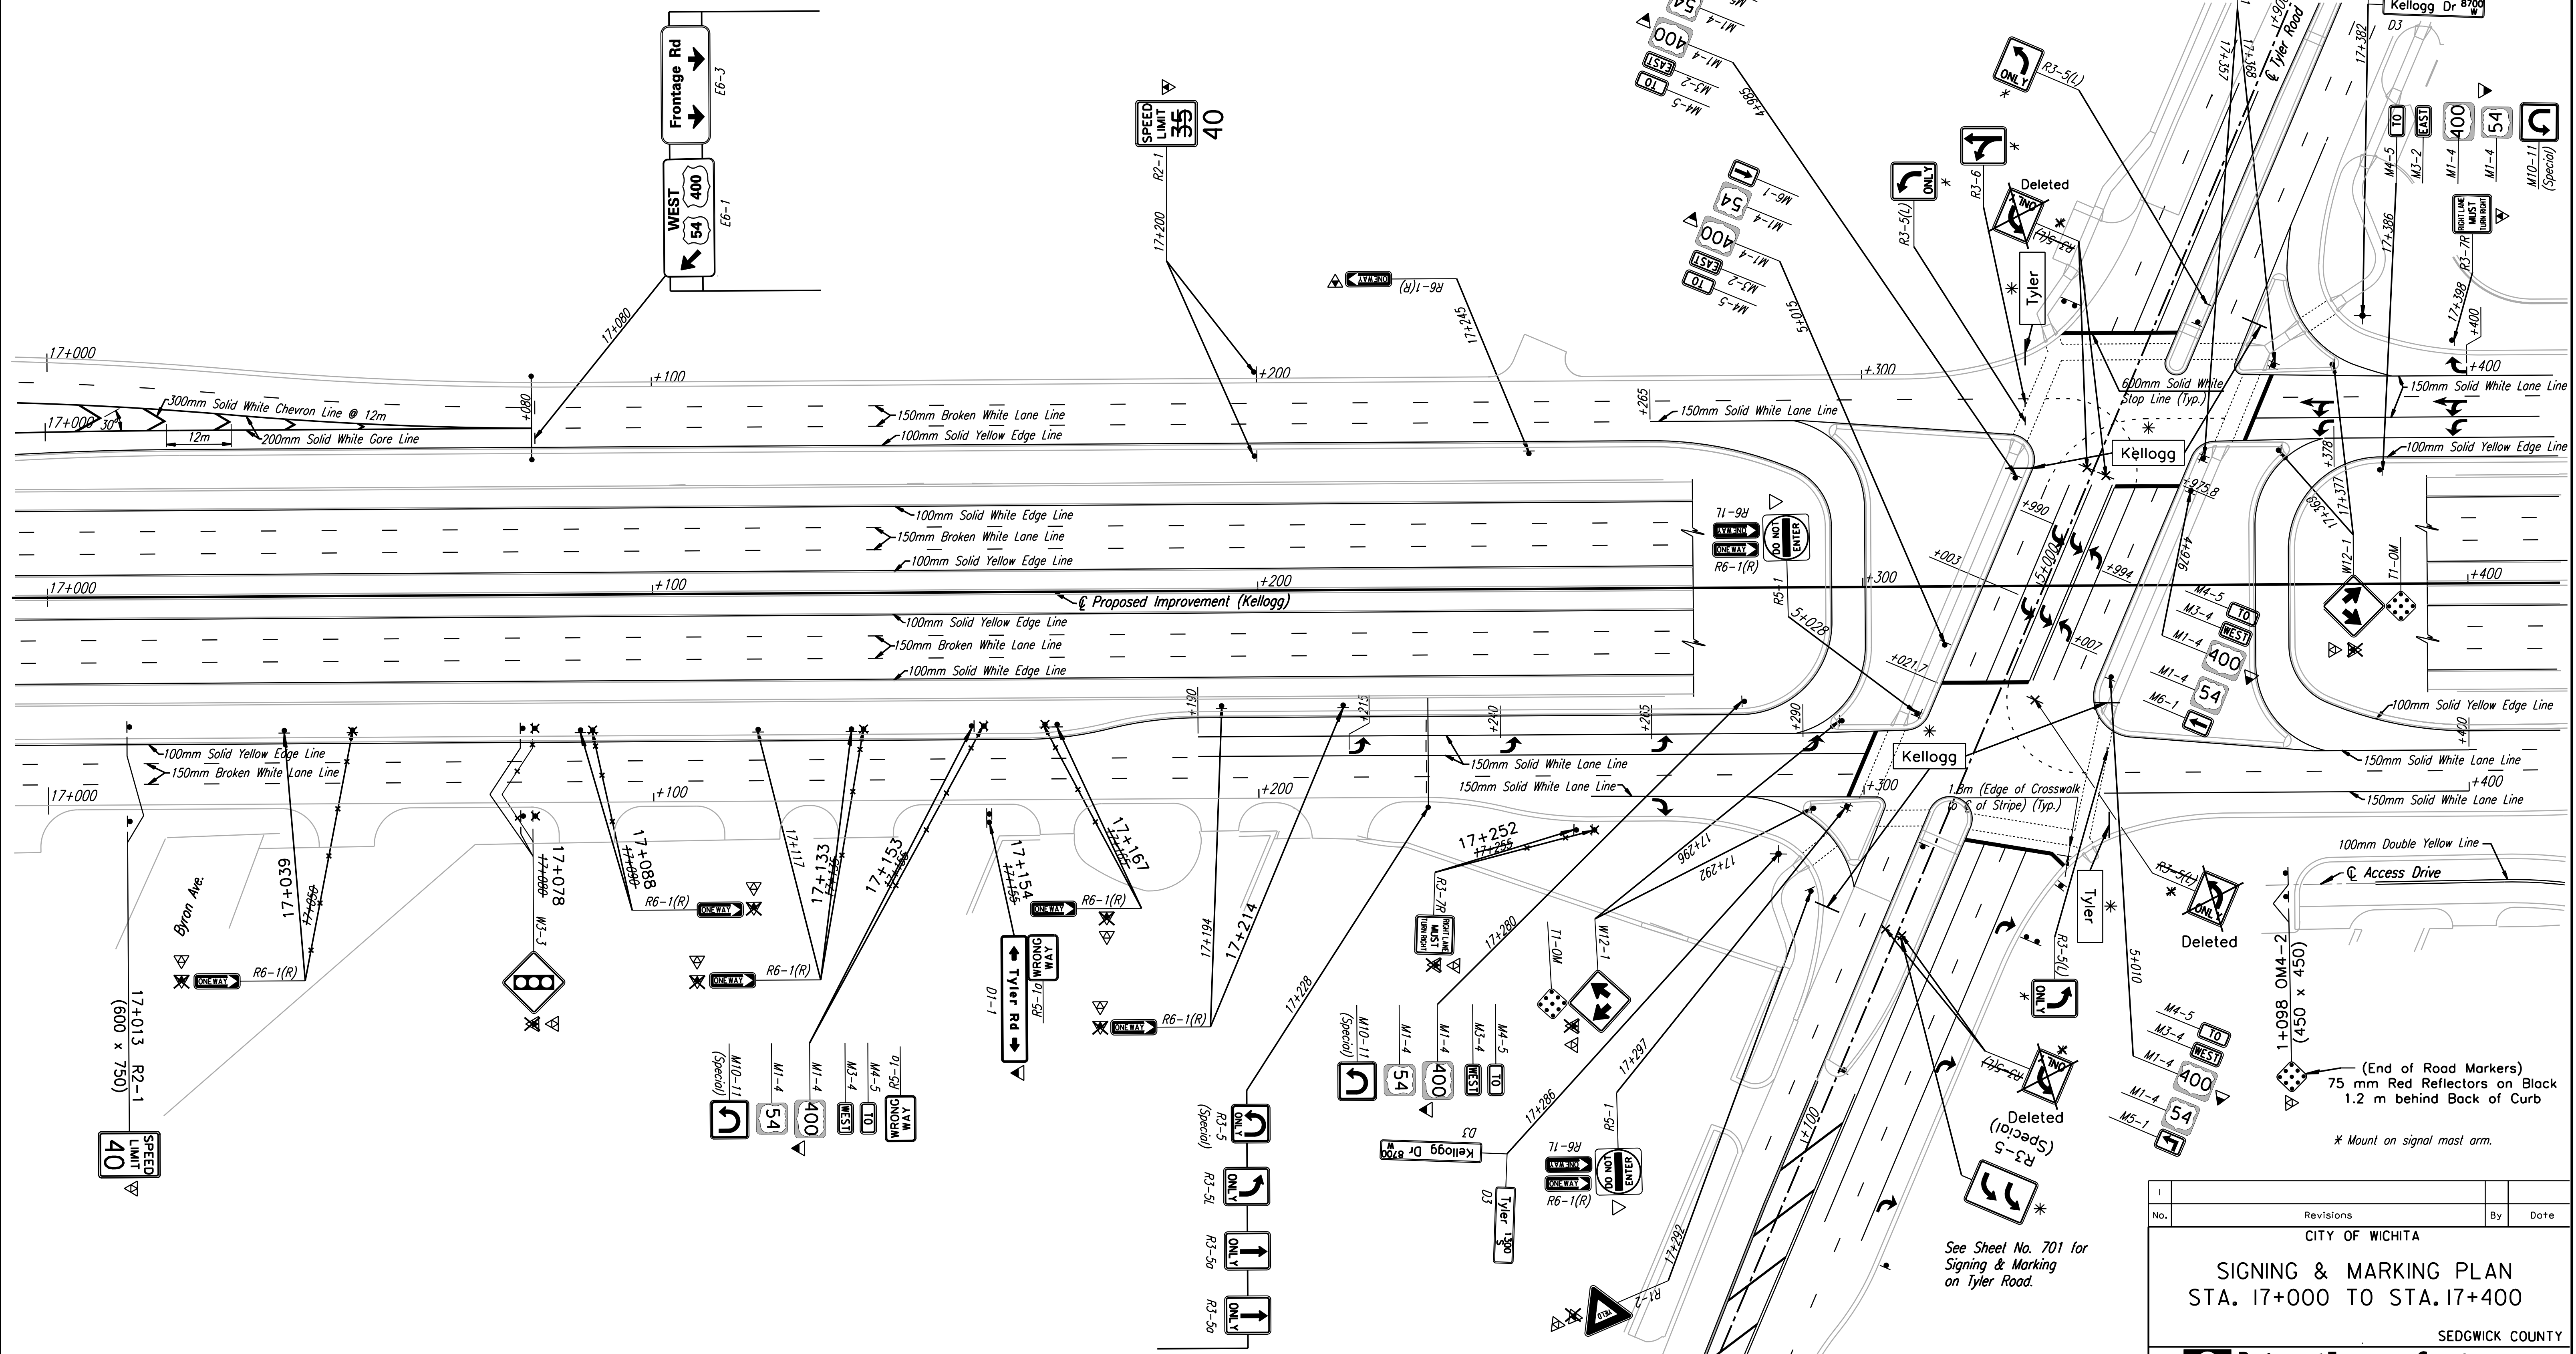

DSWR: WDH OPER: JGP SCALE: 1:500
 1/1997/97362/As-Built/dgn/s/Vol_4/5h 689-pl70.dgn Last Rev: 10-1-07 By: gdr

RECORD DRAWING

No.	Revisions	By	Date

CITY OF WICHITA

SIGNING & MARKING PLAN
STA. 17+000 TO STA. 17+400

SEDGWICK COUNTY

Professional Engineering Consultants, P.A.
 303 S. TOPEKA • WICHITA, KANSAS 67202
 316-262-2691 • FAX 316-262-3003

Designed by	RPG	Checked by	WDH
Drawn by	SVB	Date	Apr 11, 2002
		Job No.	97362