


| | |
|--------------------|--|
| DATE | |
| BY | |
| REFERENCES NOTED | |
| REFERENCES CHECKED | |

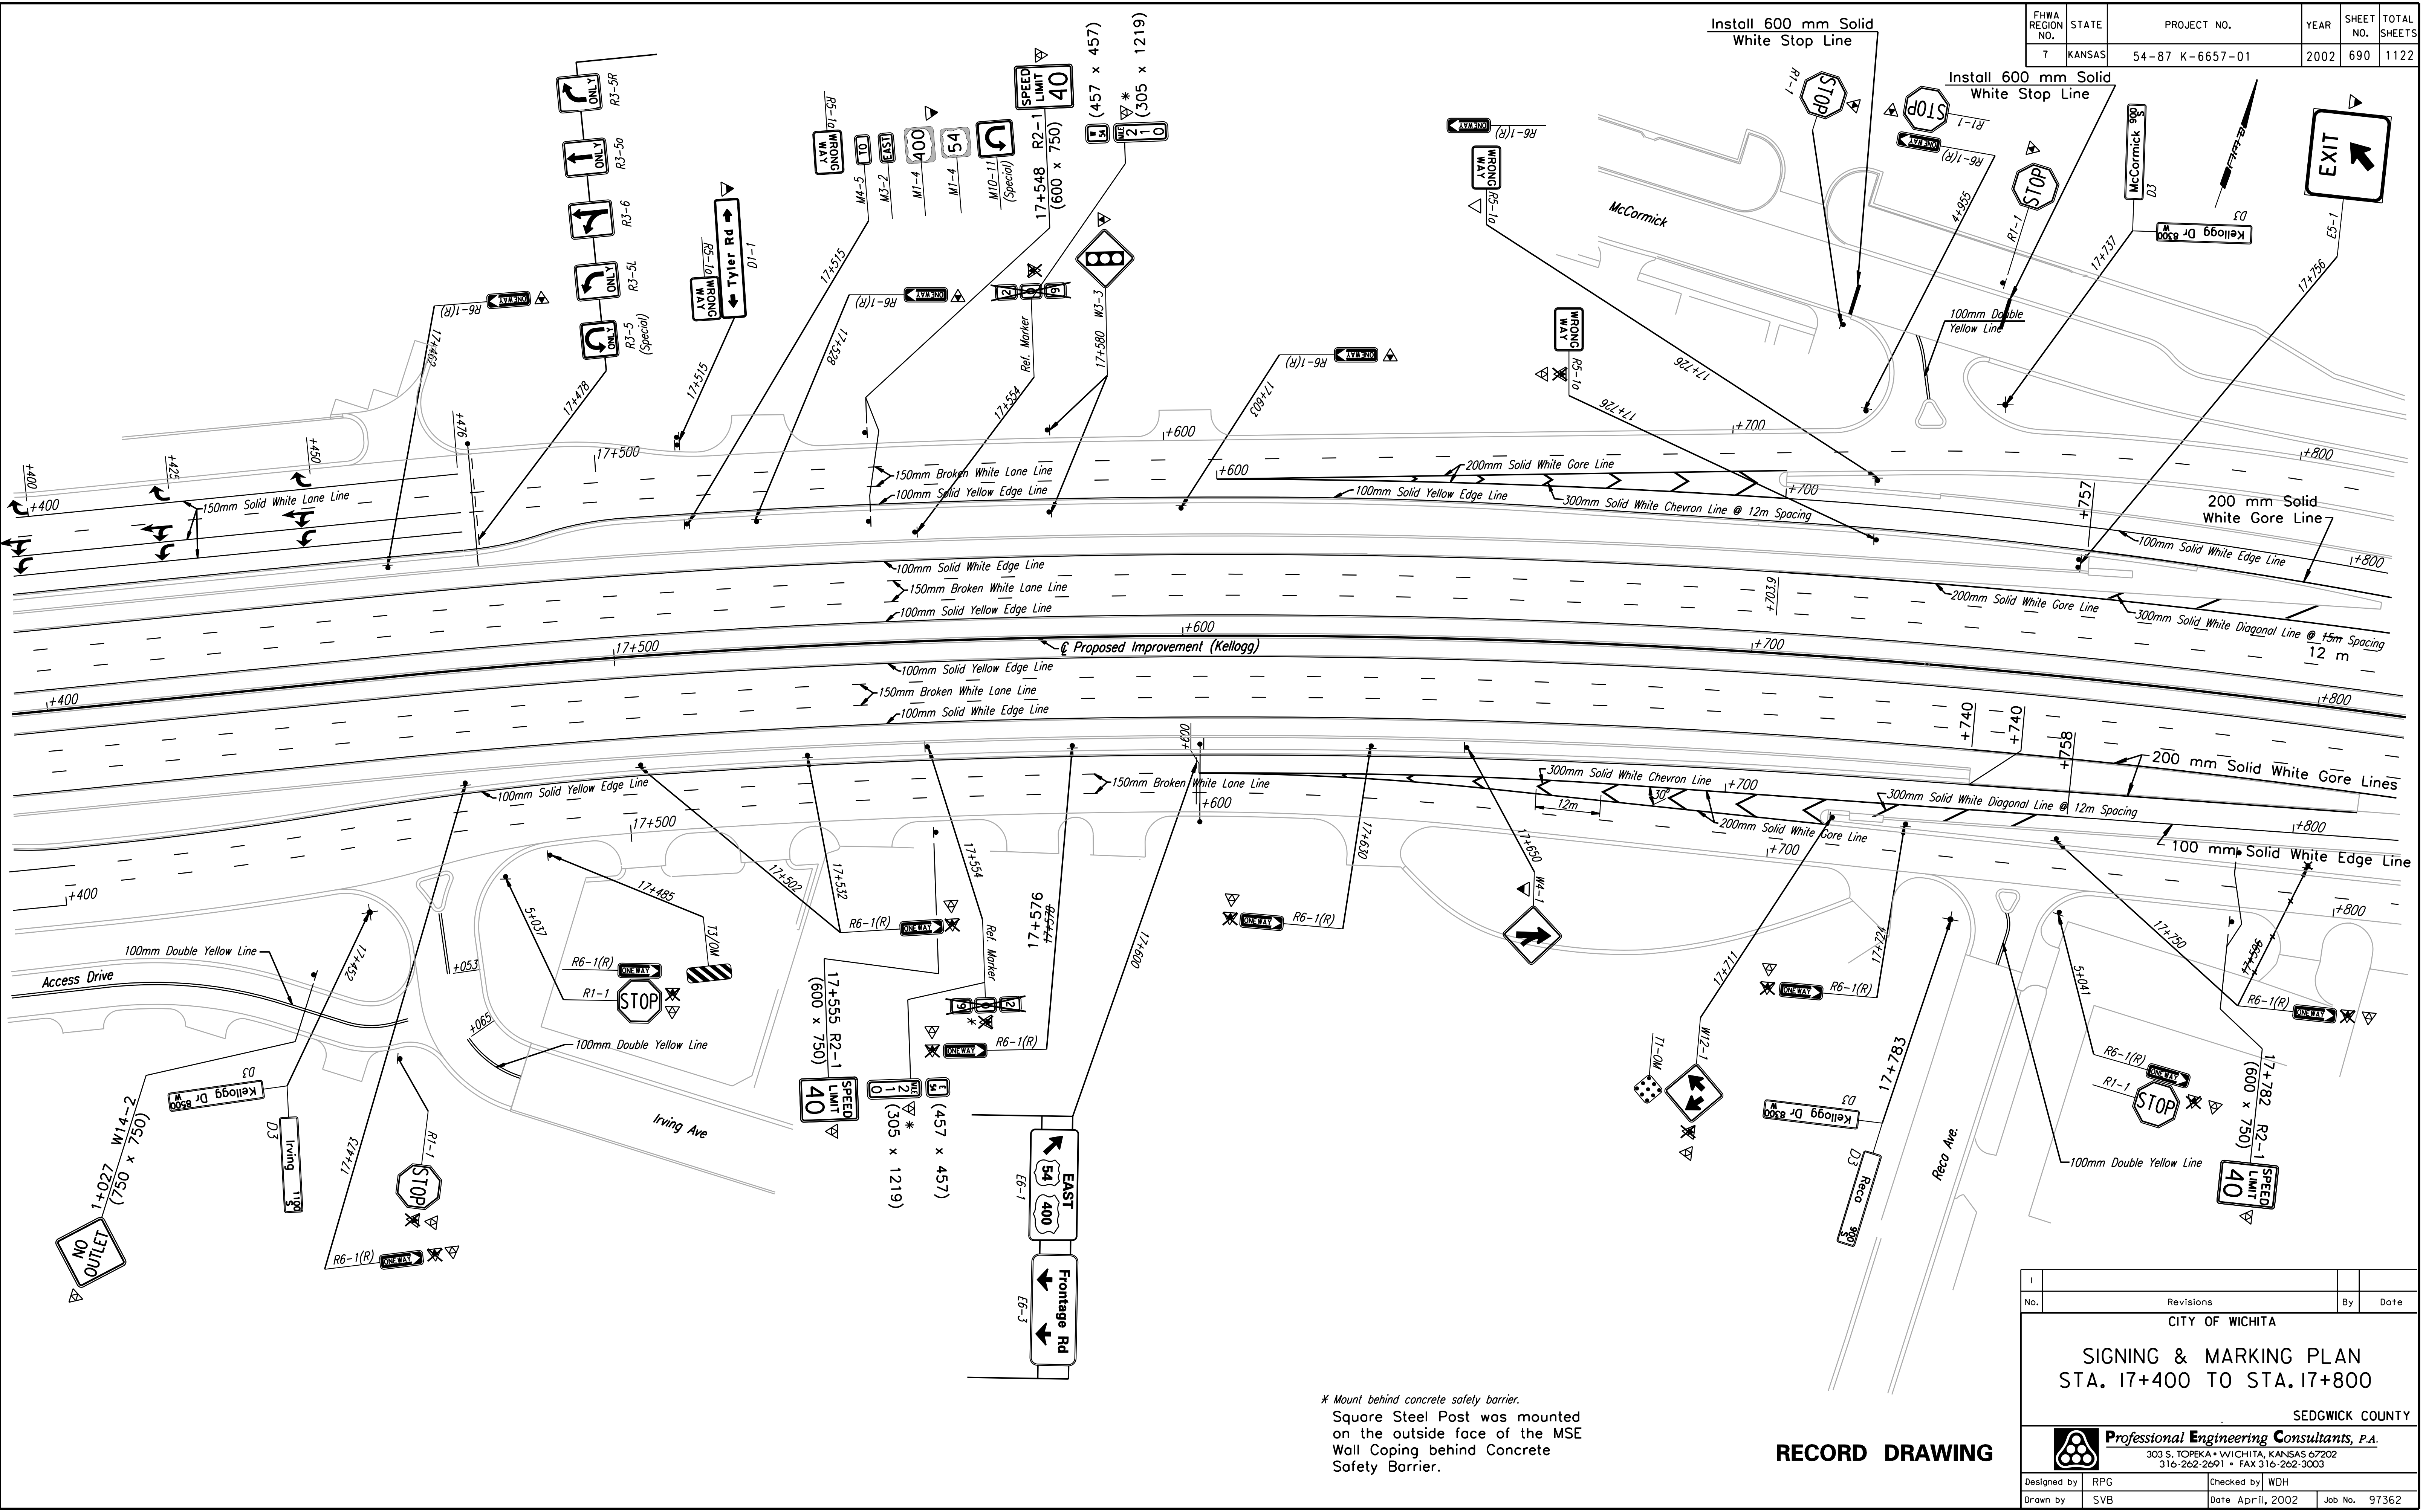

DSNR: WDH OPER: JGP SCALE: 1:500
 I:\1997\97362\As-Built\agn\Vol_47\Sh 690-pl174.dgn Last Rev: 10-1-07 By: gdr

* Mount behind concrete safety barrier.
 Square Steel Post was mounted on the outside face of the MSE Wall Coping behind Concrete Safety Barrier.

RECORD DRAWING

| | | | |
|-------------------------------------------------------------------------------------------------------------------------------|-----------|------------|-------------|
| No. | Revisions | By | Date |
| CITY OF WICHITA | | | |
| SIGNING & MARKING PLAN STA. 17+400 TO STA. 17+800 | | | |
| SEDGWICK COUNTY | | | |
| Professional Engineering Consultants, P.A. 303 S. TOPEKA • WICHITA, KANSAS 67202 316-262-2691 • FAX 316-262-3003 | | | |
| Designed by | RPG | Checked by | WDH |
| Drawn by | SVB | Date | April, 2002 |
| | | Job No. | 97362 |