


FHWA REGION NO.	STATE	PROJECT NO.	YEAR	SHEET NO.	TOTAL SHEETS
7	KANSAS	54-87 K-6657-01	2002	693	1122

DATE	BY
REFERENCES NOTED	REFERENCES CHECKED

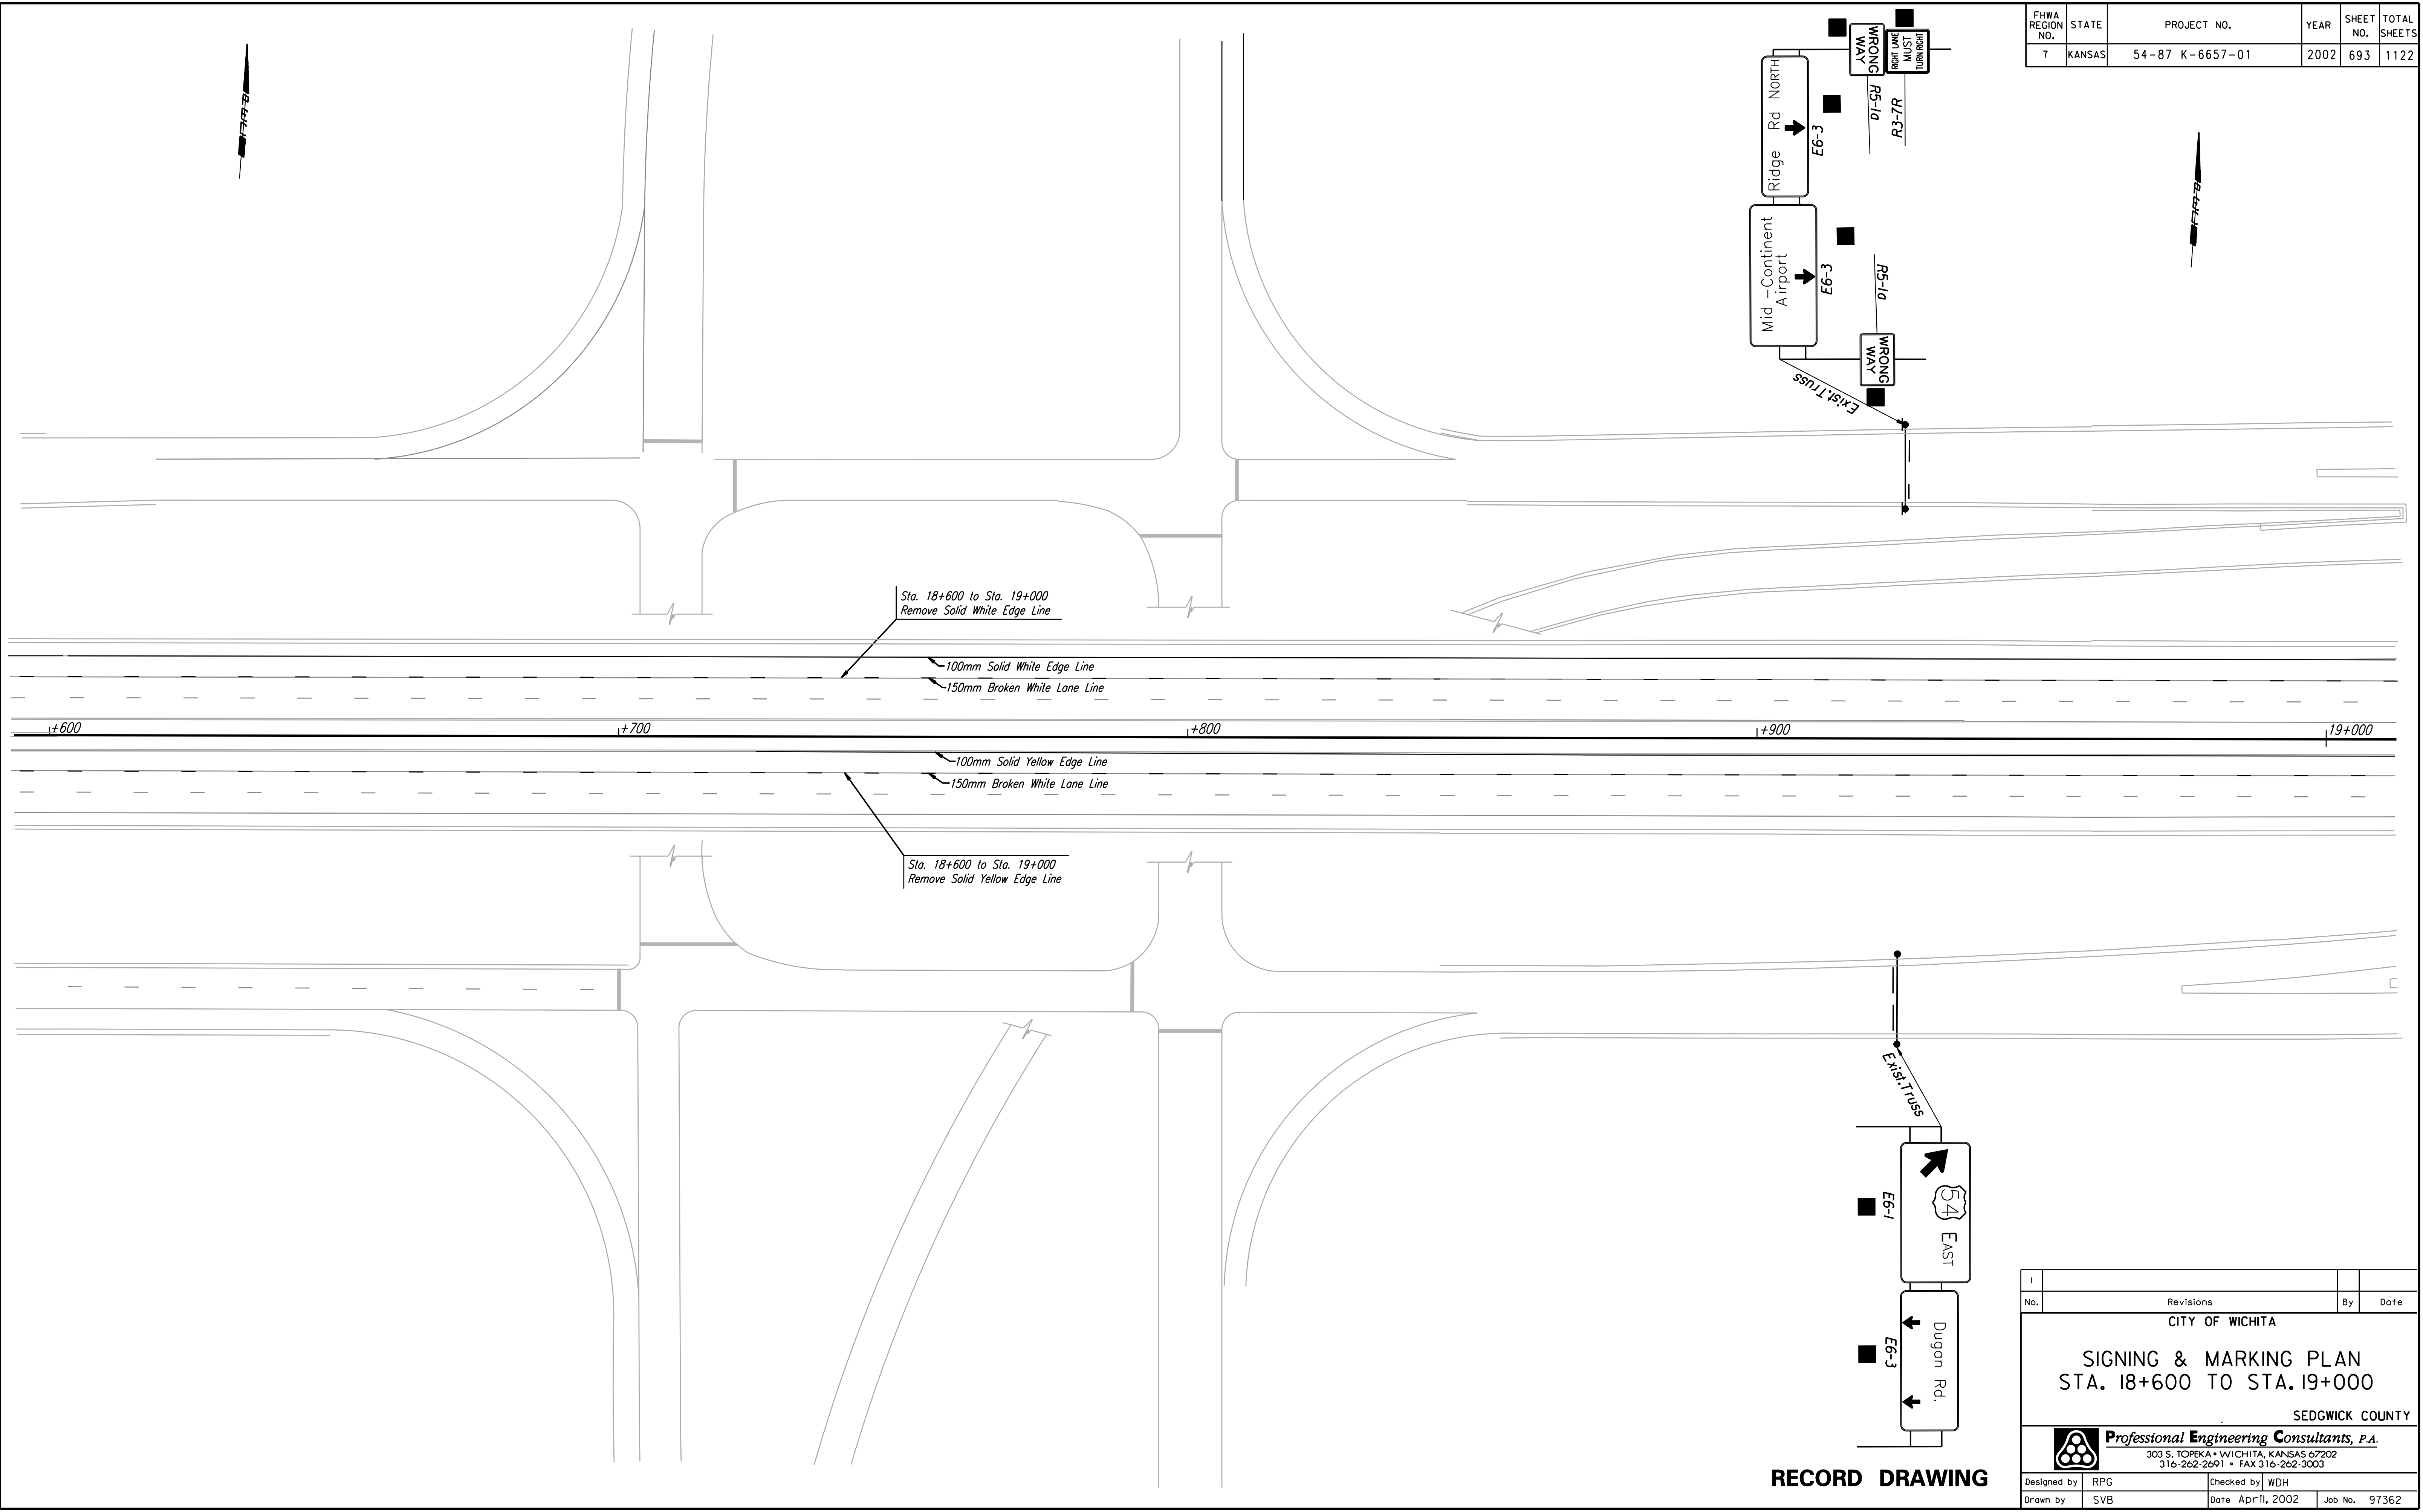

Sta. 18+600 to Sta. 19+000  
Remove Solid White Edge Line

100mm Solid White Edge Line  
150mm Broken White Lane Line

100mm Solid Yellow Edge Line  
150mm Broken White Lane Line

Sta. 18+600 to Sta. 19+000  
Remove Solid Yellow Edge Line

**RECORD DRAWING**

DSWR: WDH OPER: JGP SCALE: 1:500  
 1/1997/97362/As-Built/sgn/101\_4/Sh 693-pl186.dgn Last Rev: 10-2-07 By: gdr

No.	Revisions	By	Date

CITY OF WICHITA

**SIGNING & MARKING PLAN**  
STA. 18+600 TO STA. 19+000

SEDGWICK COUNTY

**Professional Engineering Consultants, P.A.**  
 303 S. TOPEKA • WICHITA, KANSAS 67202  
 316-262-2691 • FAX 316-262-3003

Designed by	RPG	Checked by	WDH
Drawn by	SVB	Date	April, 2002
		Job No.	97362