



FHWA REGION NO.	STATE	PROJECT NO.	YEAR	SHEET NO.	TOTAL SHEETS
7	KANSAS	54-87 K-6657-01	2002	694	1122

DATE	BY
REFERENCES NOTED	REFERENCES CHECKED

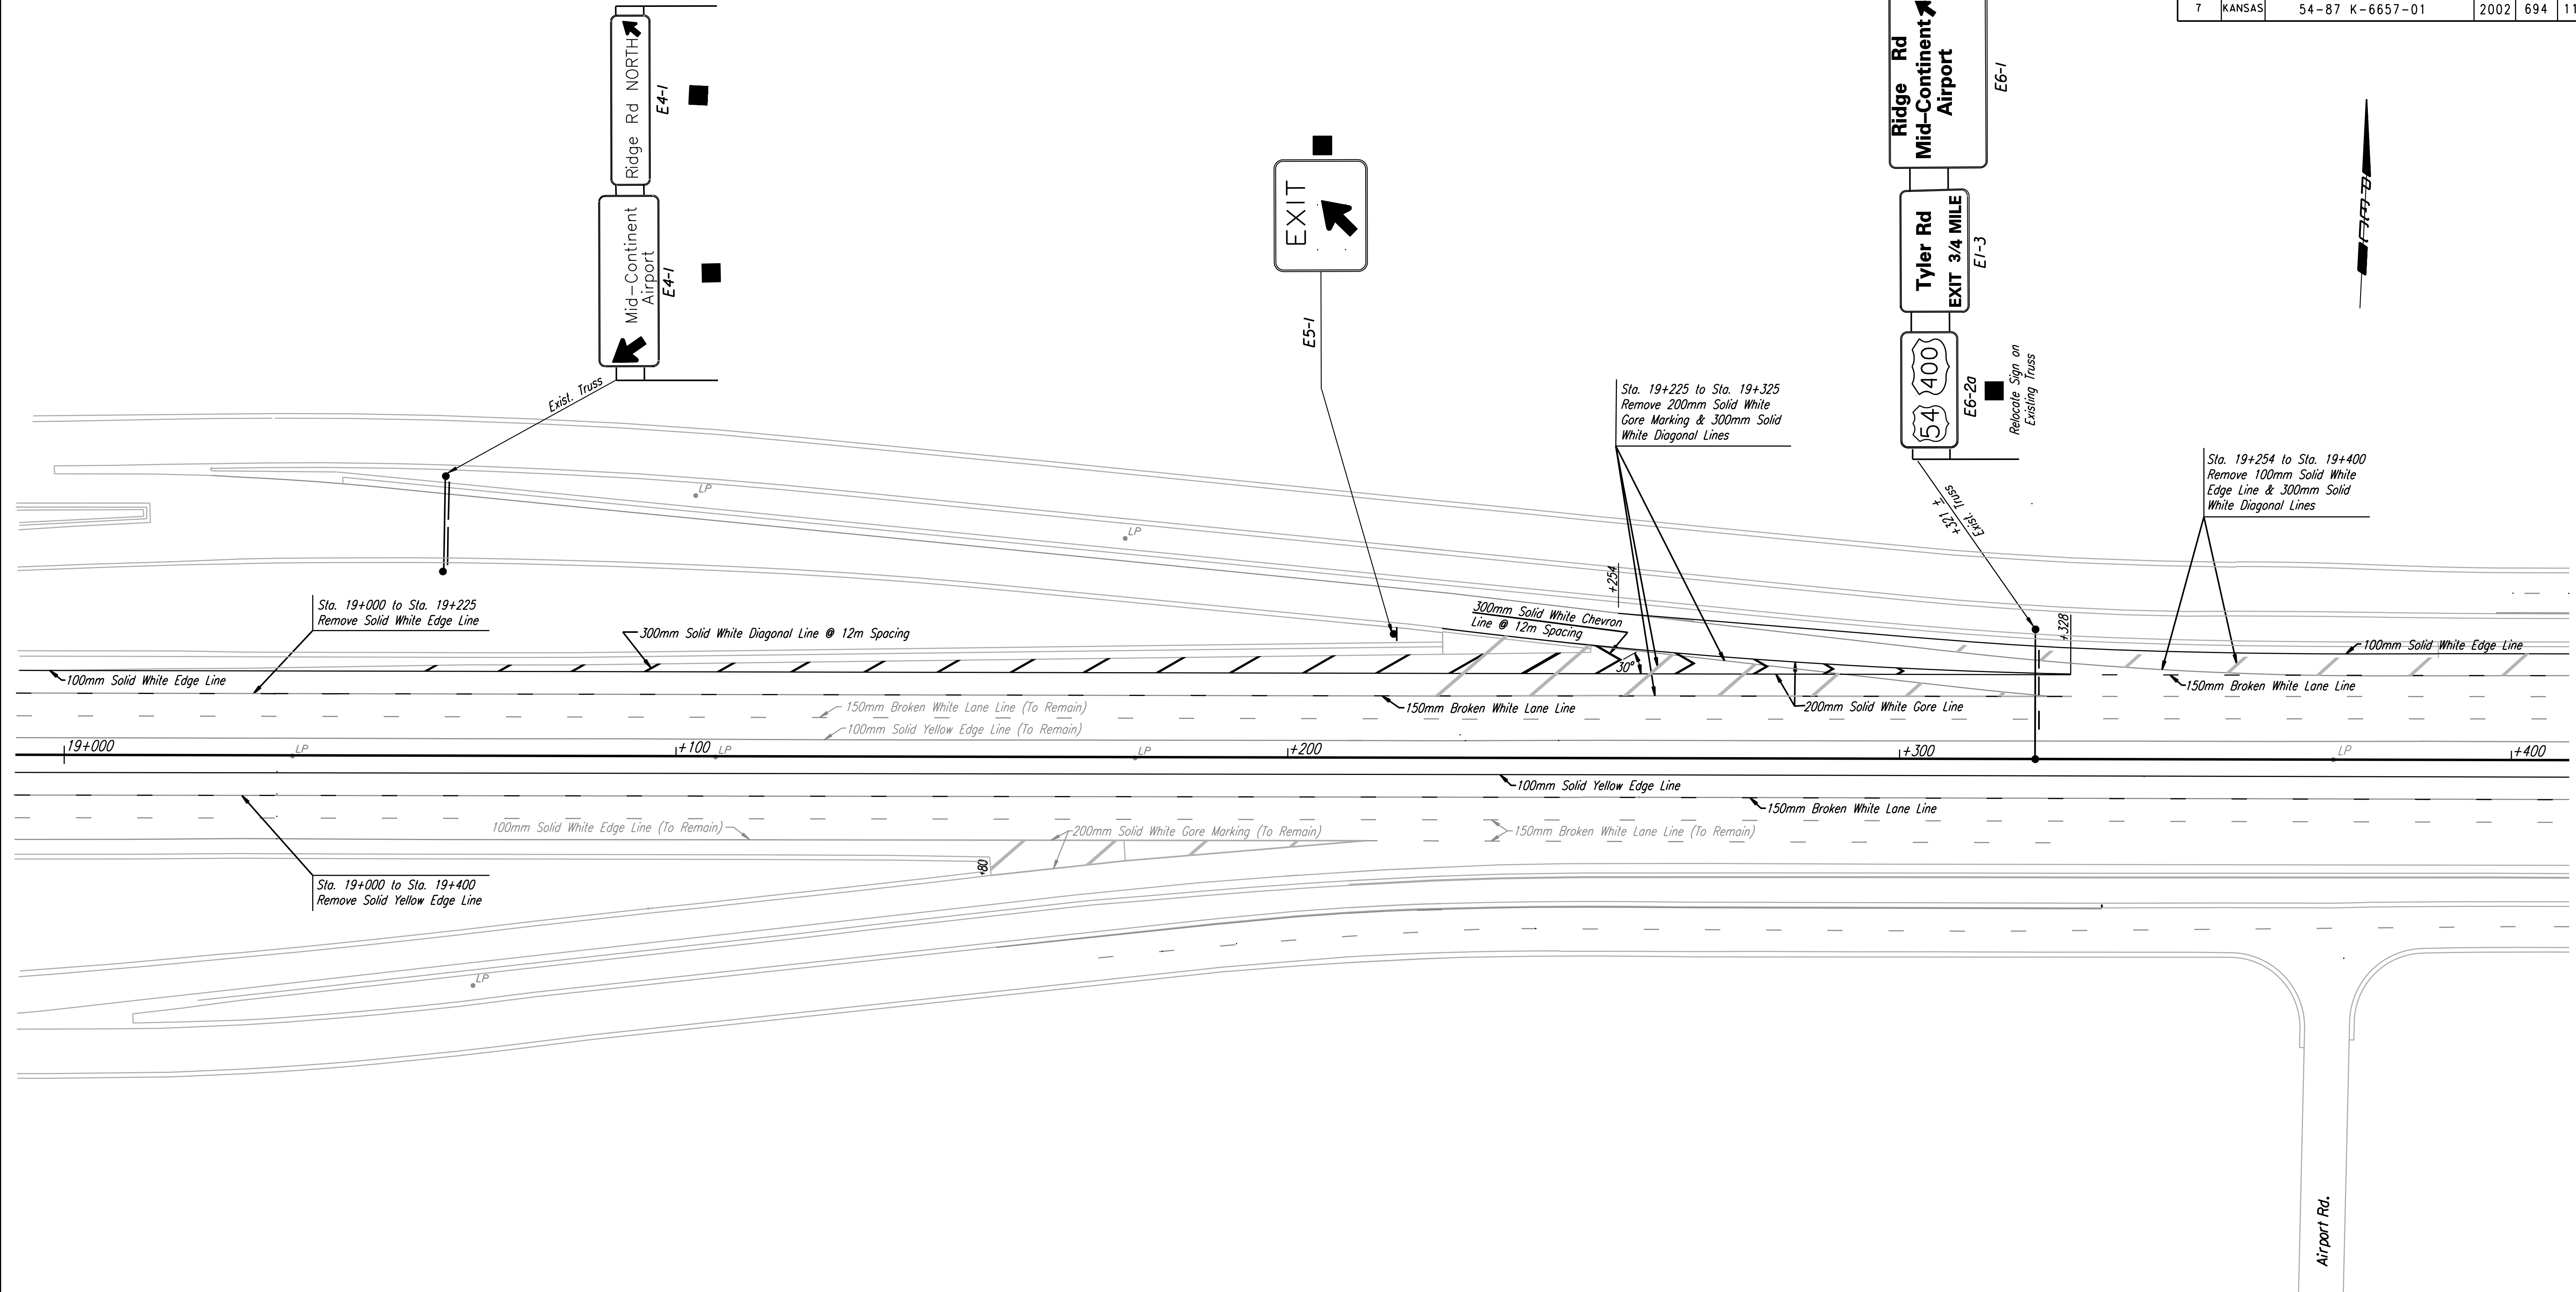

DSNR: WDH OPER: JGP SCALE: 1:500
 12/1997/97-362/As-Builts/dgms/Vol_4/Sh 694-pl190.dgn Last Rev: 10-2-07 By: gdr

RECORD DRAWING

1			
No.	Revisions	By	Date
CITY OF WICHITA			
SIGNING & MARKING PLAN STA. 19+000 TO STA. 19+400			
SEDGWICK COUNTY			
 Professional Engineering Consultants, P.A. <small>303 S. TOPEKA • WICHITA, KANSAS 67202 316-262-2691 • FAX 316-262-3003</small>			
Designed by	RPG	Checked by	WDH
Drawn by	SVB	Date	April, 2002
		Job No.	97362