


FHWA REGION NO.	STATE	PROJECT NO.	YEAR	SHEET NO.	TOTAL SHEETS
7	KANSAS	54-87 K-6657-01	2002	695	1122

DATE	
BY	
REFERENCES NOTED	
REFERENCES CHECKED	

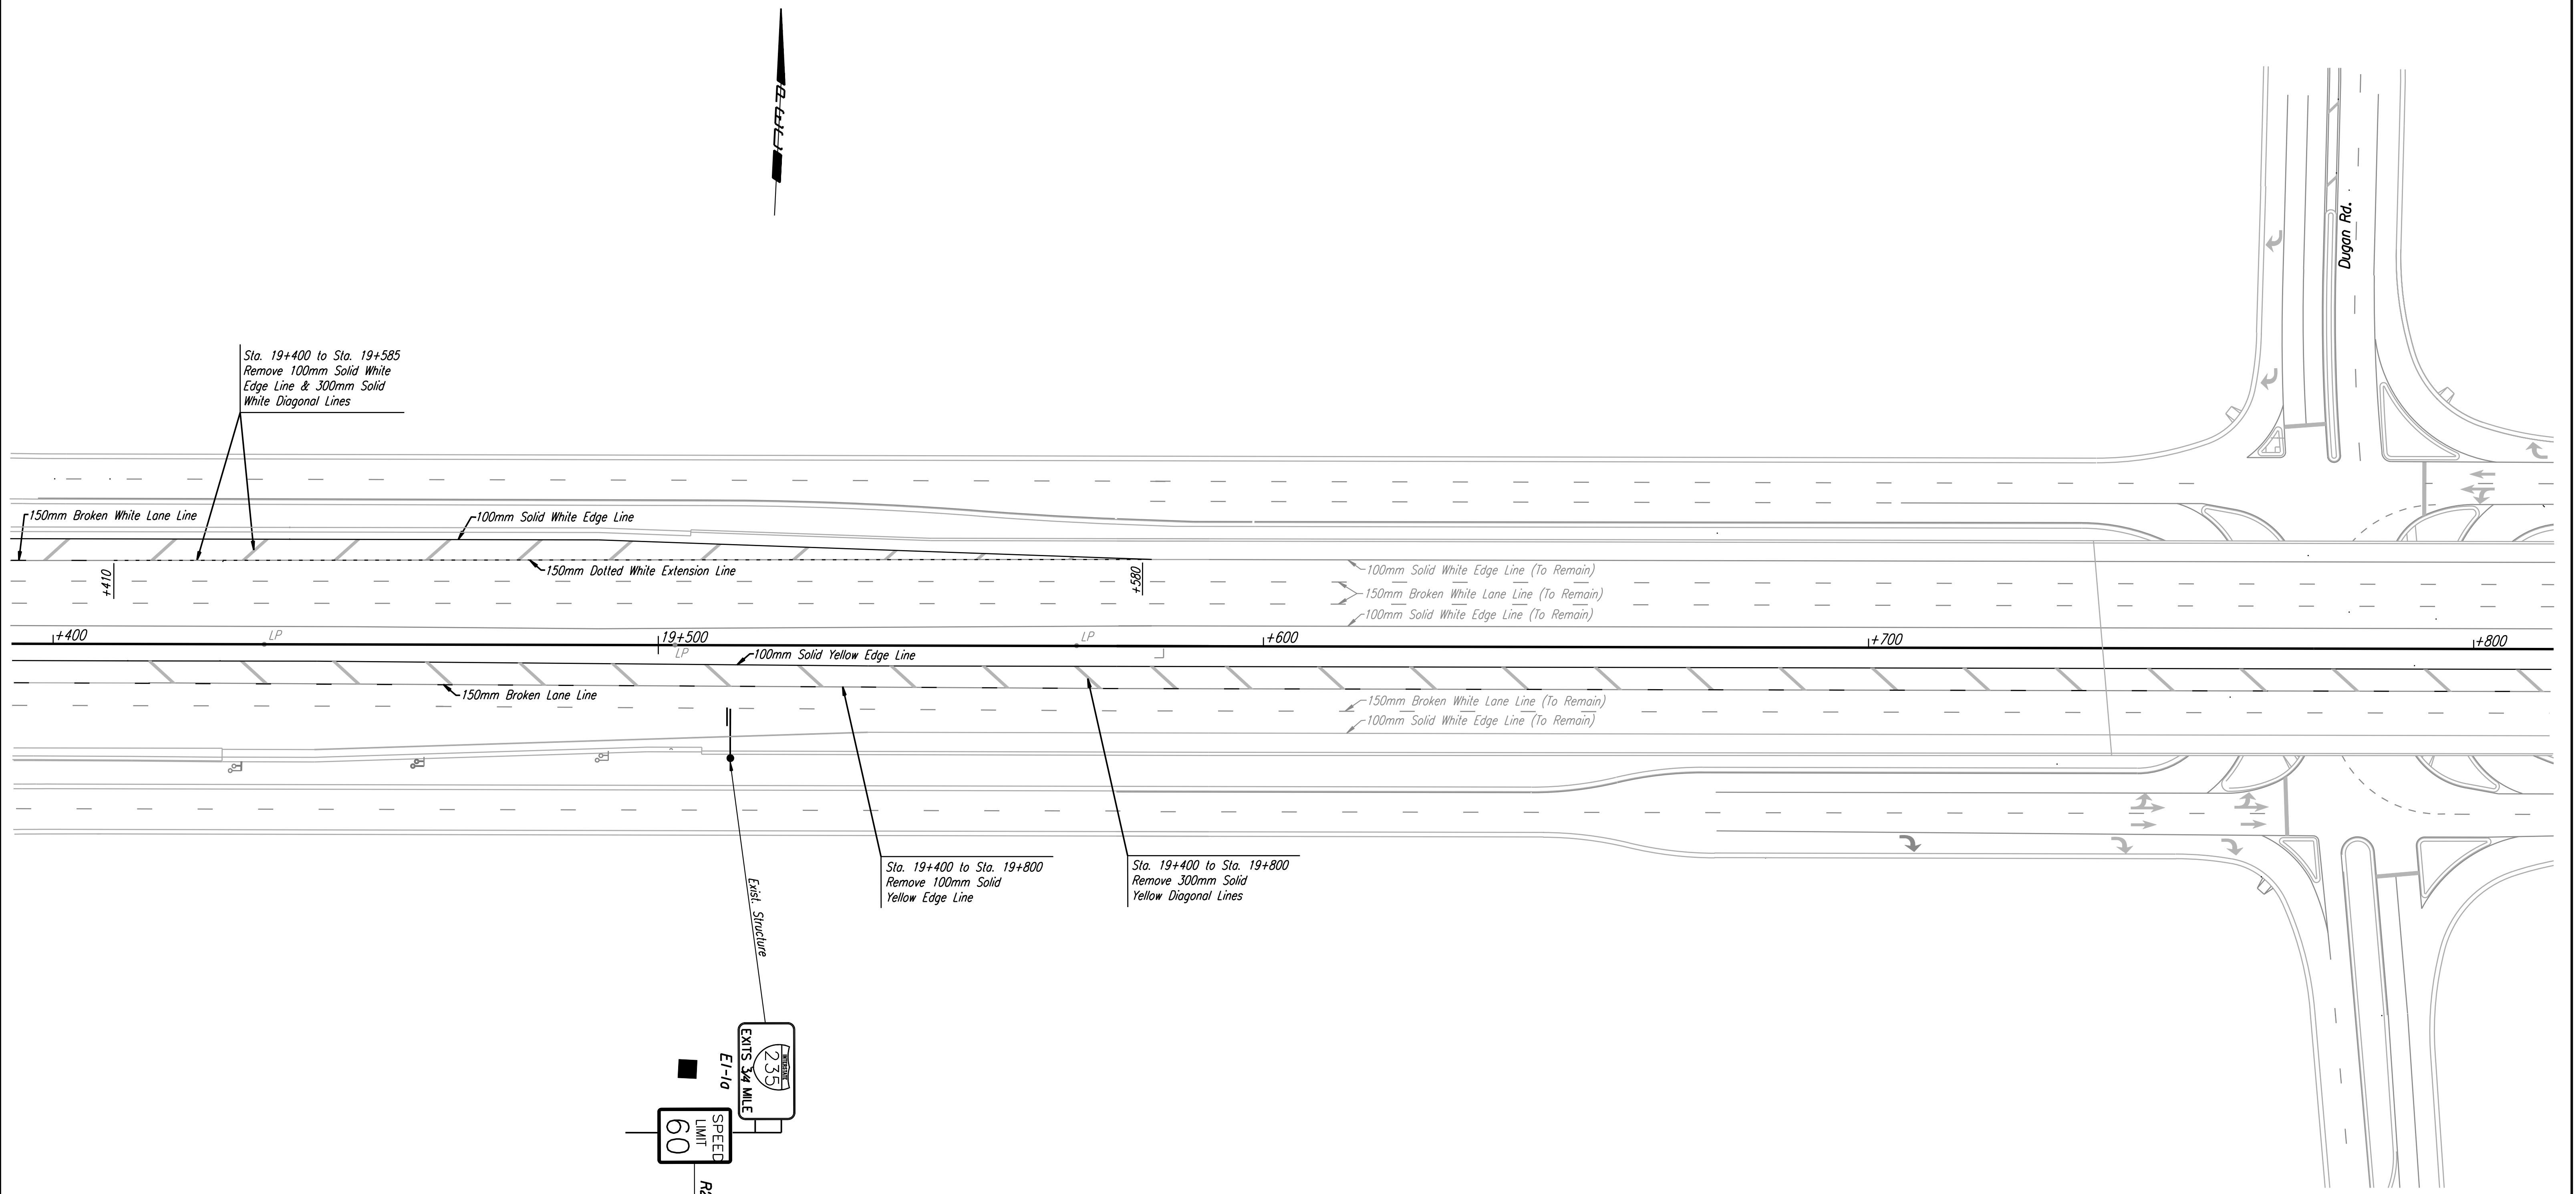

DSMR: WDH OPER: JGP SCALE: 1:500  
 I:/1997/97362/As-Builts/dgns/No\_4/S1\_695-pl194.dgn Last Rev: 10-2-07 By: gdr

**RECORD DRAWING**

No.	Revisions	By	Date
CITY OF WICHITA			
SIGNING & MARKING PLAN STA. 19+400 TO STA. 19+800			
SEDGWICK COUNTY			
<b>Professional Engineering Consultants, P.A.</b> <small>303 S. TOPEKA • WICHITA, KANSAS 67202 316-262-2691 • FAX 316-262-3003</small>			
Designed by	RPG	Checked by	WDH
Drawn by	SVB	Date	April, 2002 Job No. 97362