


FHWA REGION NO.	STATE	PROJECT NO.	YEAR	SHEET NO.	TOTAL SHEETS
7	KANSAS	54-87 K-6657-01	2002	697	1122

DATE	BY	REFERENCES NOTED	REFERENCES CHECKED

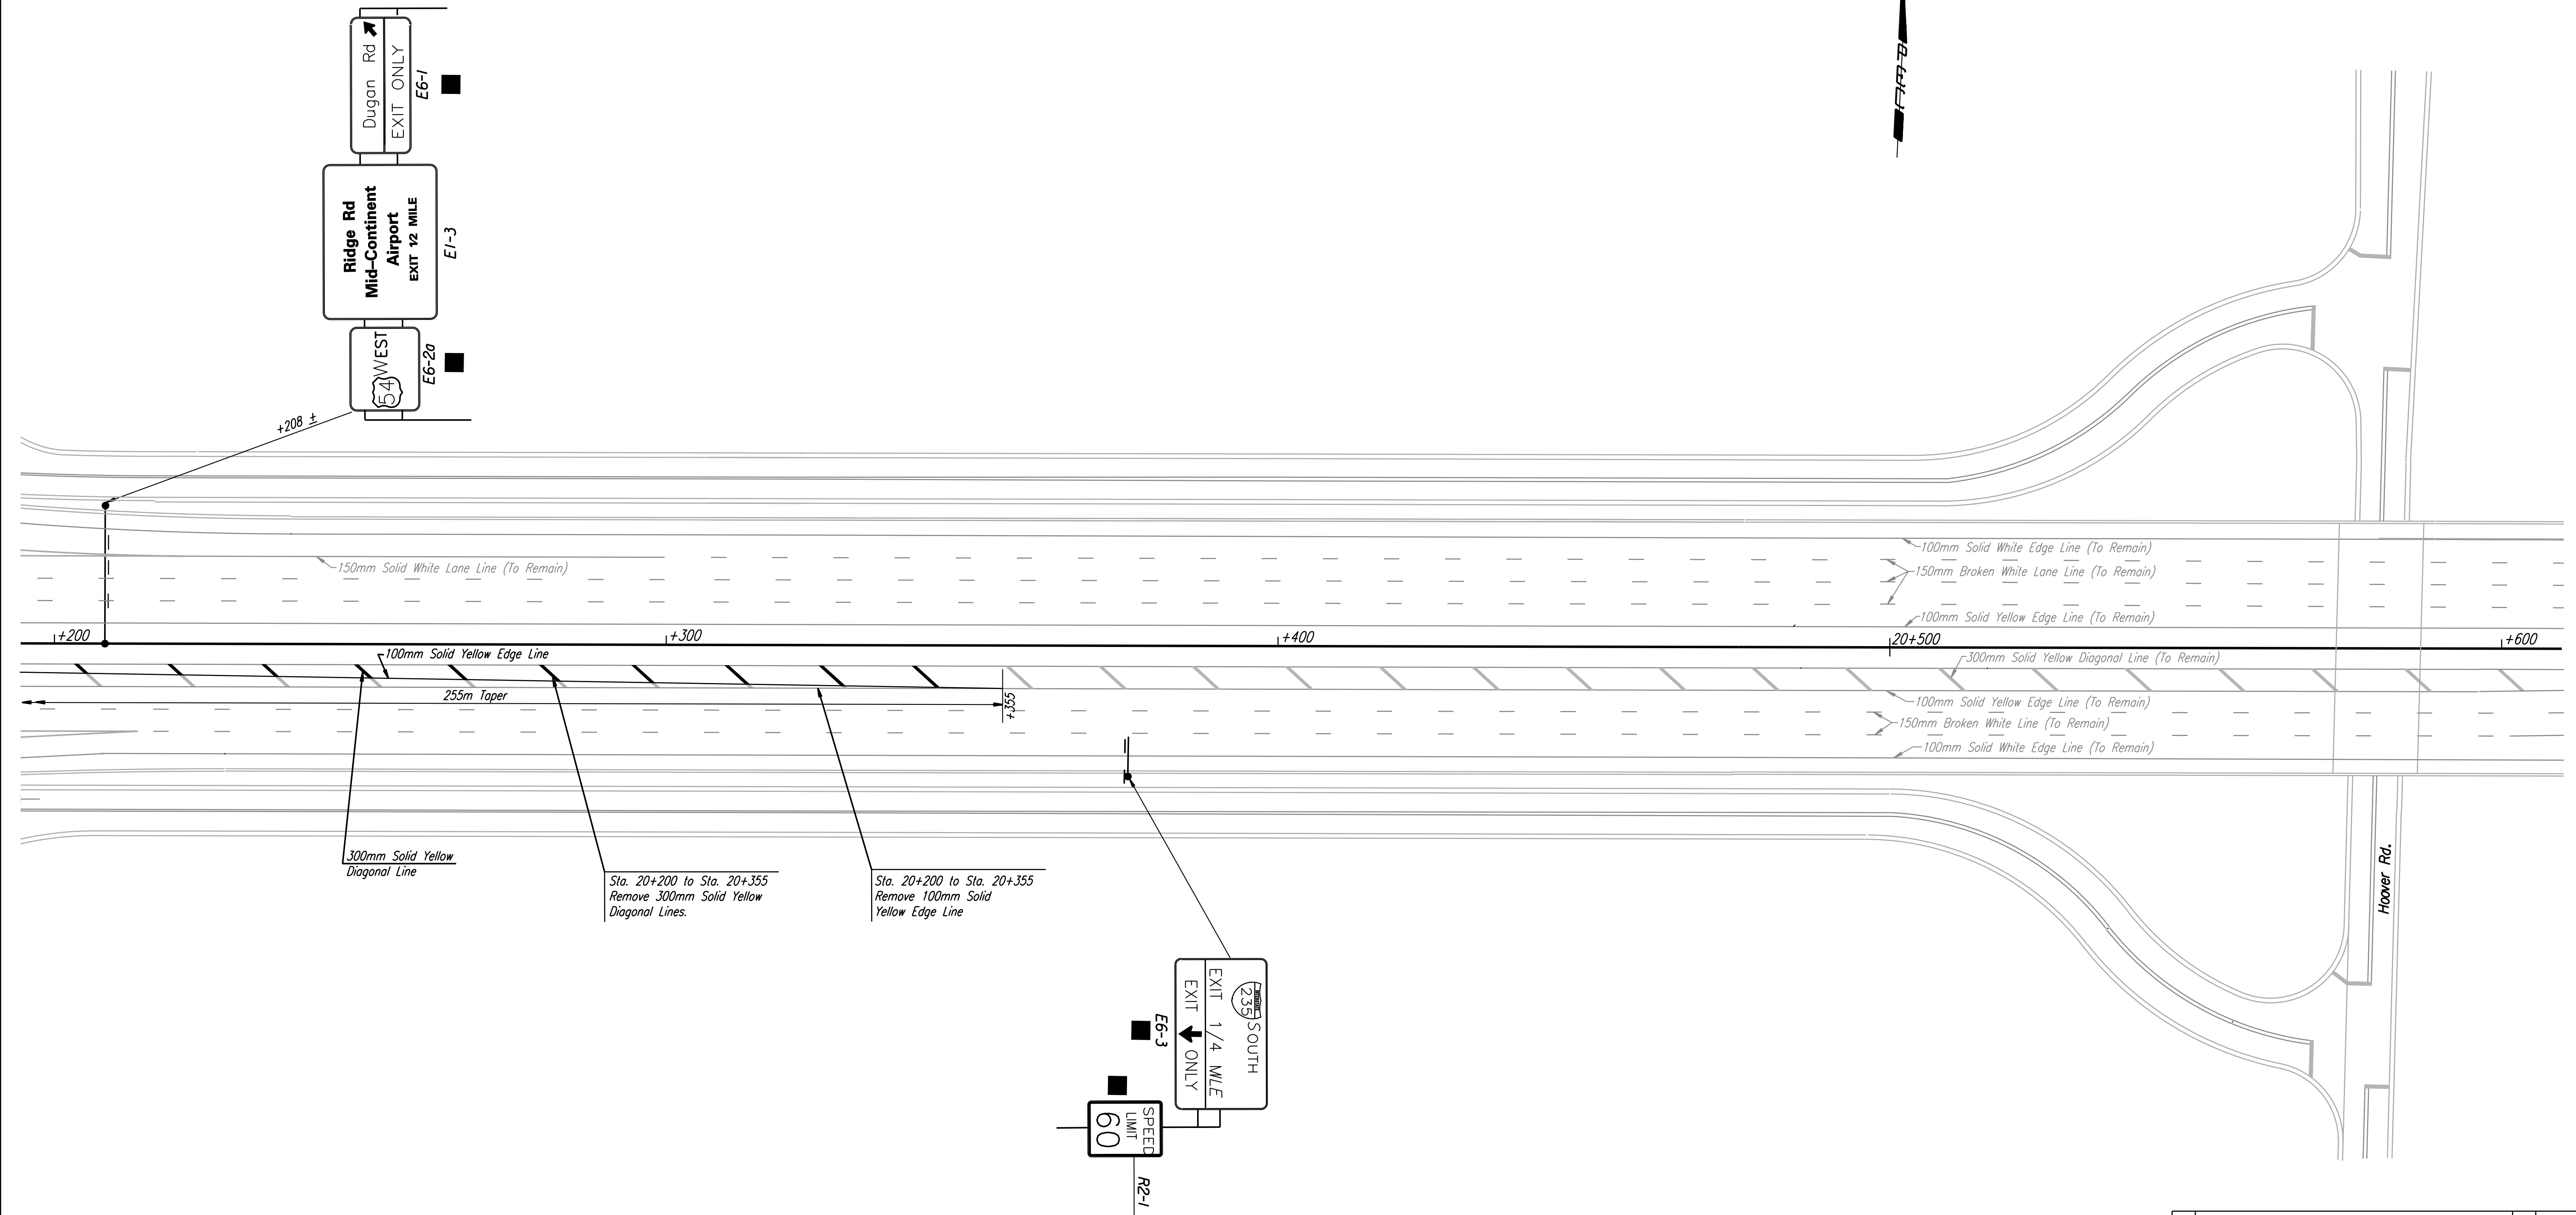

Sta. 20+200 to Sta. 20+355  
Remove 300mm Solid Yellow Diagonal Lines.

Sta. 20+200 to Sta. 20+355  
Remove 100mm Solid Yellow Edge Line

100mm Solid White Edge Line (To Remain)

150mm Broken White Lane Line (To Remain)

100mm Solid Yellow Edge Line (To Remain)

300mm Solid Yellow Diagonal Line (To Remain)

100mm Solid Yellow Edge Line (To Remain)

150mm Broken White Line (To Remain)

100mm Solid White Edge Line (To Remain)

DSNR: WDH OPER: JGP SCALE: 1:500  
 11/1997/97-362/As-Builts/dgn's/Vol\_4/Sh 697-pl202.dgn Last Rev: 10-2-07 By: gdr

**RECORD DRAWING**

No.	Revisions	By	Date

CITY OF WICHITA

**SIGNING & MARKING PLAN**  
STA. 20+200 TO STA. 20+355

SEDGWICK COUNTY

**Professional Engineering Consultants, P.A.**  
 303 S. TOPEKA • WICHITA, KANSAS 67202  
 316-262-2691 • FAX 316-262-3003

Designed by	RPG	Checked by	WDH
Drawn by	SVB	Date	April, 2002
		Job No.	97362