


FHWA REGION NO.	STATE	PROJECT NO.	YEAR	SHEET NO.	TOTAL SHEETS
7	KANSAS	54-87 K-6657-01	2002	698	1122

Scale: 1:500

DATE	BY	REFERENCES NOTED	REFERENCES CHECKED

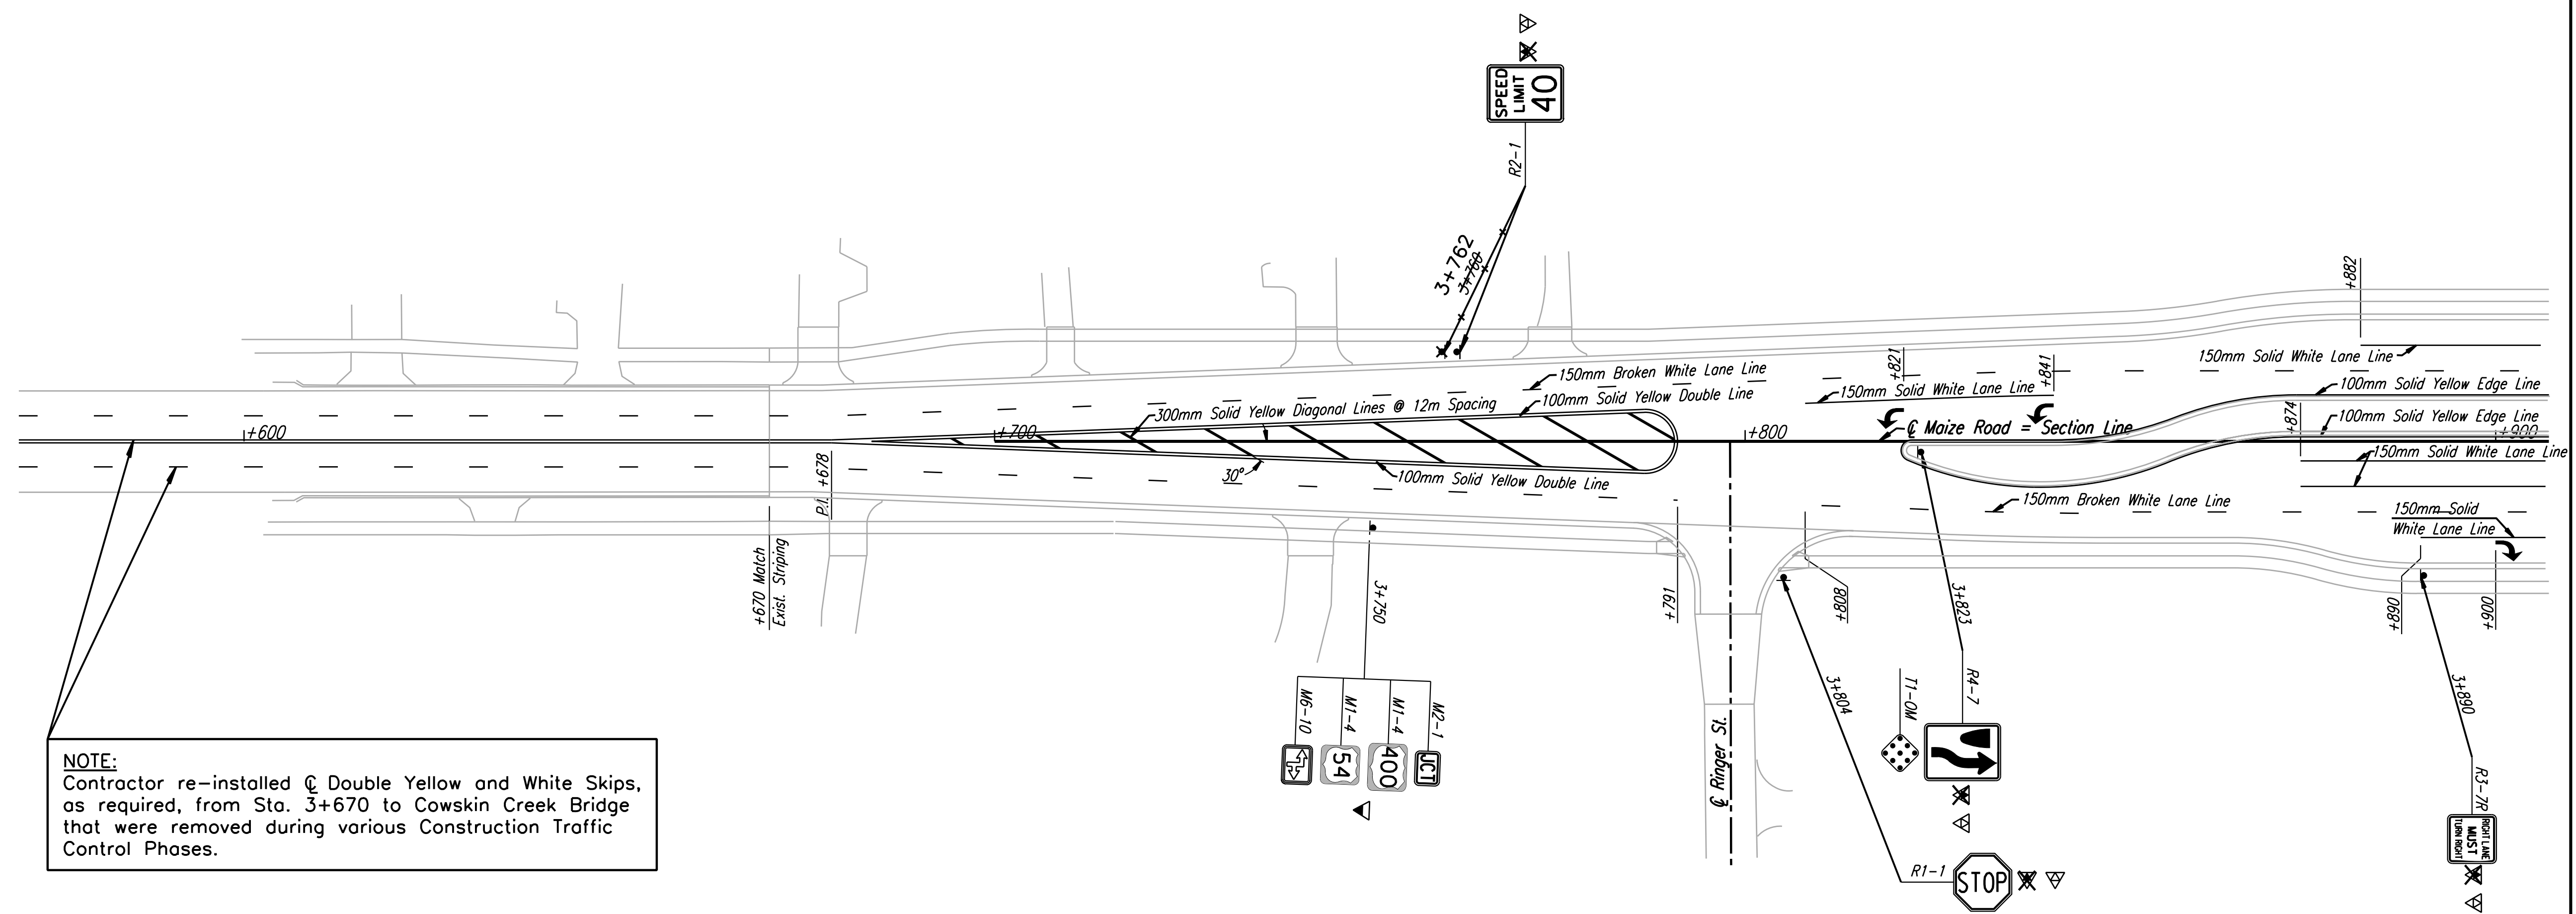

**NOTE:**  
Contractor re-installed  $\oslash$  Double Yellow and White Skips, as required, from Sta. 3+670 to Cowskin Creek Bridge that were removed during various Construction Traffic Control Phases.

DSNR: WDH OPR: JGP SCALE: 1:500  
 I:/1997/97362/As-Builts/dgns/10\_4/50 698-Maize-p13670.dgn Last Rev: 10-2-07 By: gdr

**RECORD DRAWING**

No.	Revisions	By	Date

**CITY OF WICHITA**  
**SIGNING & MARKING PLAN**  
**MAIZE ROAD**  
**STA. 3+670 TO STA. 3+900**  
 SEDGWICK COUNTY

**Professional Engineering Consultants, P.A.**  
 303 S. TOPEKA • WICHITA, KANSAS 67202  
 316-262-2691 • FAX 316-262-3003

Designed by	RPG	Checked by	WDH
Drawn by	SVB	Date	April, 2002
		Job No.	97362