


FHWA REGION NO.	STATE	PROJECT NO.	YEAR	SHEET NO.	TOTAL SHEETS
7	KANSAS	54-87 K-6657-01	2002	699	1122

Scale: 1:500

BY	DATE
REFERENCES NOTED	
REFERENCES CHECKED	

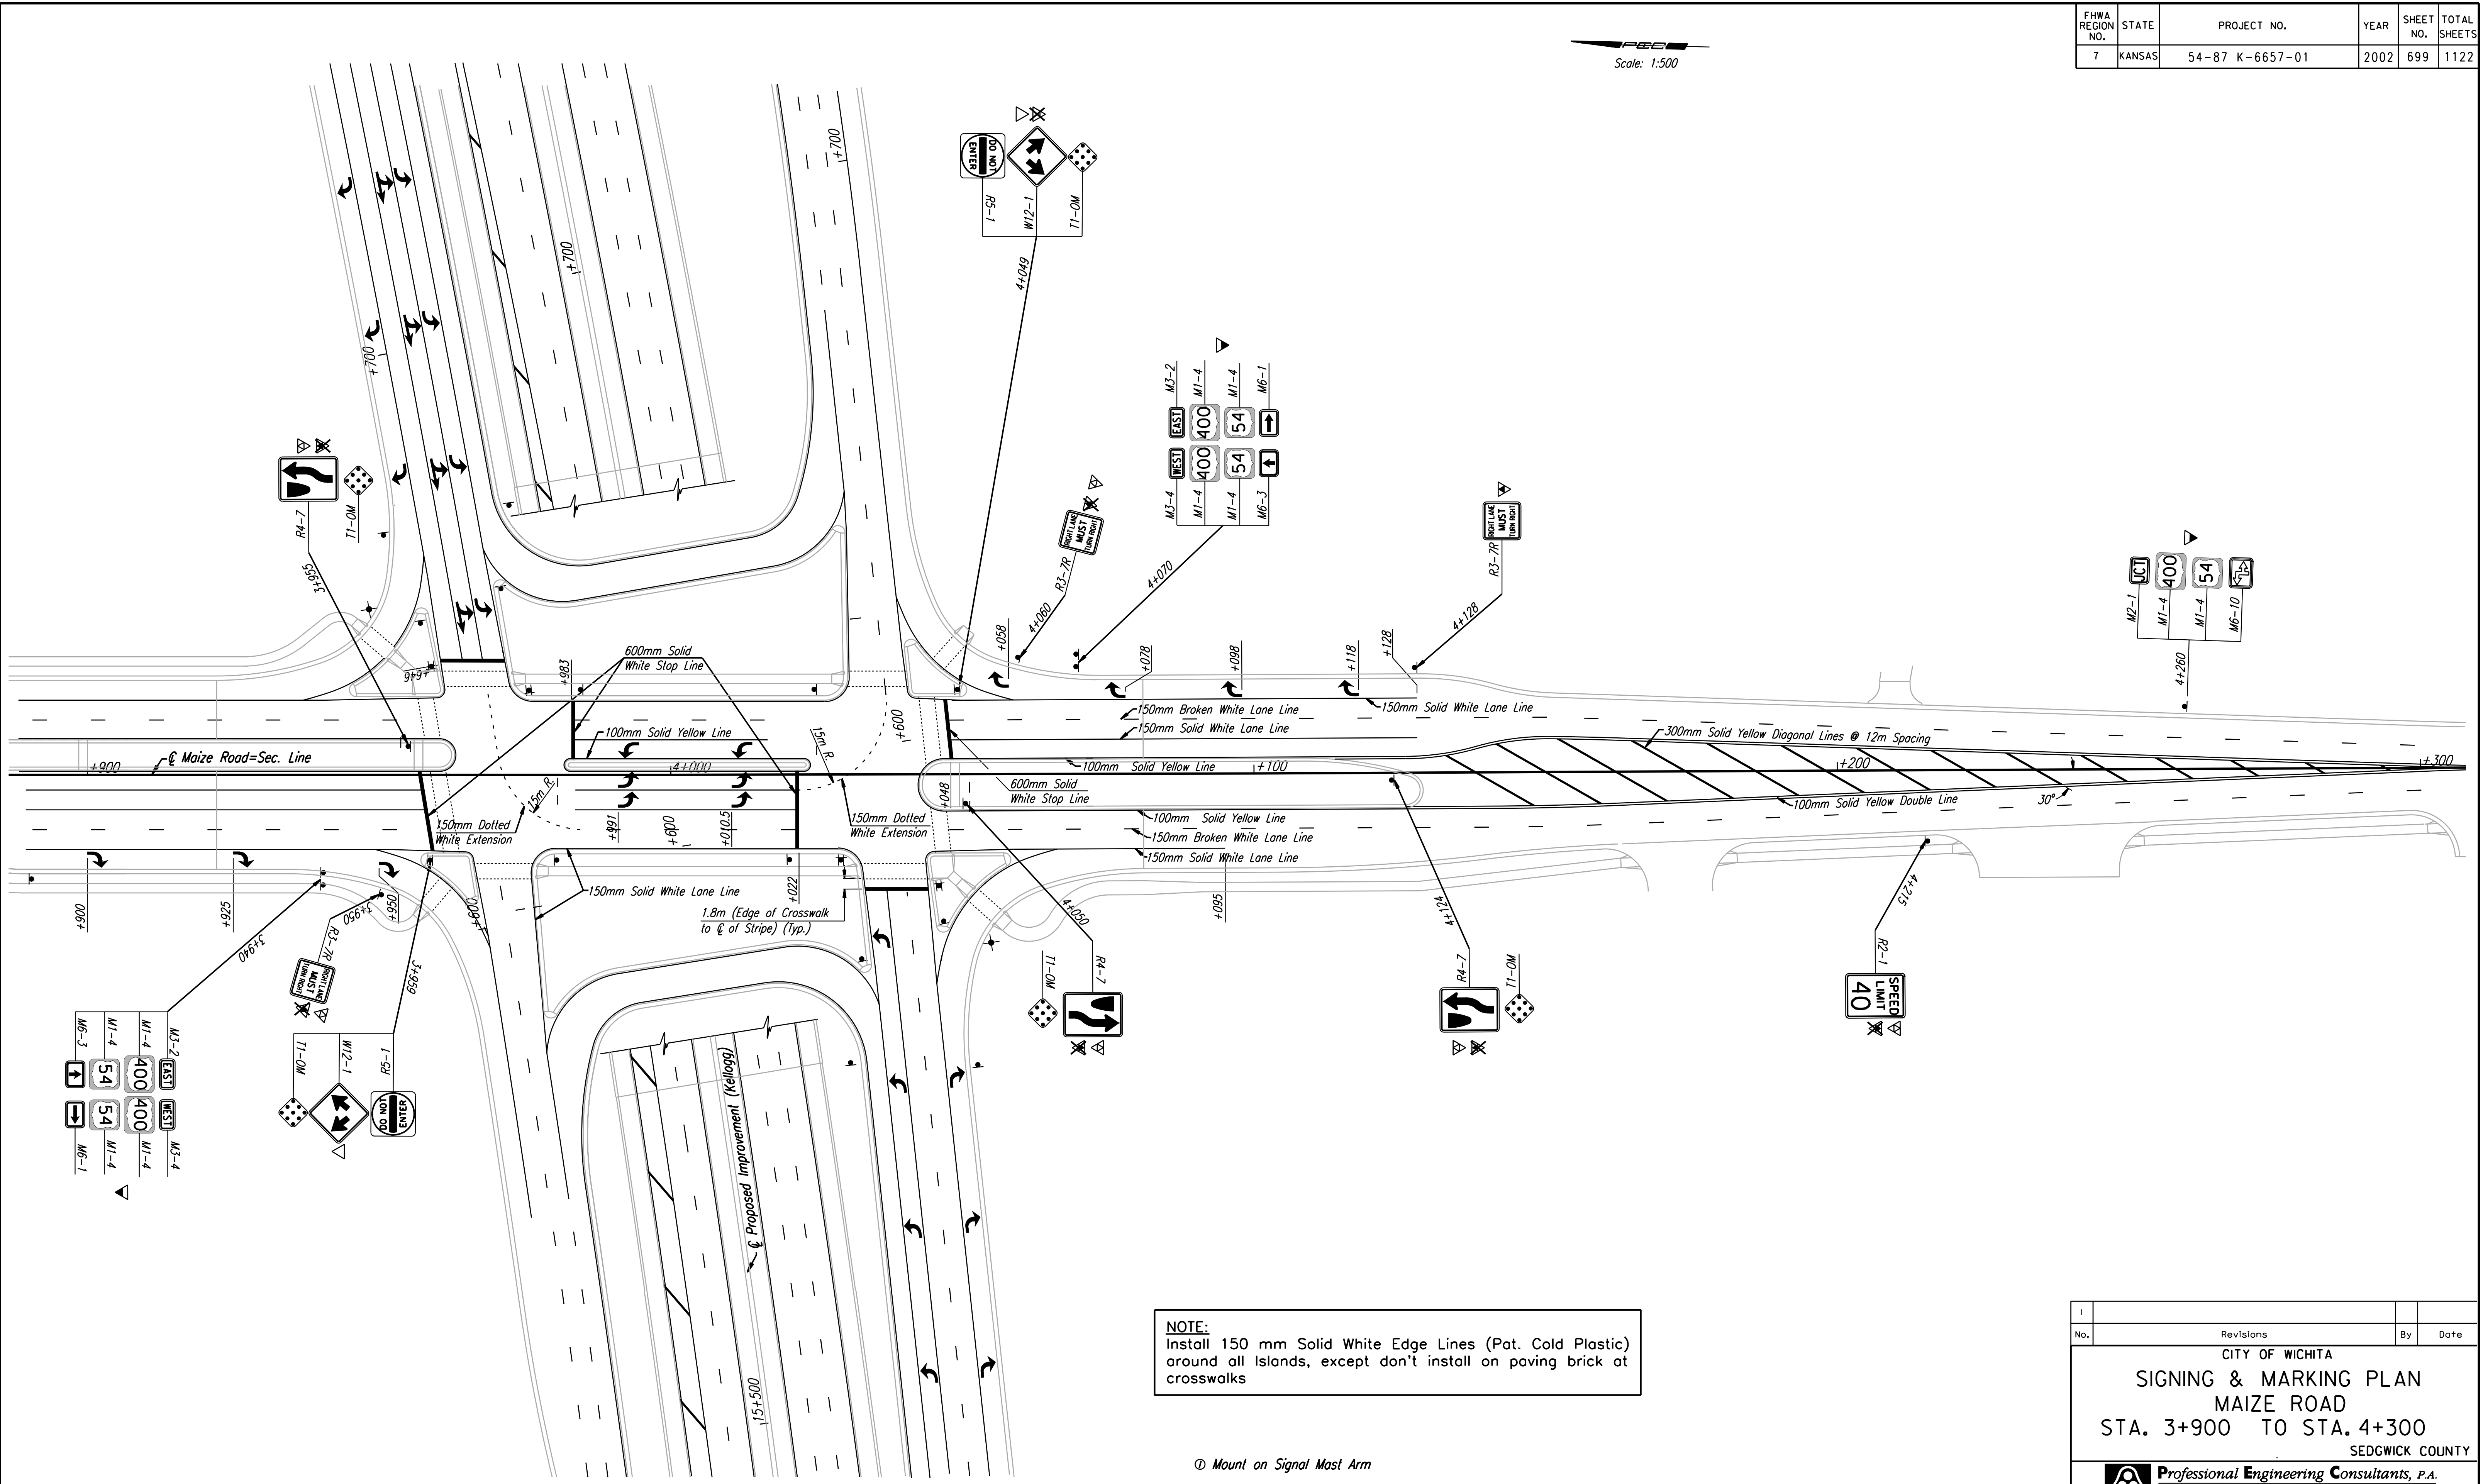

**NOTE:**  
Install 150 mm Solid White Edge Lines (Pat. Cold Plastic) around all islands, except don't install on paving brick at crosswalks

Ⓞ Mount on Signal Mast Arm

DSMR: WDH - OPER: JGP SCALE: 1:500  
1/1997/97.362/As-Built/dgn/s/Vol\_4/5h 699-Maize-pl.3900.dgn Last Rev: 10-2-07 By: gdr

**RECORD DRAWING**

No.	Revisions	By	Date

CITY OF WICHITA  
**SIGNING & MARKING PLAN**  
MAIZE ROAD  
STA. 3+900 TO STA. 4+300  
SEDGWICK COUNTY

**Professional Engineering Consultants, P.A.**  
303 S. TOPEKA • WICHITA, KANSAS 67202  
316-262-2691 • FAX 316-262-3003

Designed by	RPG	Checked by	WDH
Drawn by	SVB	Date	April, 2002
		Job No.	97362