


FHWA REGION NO.	STATE	PROJECT NO.	YEAR	SHEET NO.	TOTAL SHEETS
7	KANSAS	54-87 K-6657-01	2002	703	1122



DATE	
BY	
REFERENCES NOTED	
REFERENCES CHECKED	

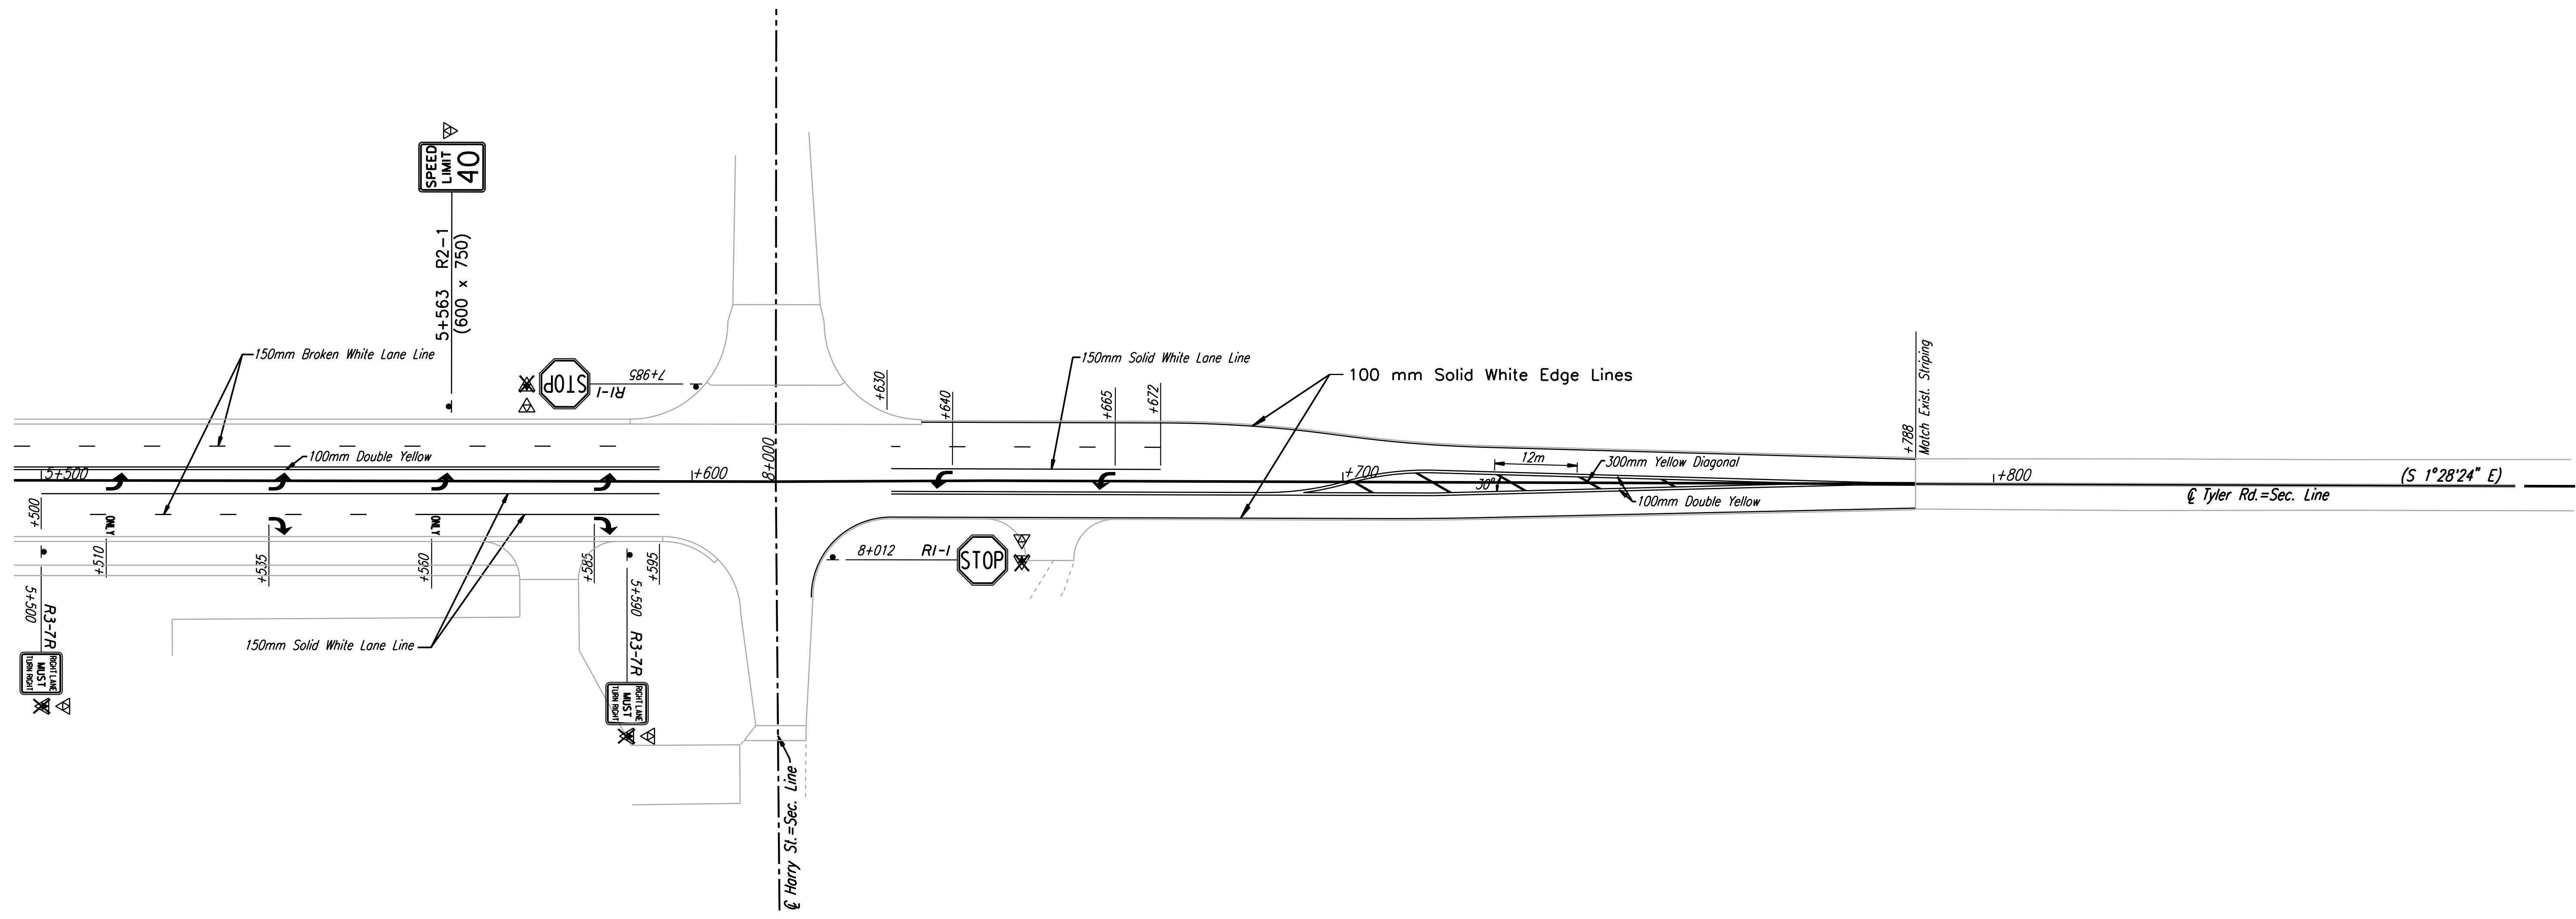

DSNR: RCH OPER: JGP SCALE: 1:500  
 I:\1997\97362\As-Builts\dgn\41\Sh 703-Tyler-p15500.dgn Last Rev: 10-2-07 By: gdr

**RECORD DRAWING**

No.	Revisions	By	Date

CITY OF WICHITA  
**SIGNING & MARKING PLAN**  
**TYLER ROAD**  
**STA. 5+500 TO STA. 5+800**  
 SEDGWICK COUNTY


**Professional Engineering Consultants, P.A.**  
 303 S. TOPEKA • WICHITA, KANSAS 67202  
 316-262-2691 • FAX 316-262-3003

Designed by	RPG	Checked by	WDH
Drawn by	SVB	Date	April, 2002
		Job No.	97362