


FHWA REGION NO.	STATE	PROJECT NO.	YEAR	SHEET NO.	TOTAL SHEETS
7	KANSAS	54-87 K-6657-01	2002	714	1122

DATE	BY
REFERENCES NOTED	REFERENCES CHECKED

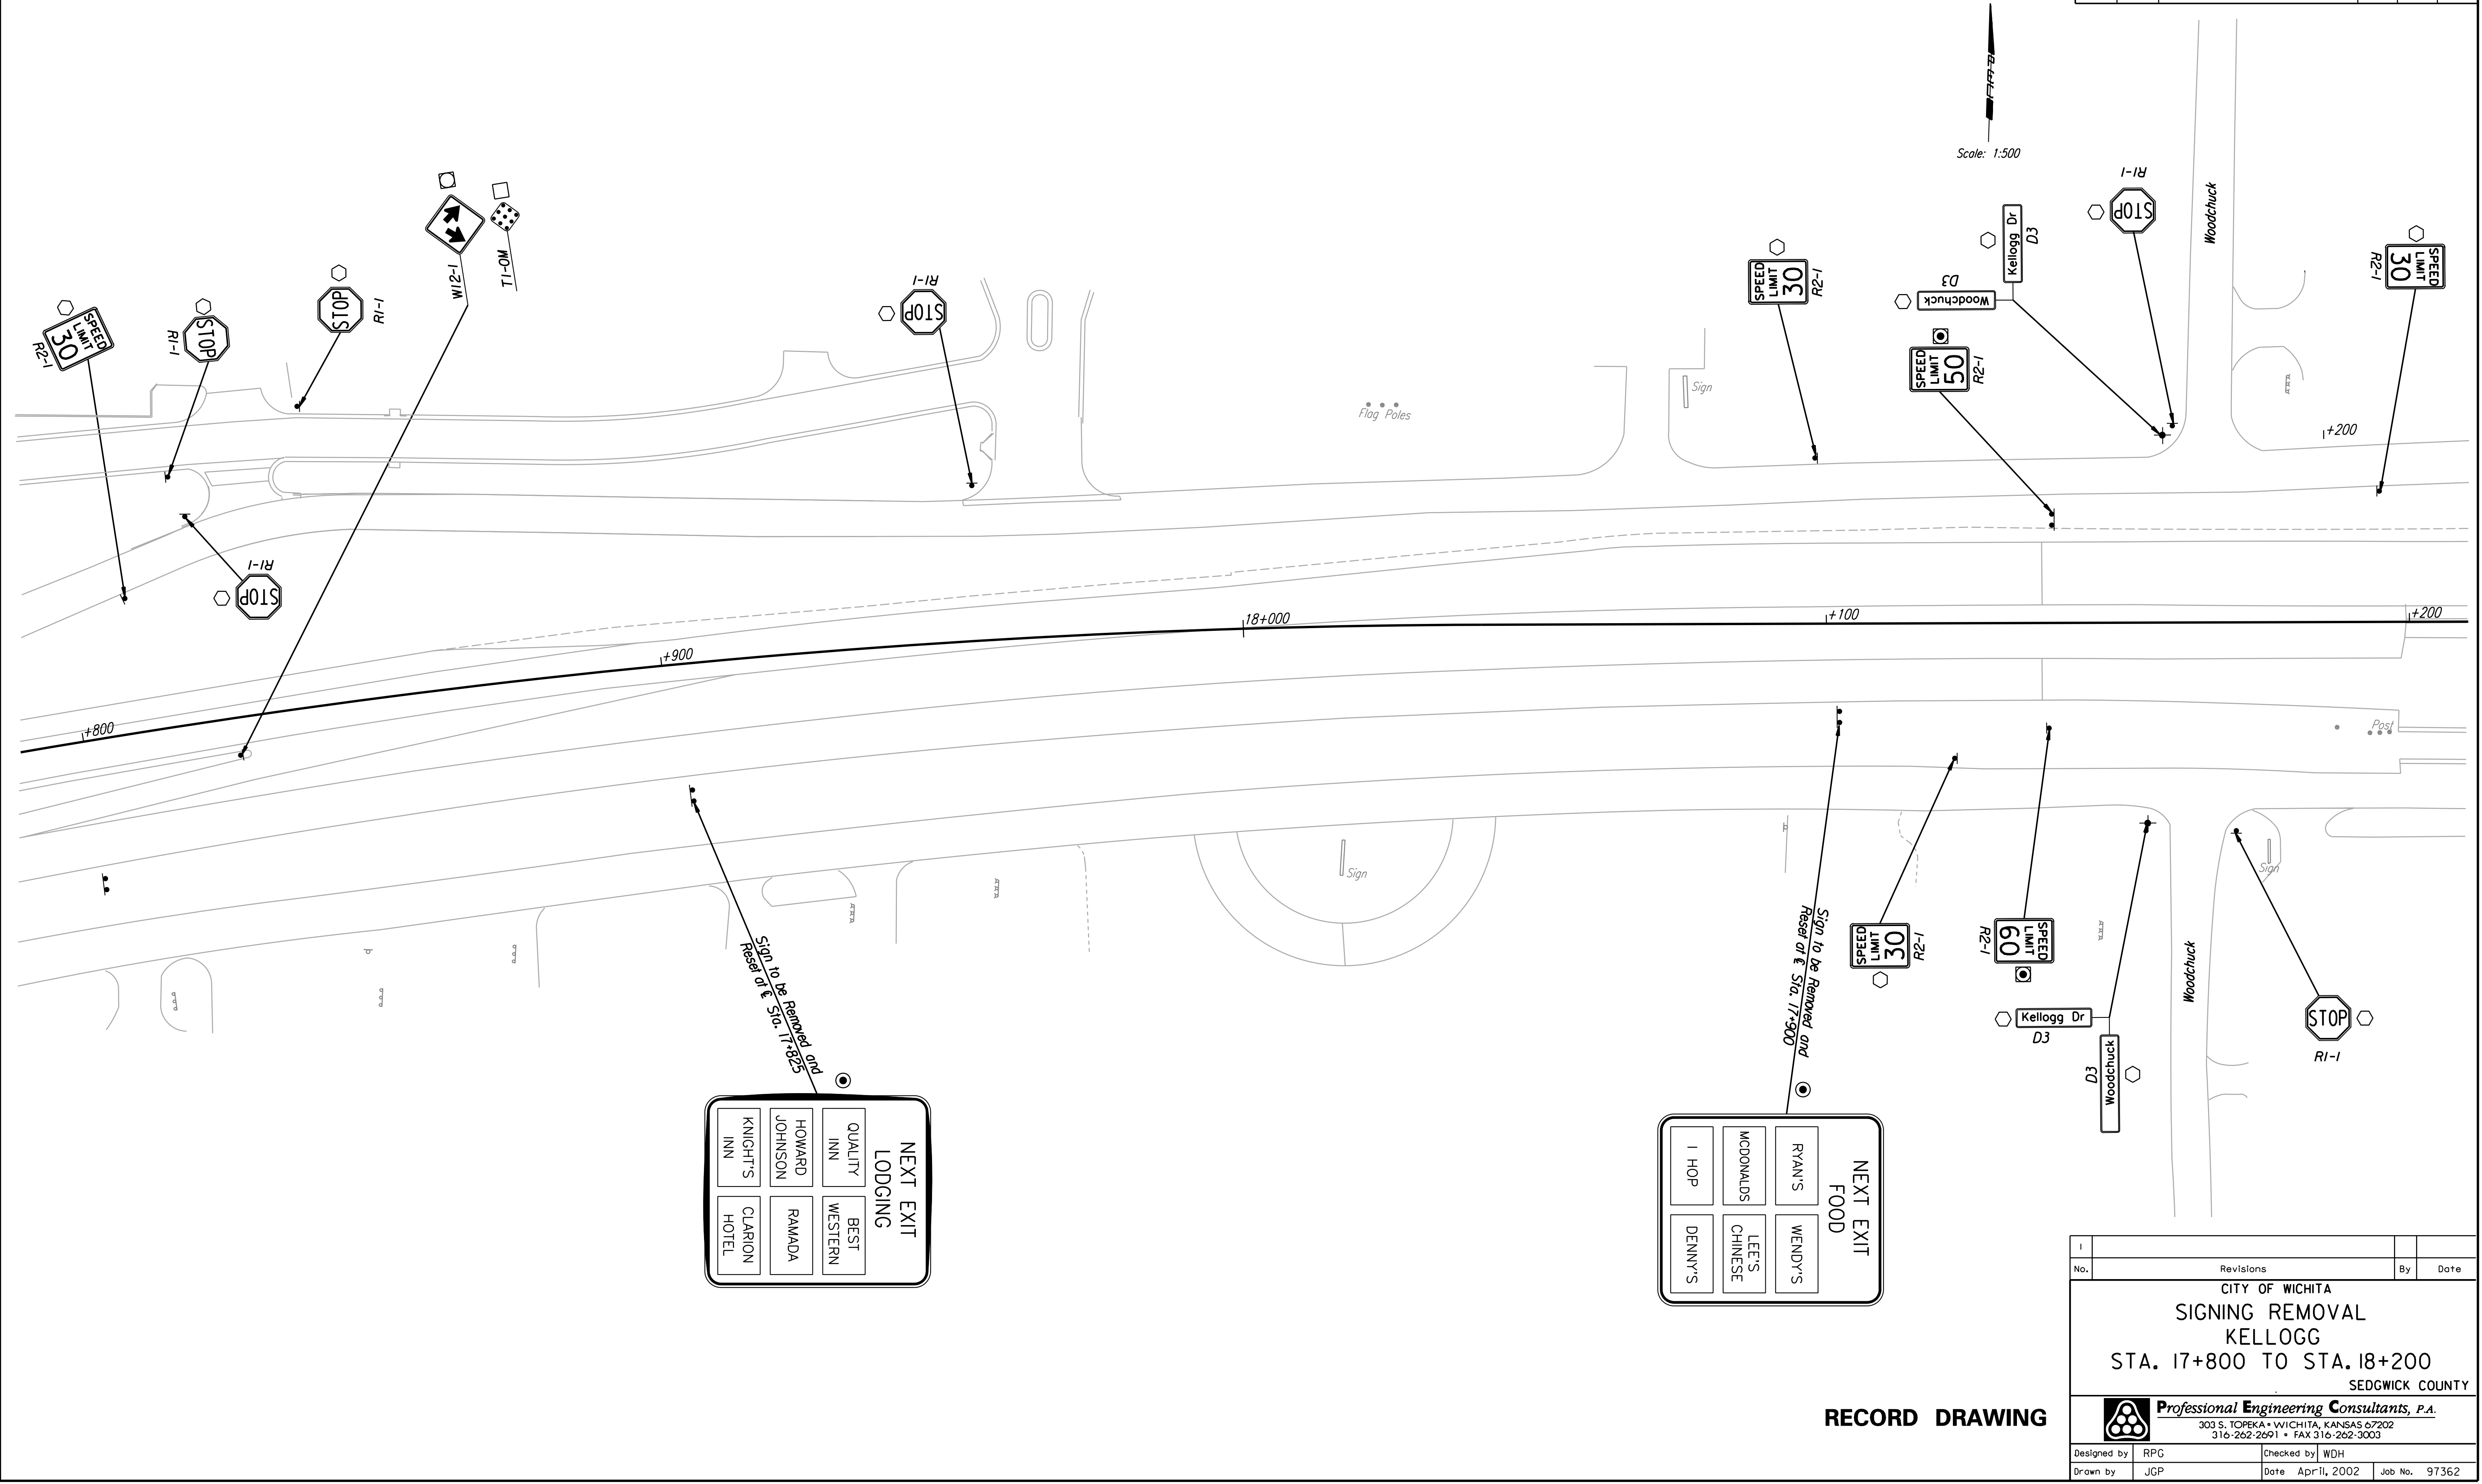

NEXT EXIT LODGING

KNIGHT'S INN	HOWARD JOHNSON	QUALITY INN
CLARION HOTEL	RAMADA	BEST WESTERN

NEXT EXIT FOOD

I HOP	MCDONALDS	RYAN'S
DENNY'S	LEE'S CHINESE	WENDY'S

DSMR: WDH OPER: JGP SCALE: 1:500
 1/1997/97362/As-Builts/dgn's/Vol_4/5h 714-Sign-Removal.plt7B.dgn Last Rev: 10-2-07 By: ggr

RECORD DRAWING

1	Revisions	By	Date

CITY OF WICHITA
SIGNING REMOVAL
KELLOGG
STA. 17+800 TO STA. 18+200
 SEDGWICK COUNTY

Professional Engineering Consultants, P.A.
 303 S. TOPEKA • WICHITA, KANSAS 67202
 316-262-2691 • FAX 316-262-3003

Designed by	RPG	Checked by	WDH
Drawn by	JGP	Date	April, 2002
		Job No.	97362