
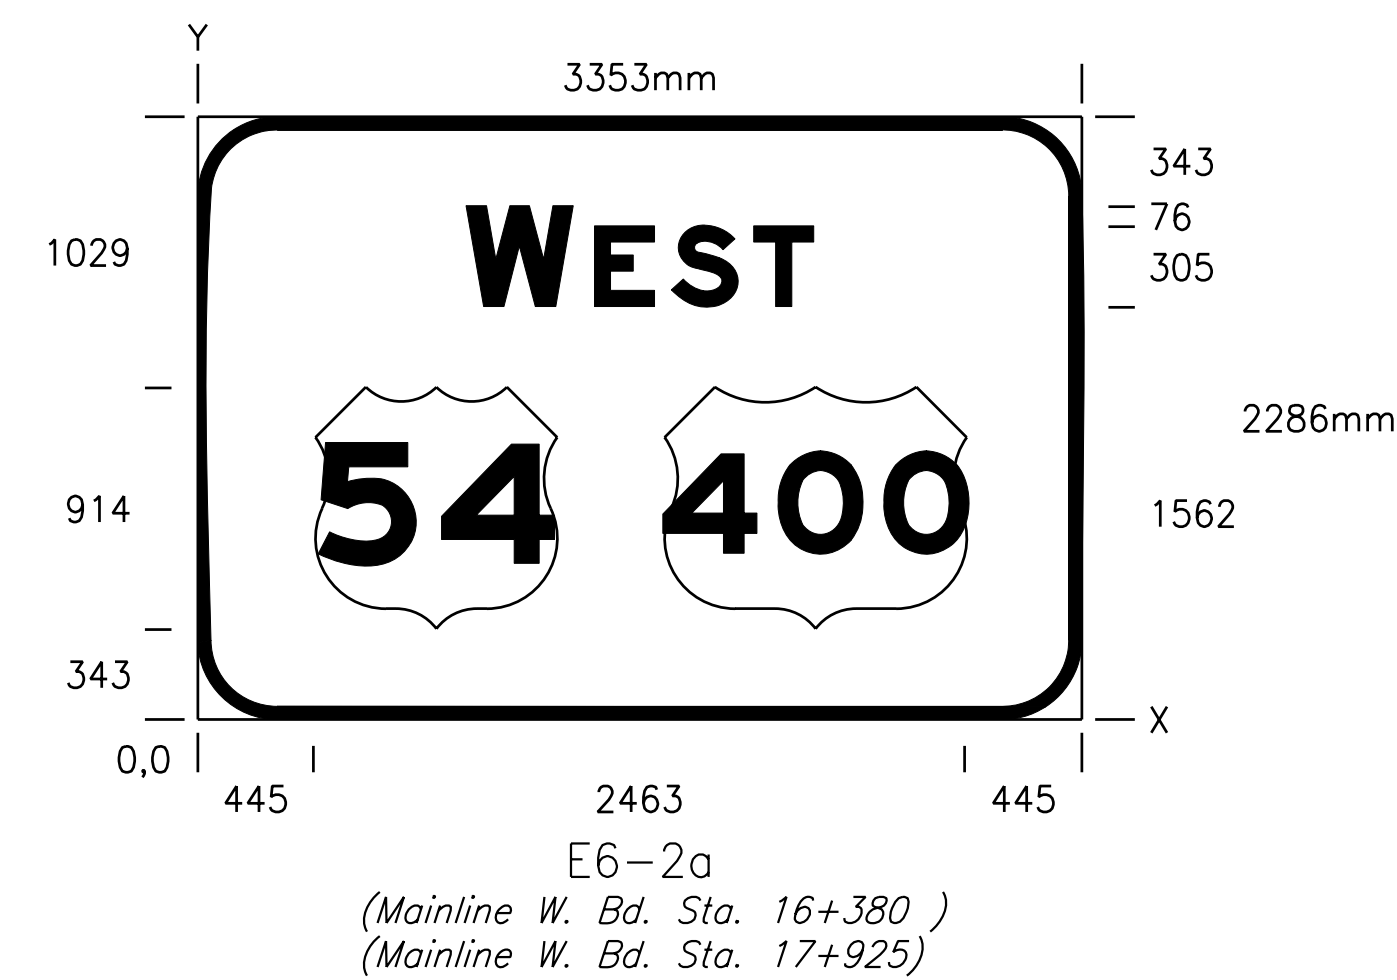
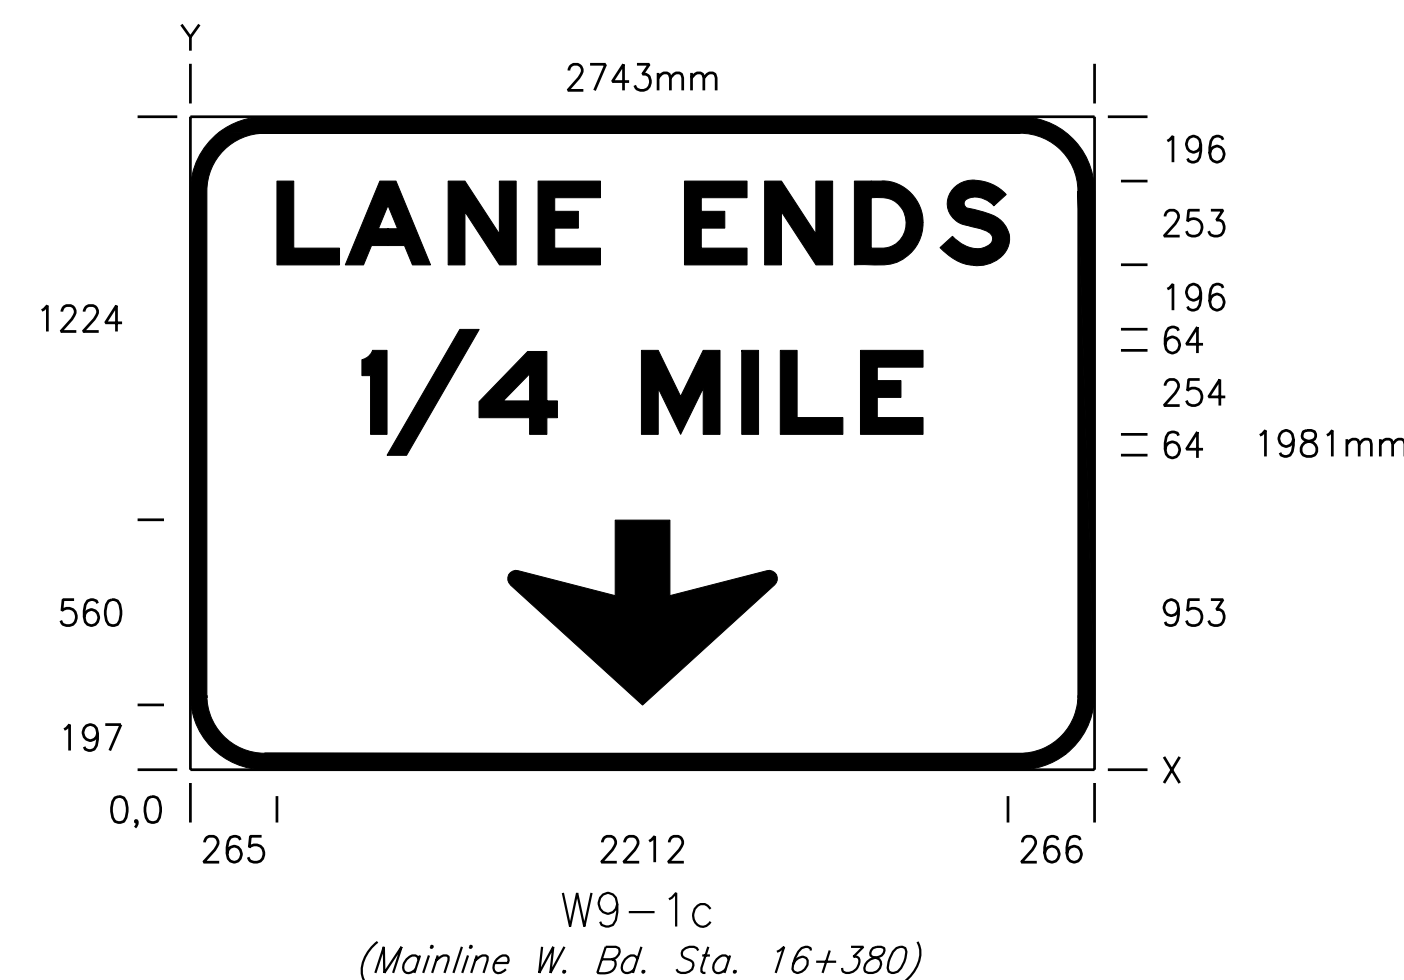
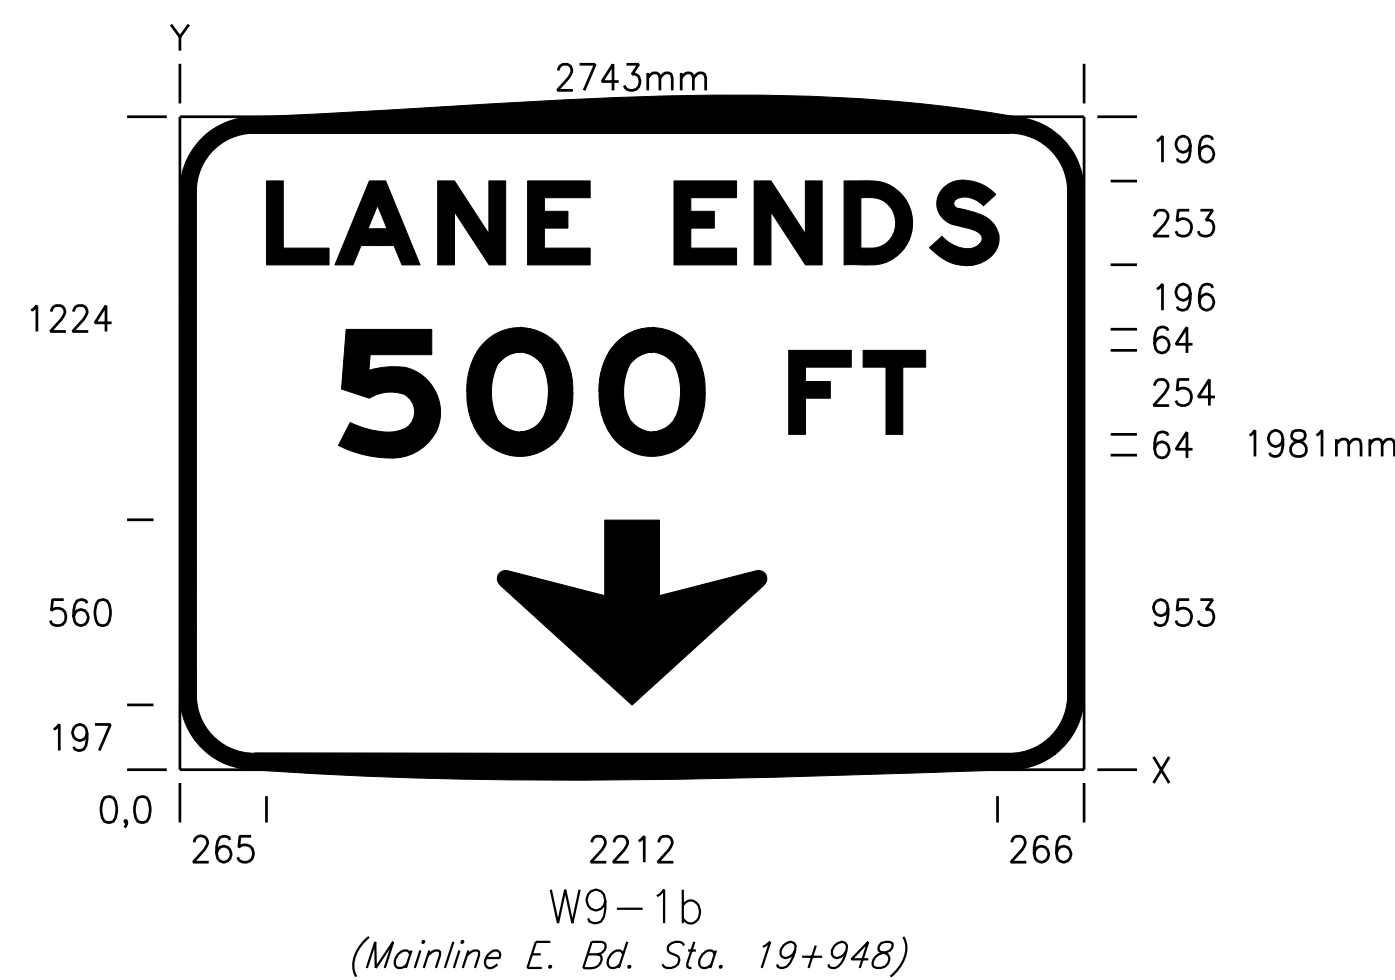
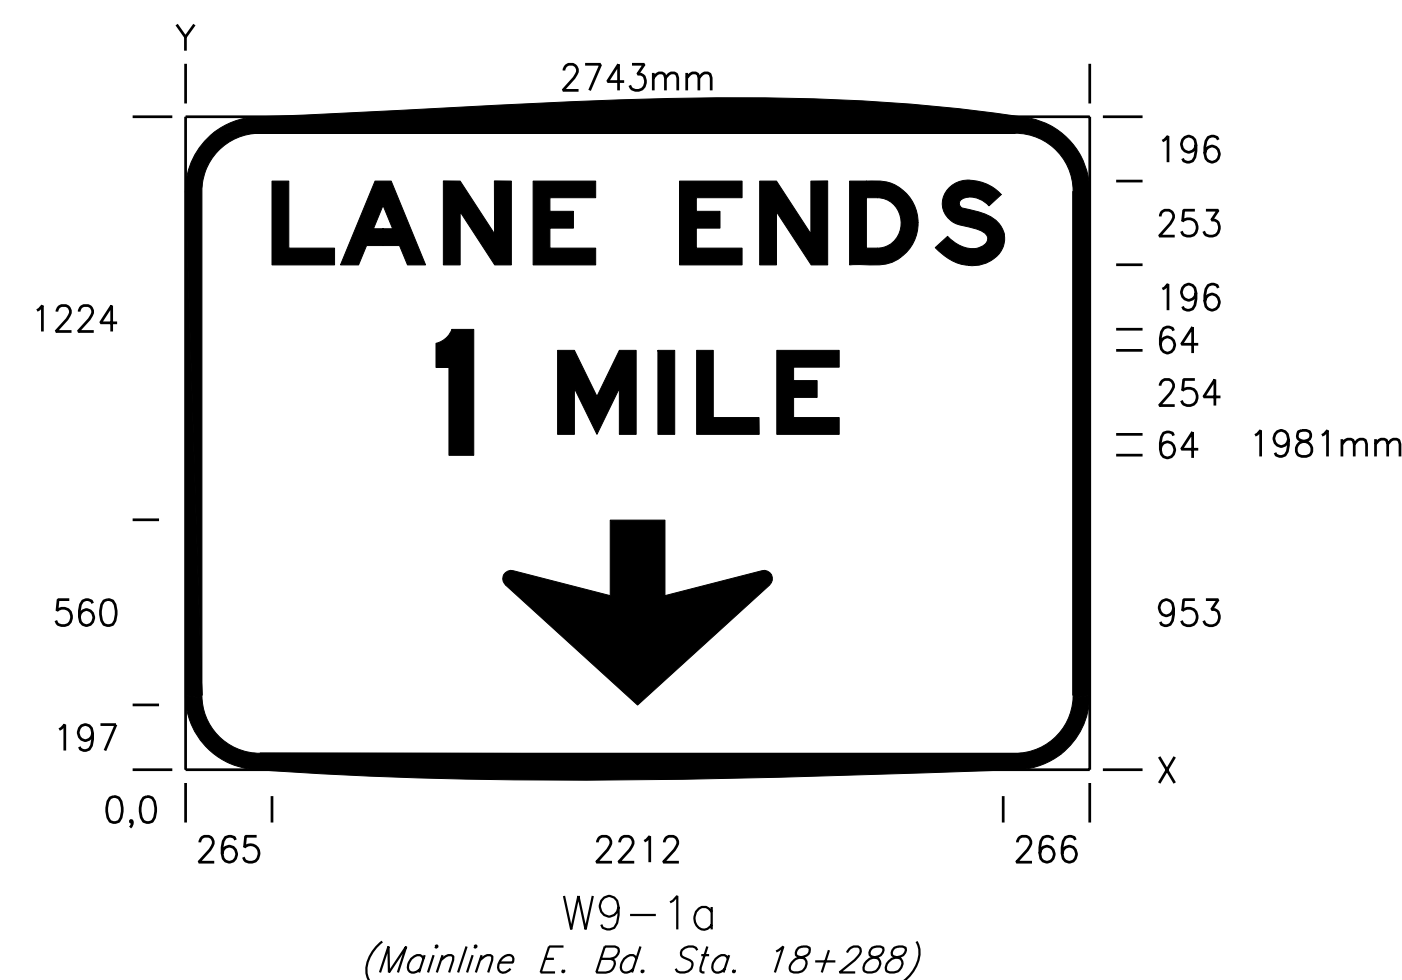
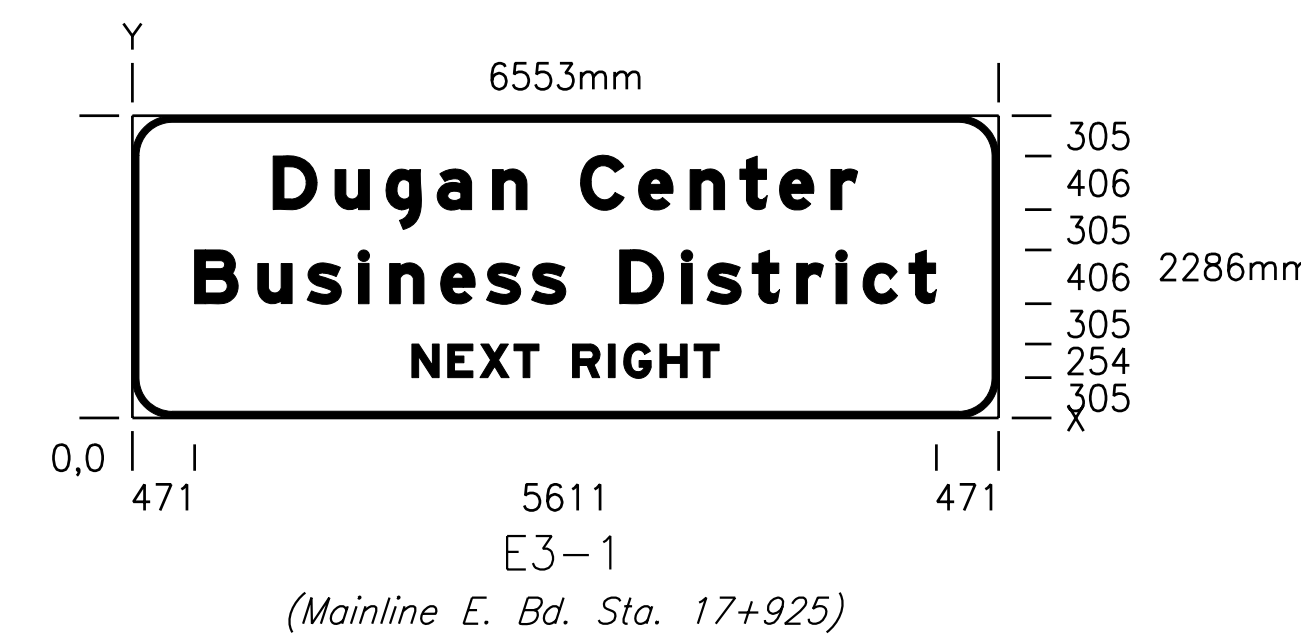
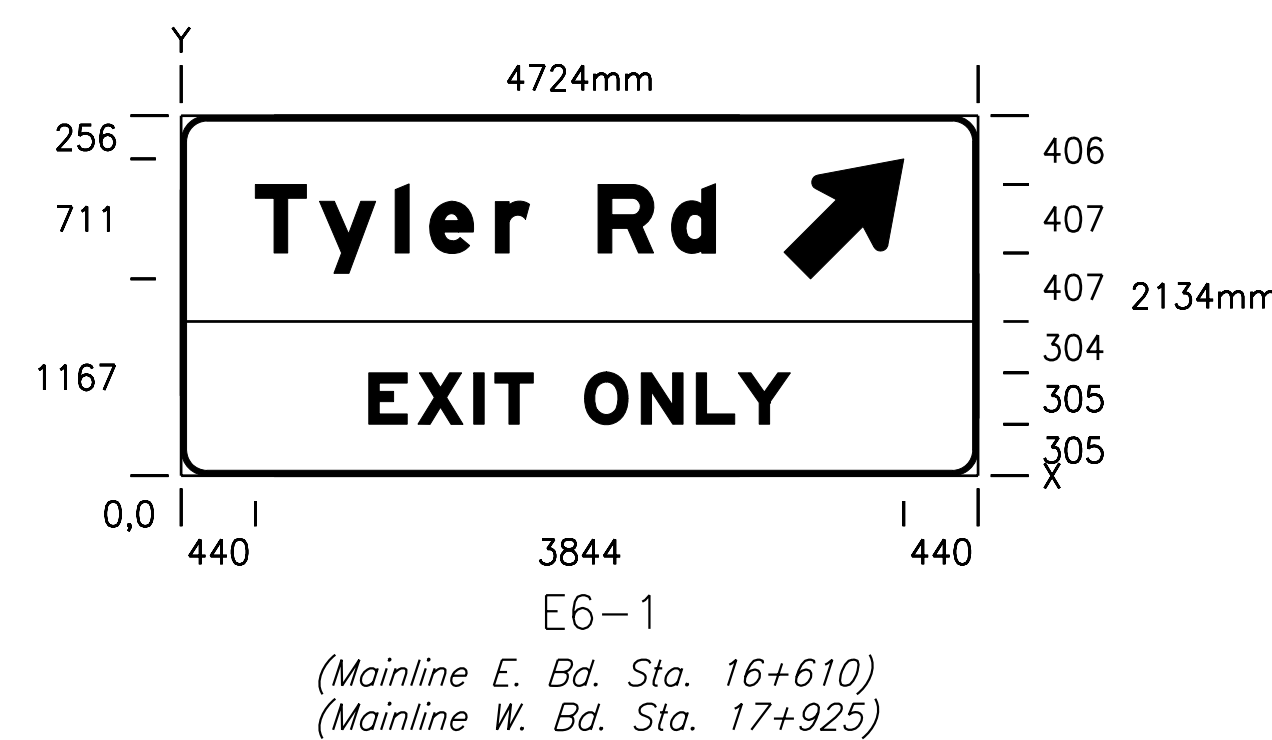
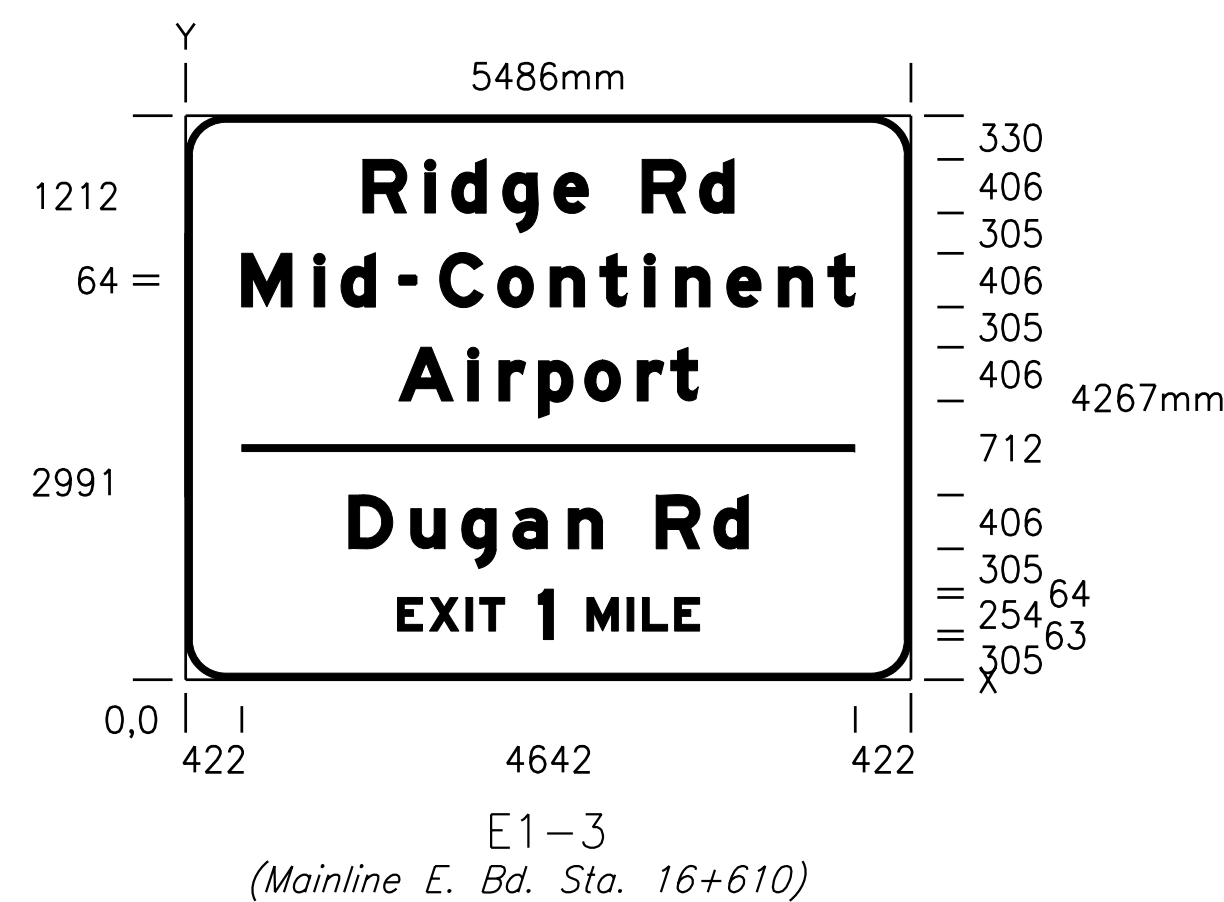
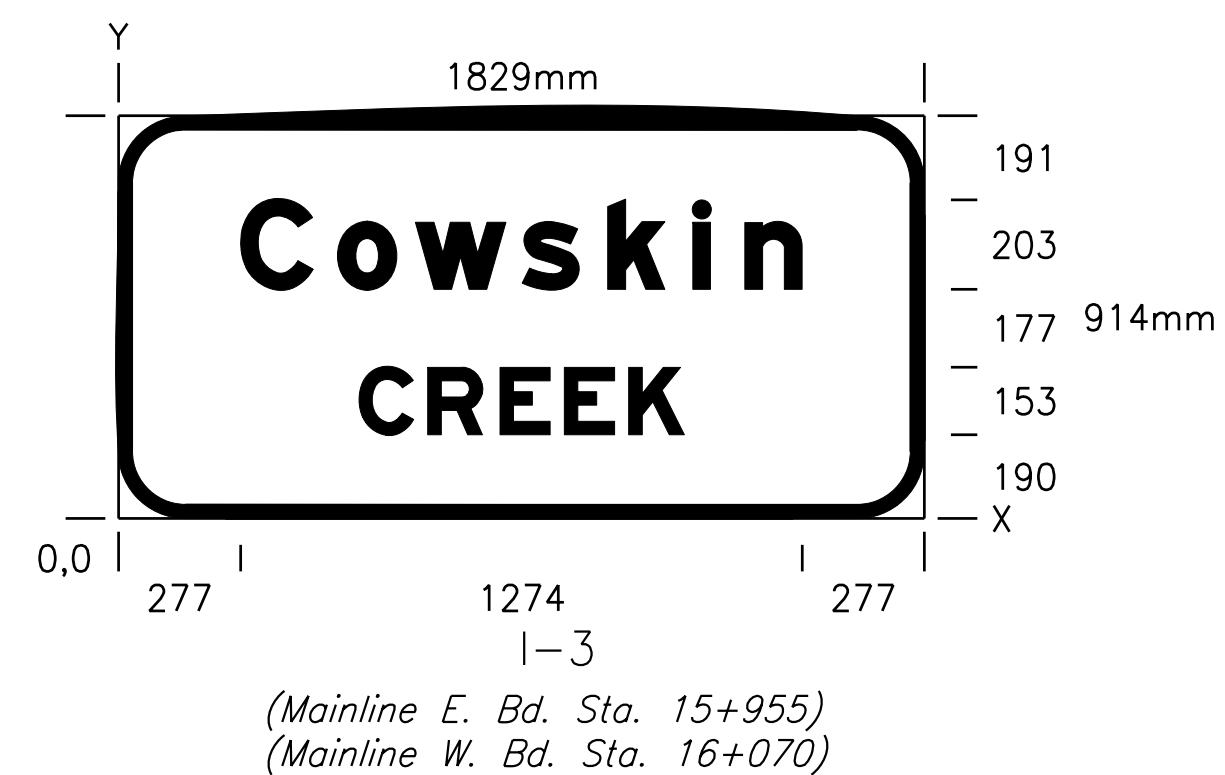
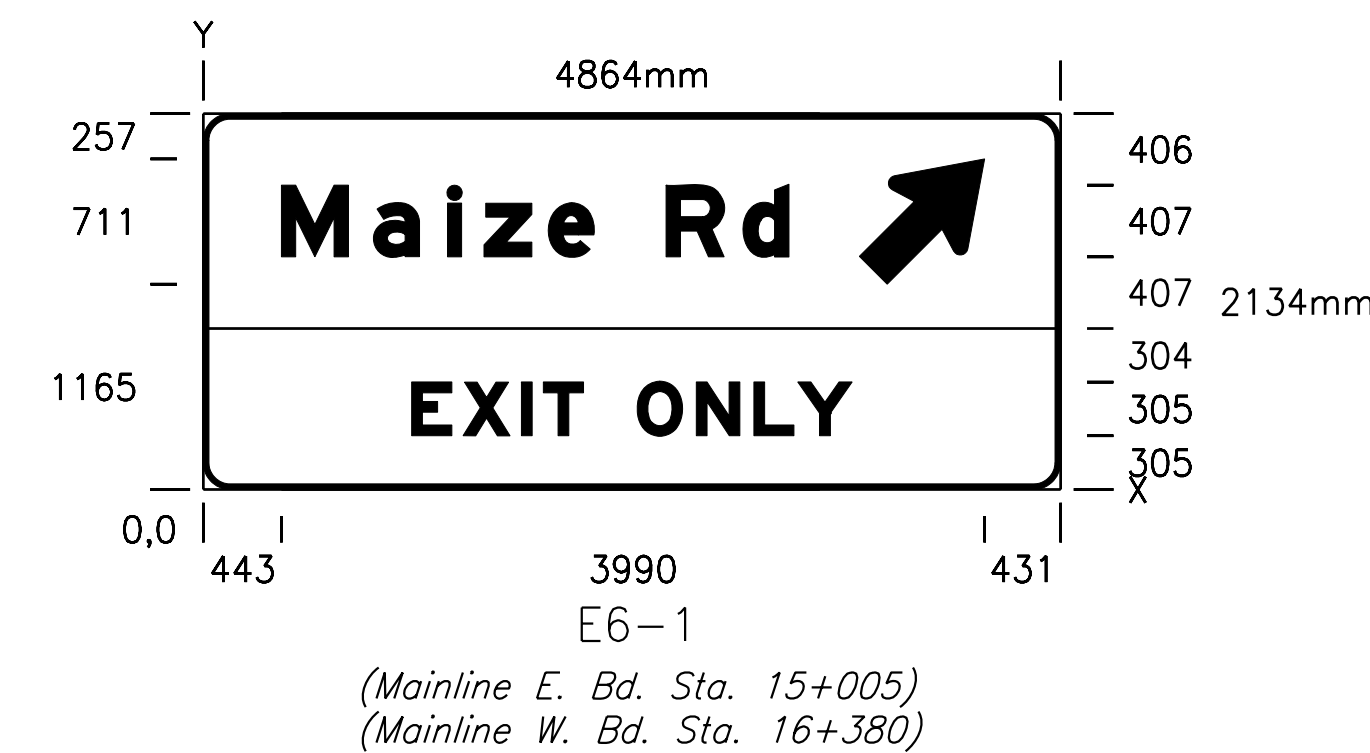
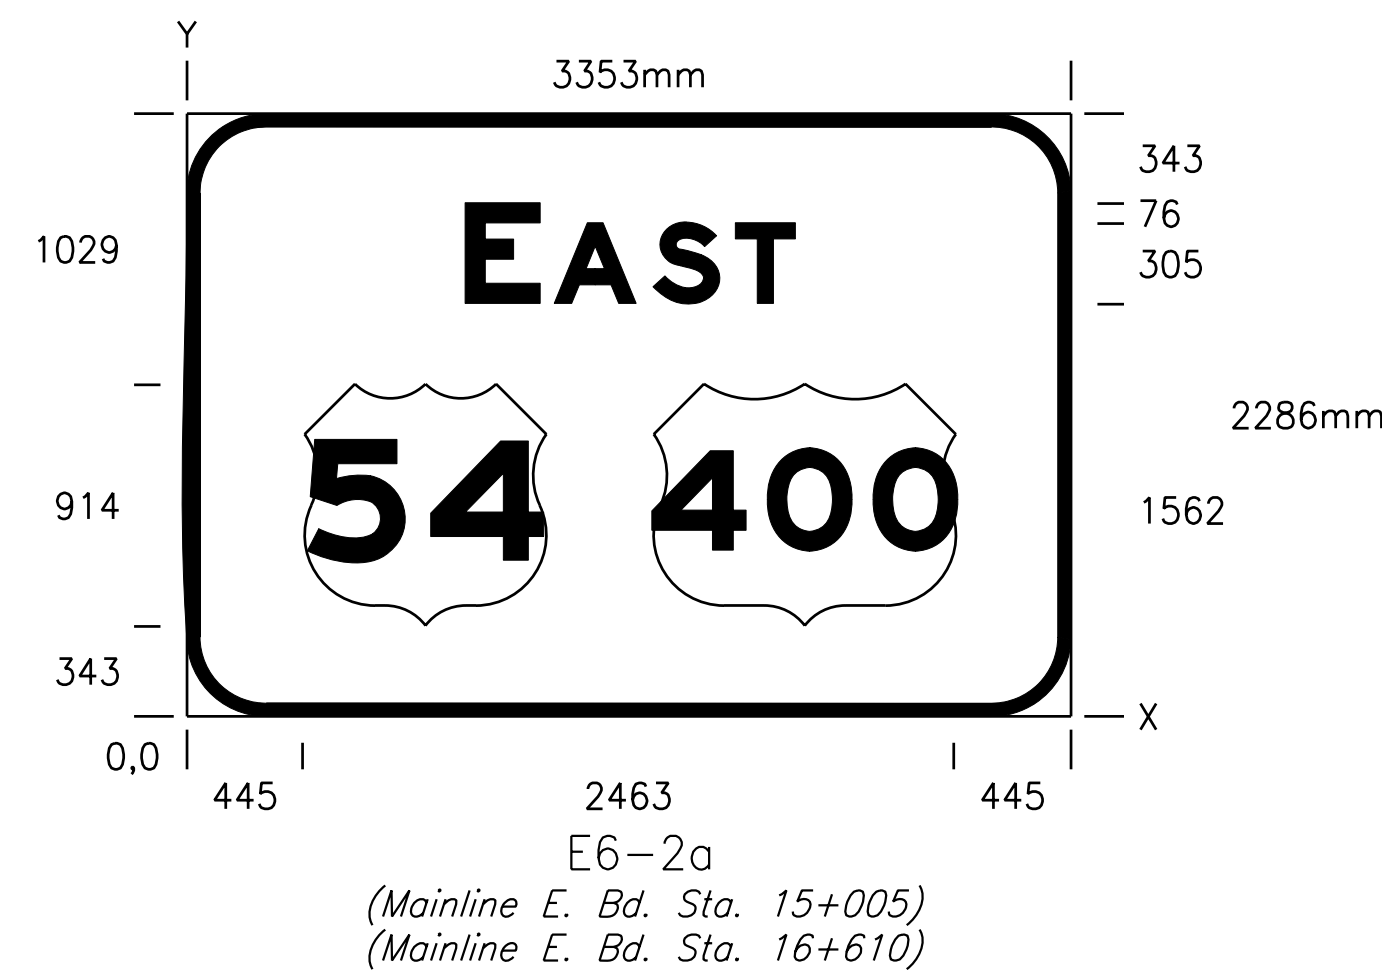
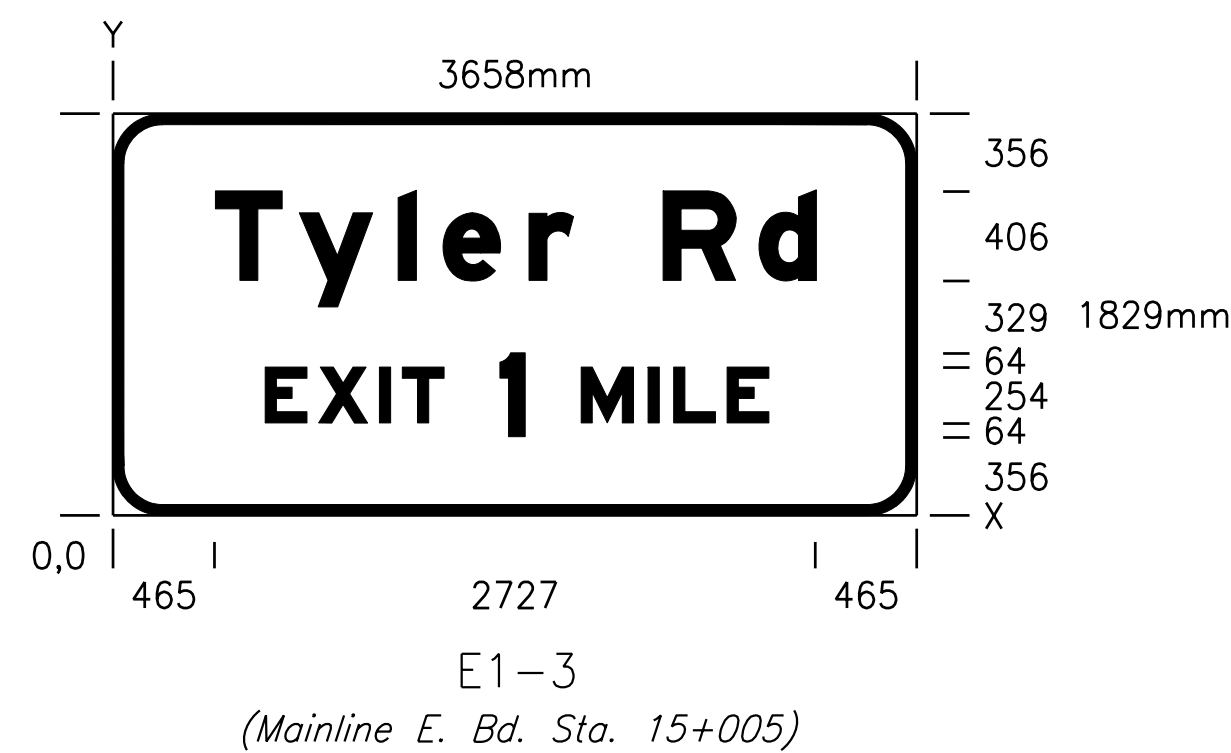


STATE	PROJECT NO.	YEAR	SHEET NO.	TOTAL SHEETS
KANSAS	54-87 K-6657-01	2002	740	1122

DATE	
BY	
REFERENCES NOTED	
REFERENCES CHECKED	

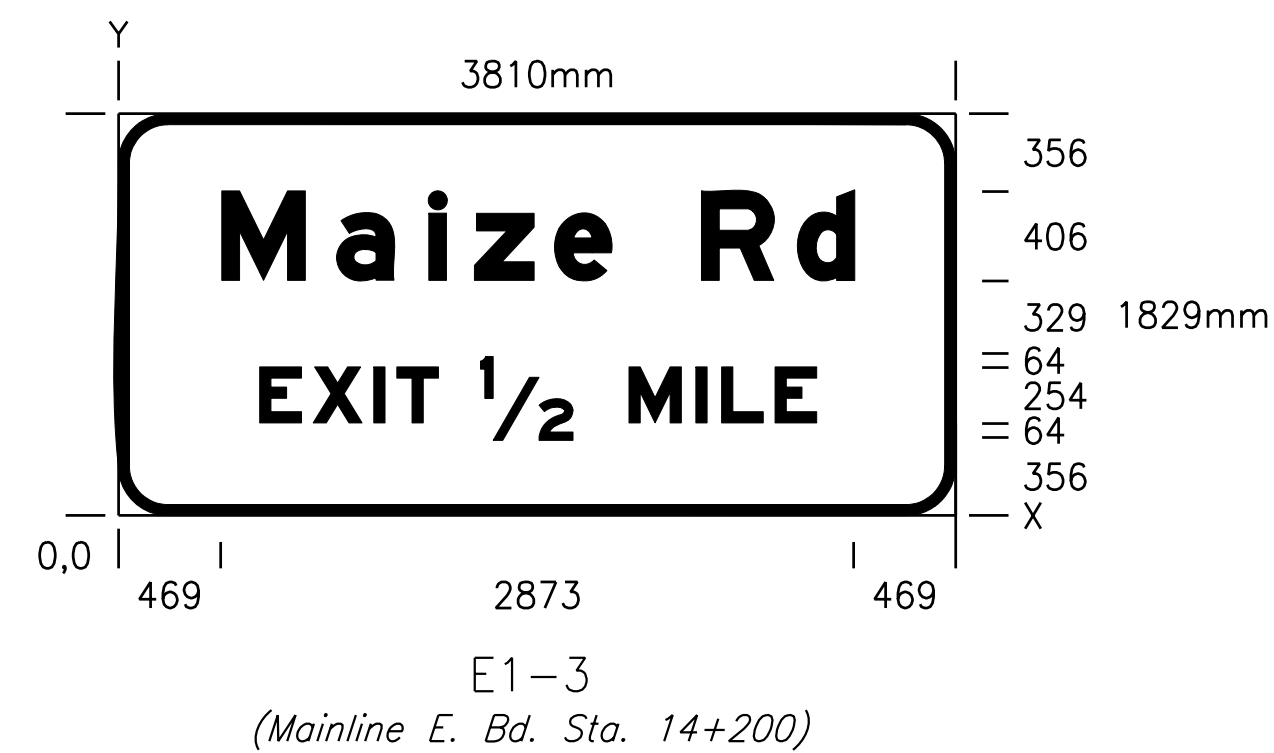

DSMR: RPG OPER: RPG SCALE: 1:500
11/1997/97.362/As-Built/dgn/s/Vol_4/5h 740-layouts.dgn Last Rev: 10-3-07 By: gdr

GENERAL NOTE:
All Copy to be E-Modified

Shop drawings of Sign Layouts
shall be submitted to the Engineer
for approval prior to fabrication.

RECORD DRAWING

No.	Revisions	By	Date
CITY OF WICHITA			
DESIGN DETAILS FOR REMOVABLE LEGEND SIGNS			
SEDGWICK COUNTY			
Professional Engineering Consultants, P.A. 303 S. TOPEKA • WICHITA, KANSAS 67202 316-262-2691 • FAX 316-262-3003			
Designed by	RPG	Checked by	WDH
Drawn by	DRP	Date	April, 2002
		Job No.	97362