
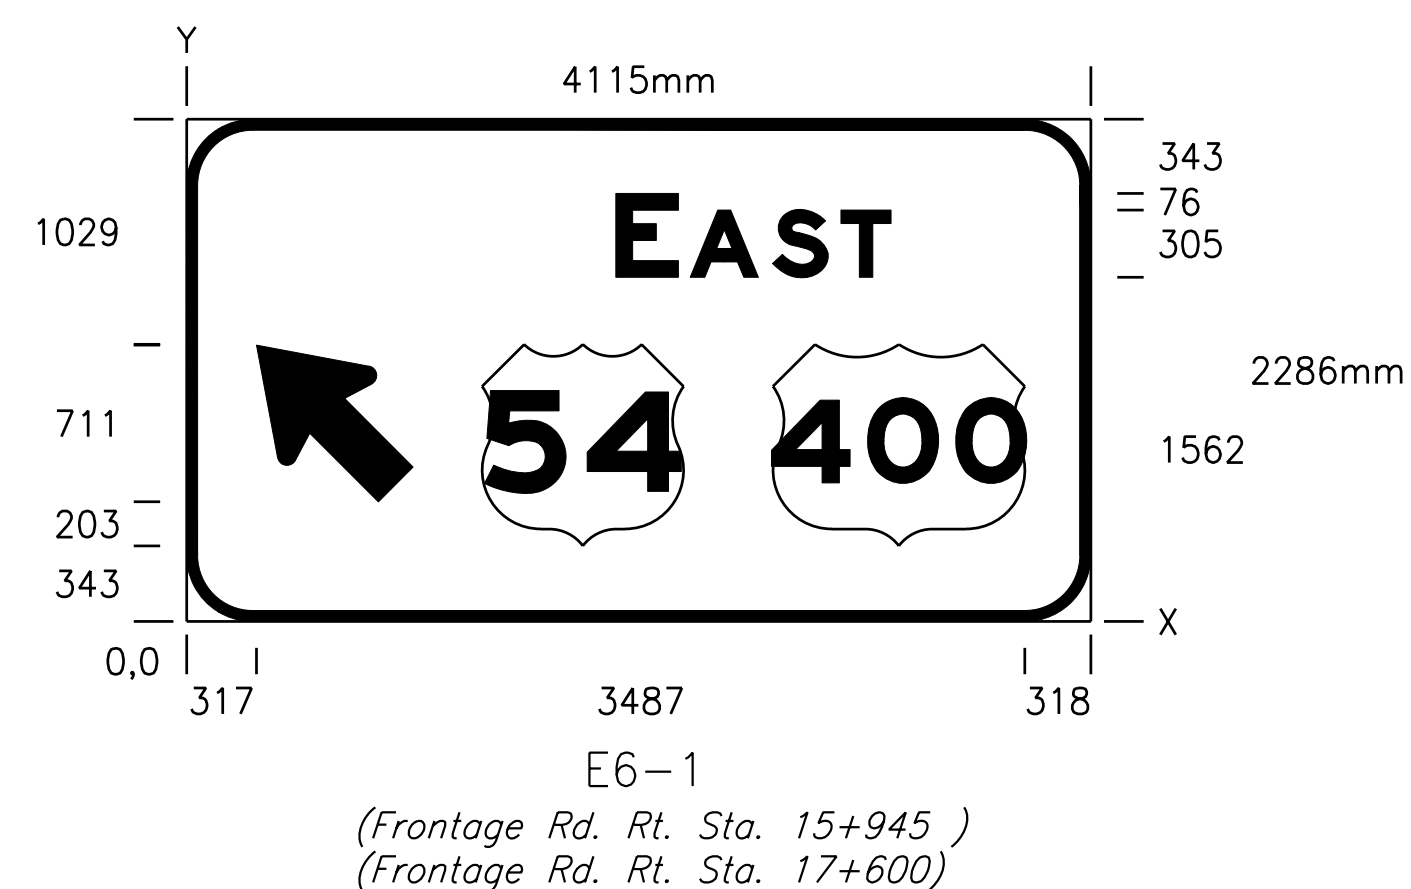
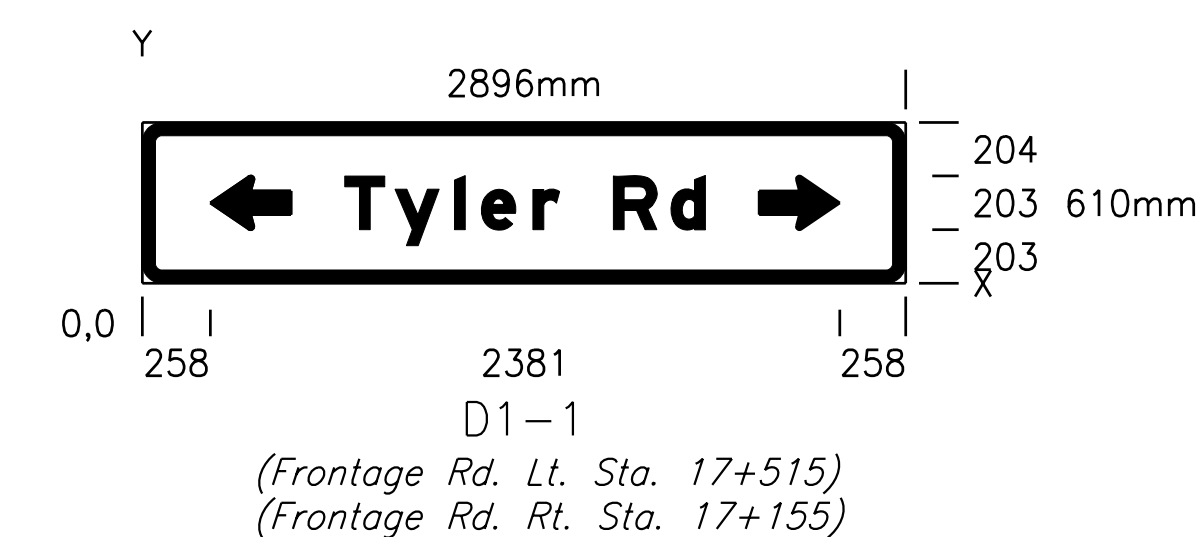
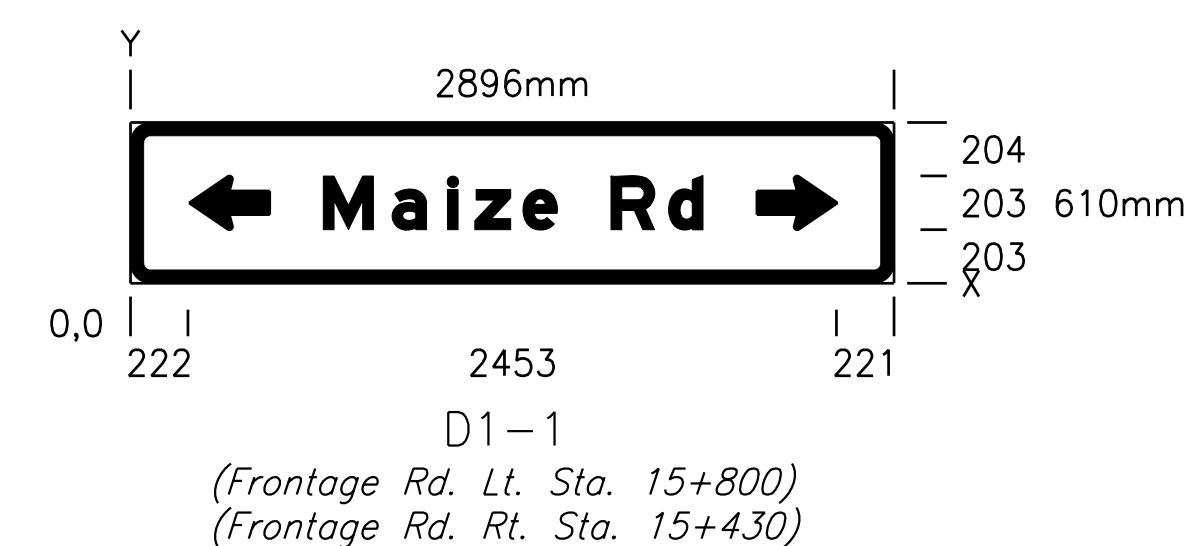
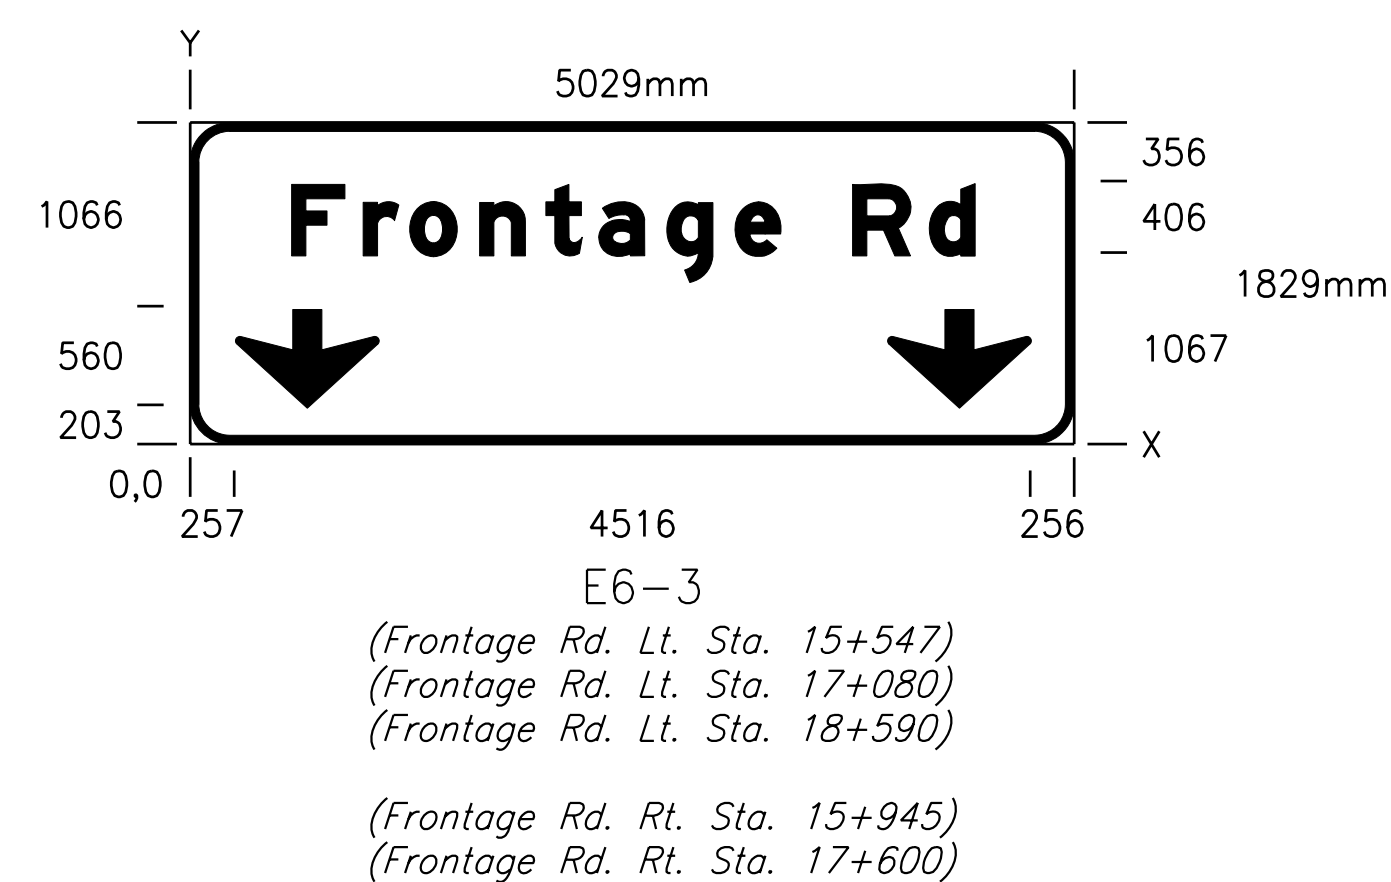
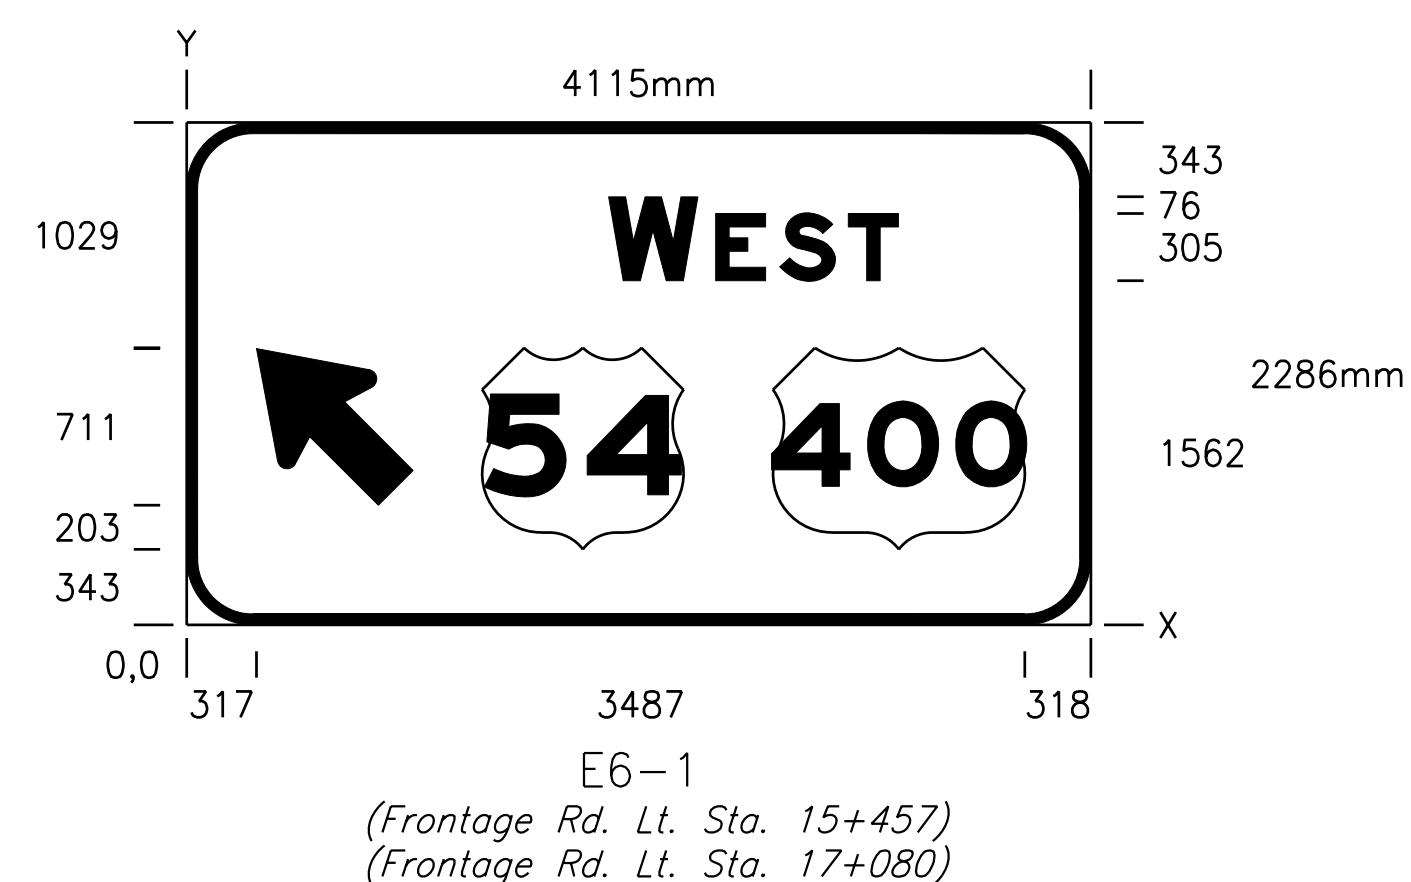
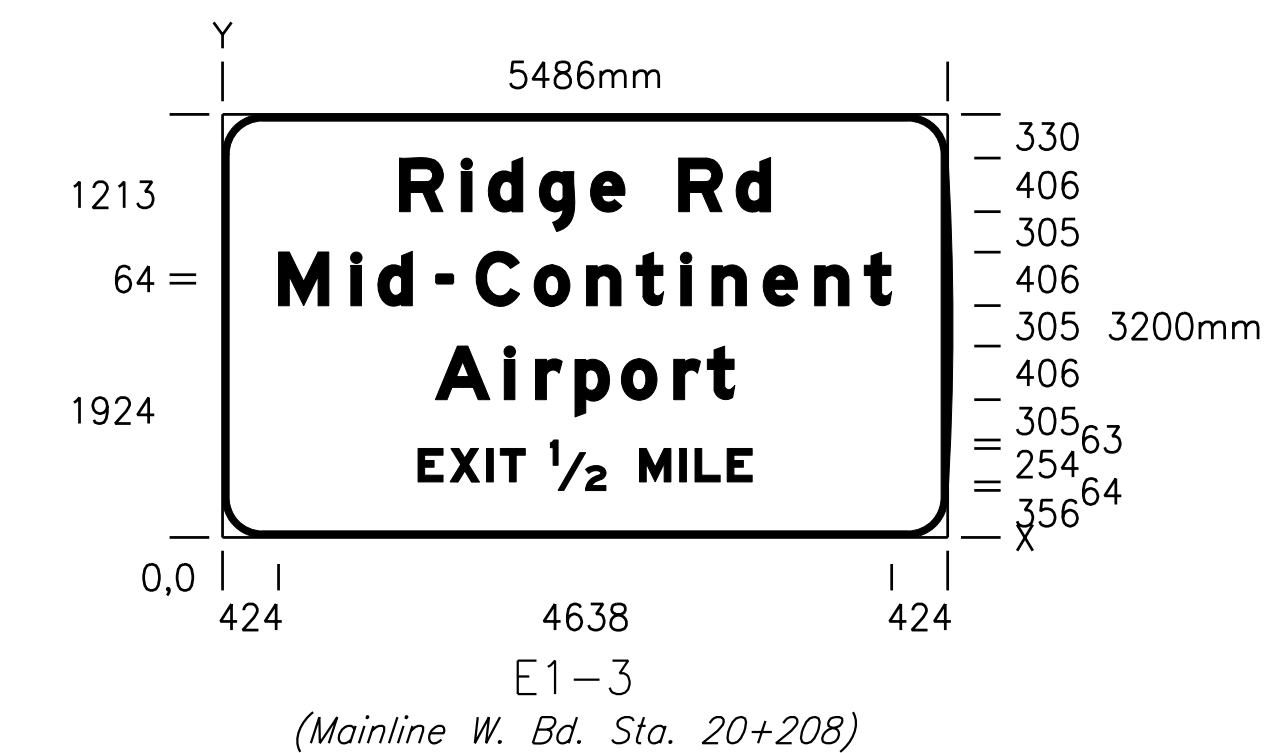
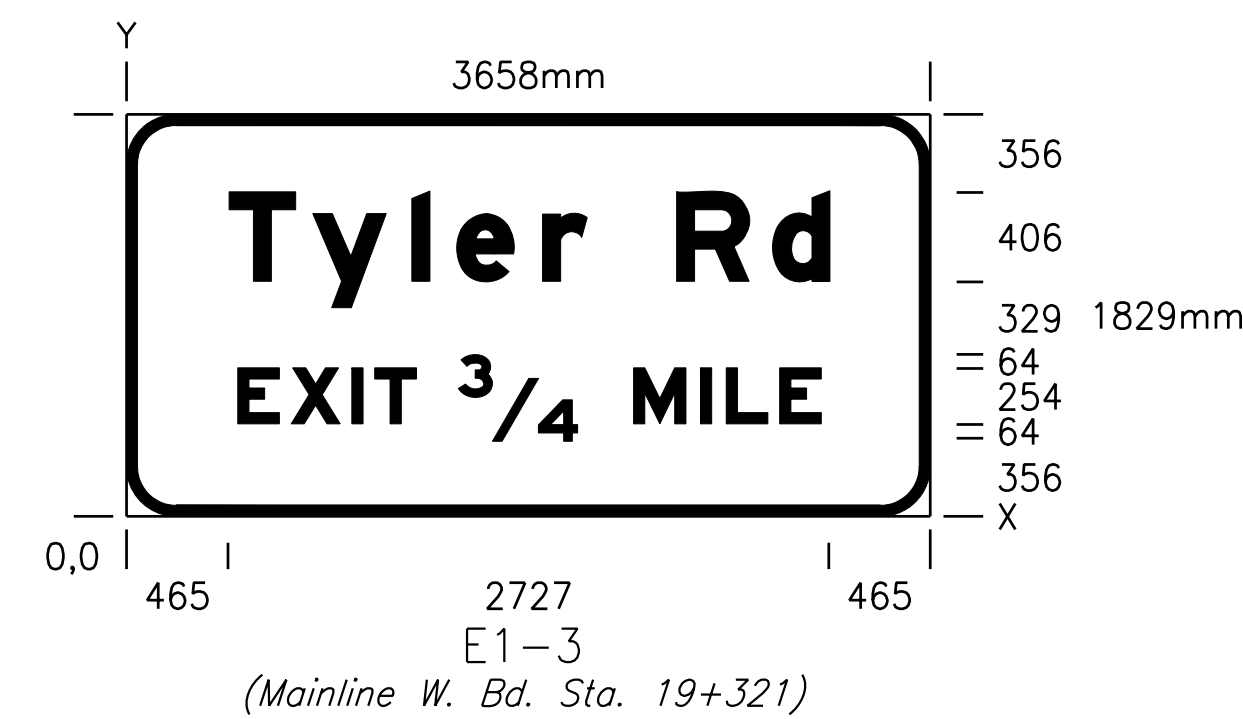
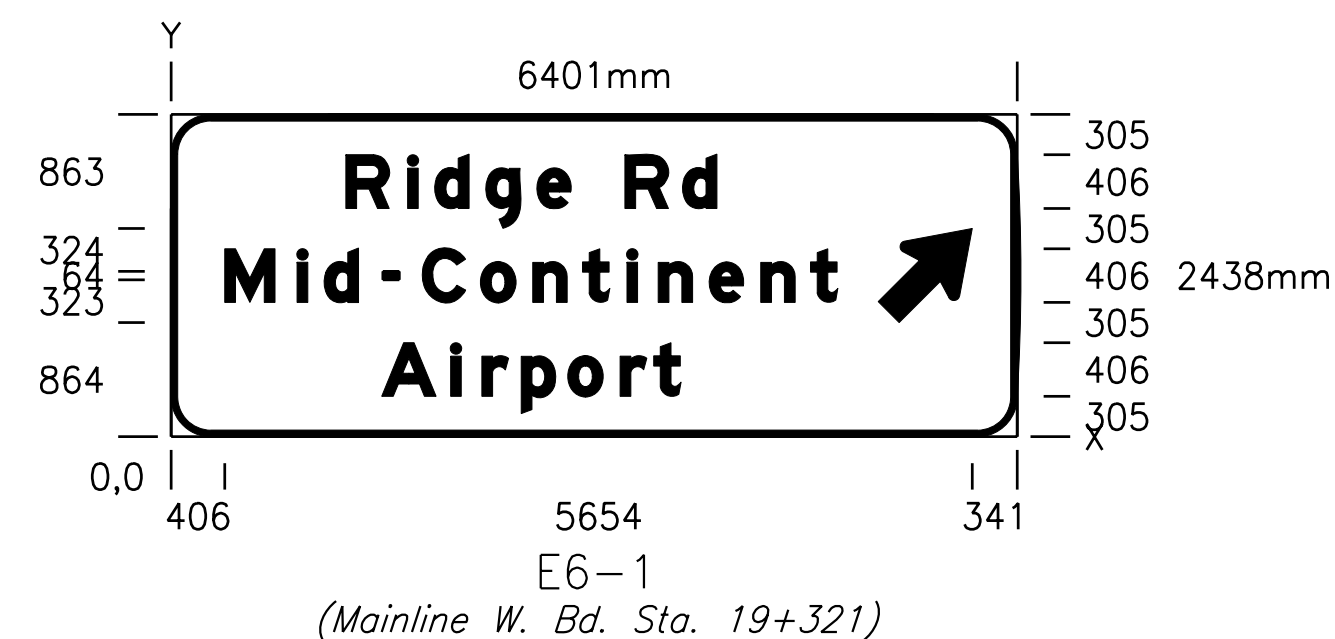


STATE	PROJECT NO.	YEAR	SHEET NO.	TOTAL SHEETS
KANSAS	54-87 K-6657-01	2002	741	1122

DATE	
BY	
REFERENCES NOTED	
REFERENCES CHECKED	

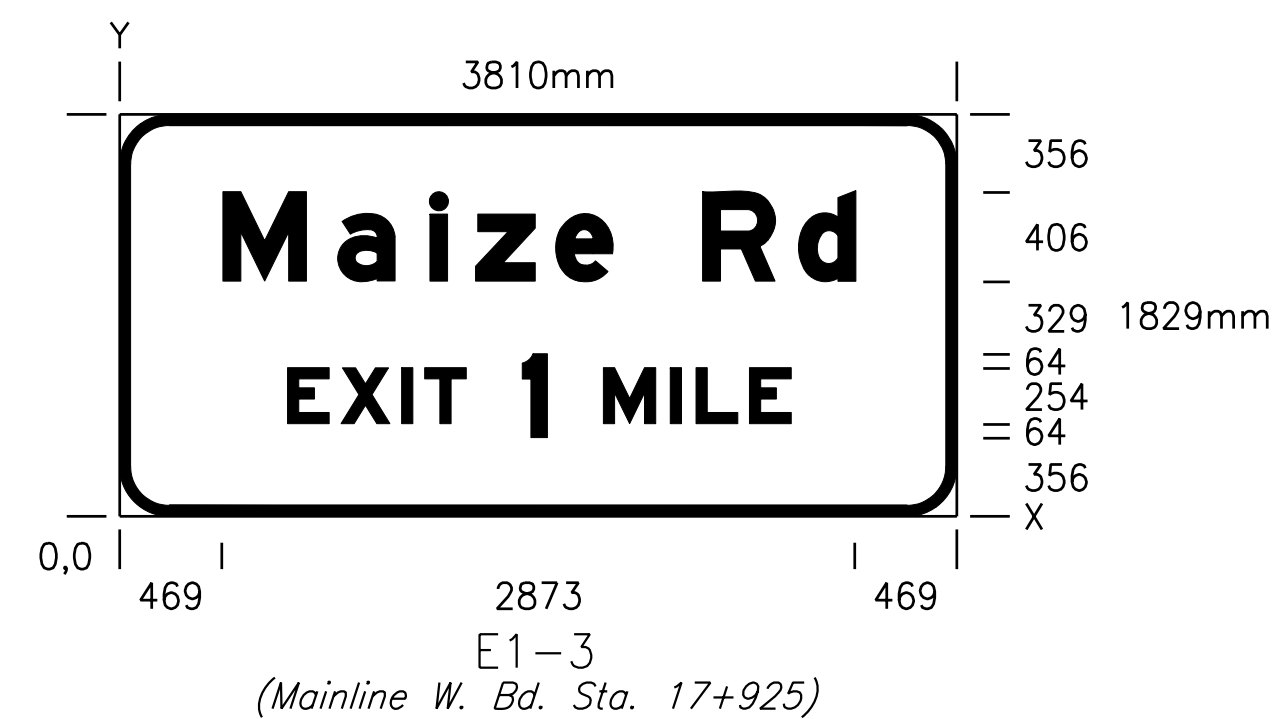

DSWR: RPG OPER: DRP SCALE: 1:500
 11/1997/97.362/As-Builts/dgn/s/Vol_4/Sh 741-layouts.dgn Last Rev: 10-3-07 By: gdr

GENERAL NOTE:
All Copy to be E-Modified

Shop drawings of Sign Layouts
shall be submitted to the Engineer
for approval prior to fabrication.

RECORD DRAWING

No.	Revisions	By	Date
CITY OF WICHITA DESIGN DETAILS FOR REMOVABLE LEGEND SIGNS SEDGWICK COUNTY			
Professional Engineering Consultants, P.A. 303 S. TOPEKA • WICHITA, KANSAS 67202 316-262-2691 • FAX 316-262-3003			
Designed by	RPG	Checked by	WDH
Drawn by	DRP	Date	April, 2002 Job No. 97362