
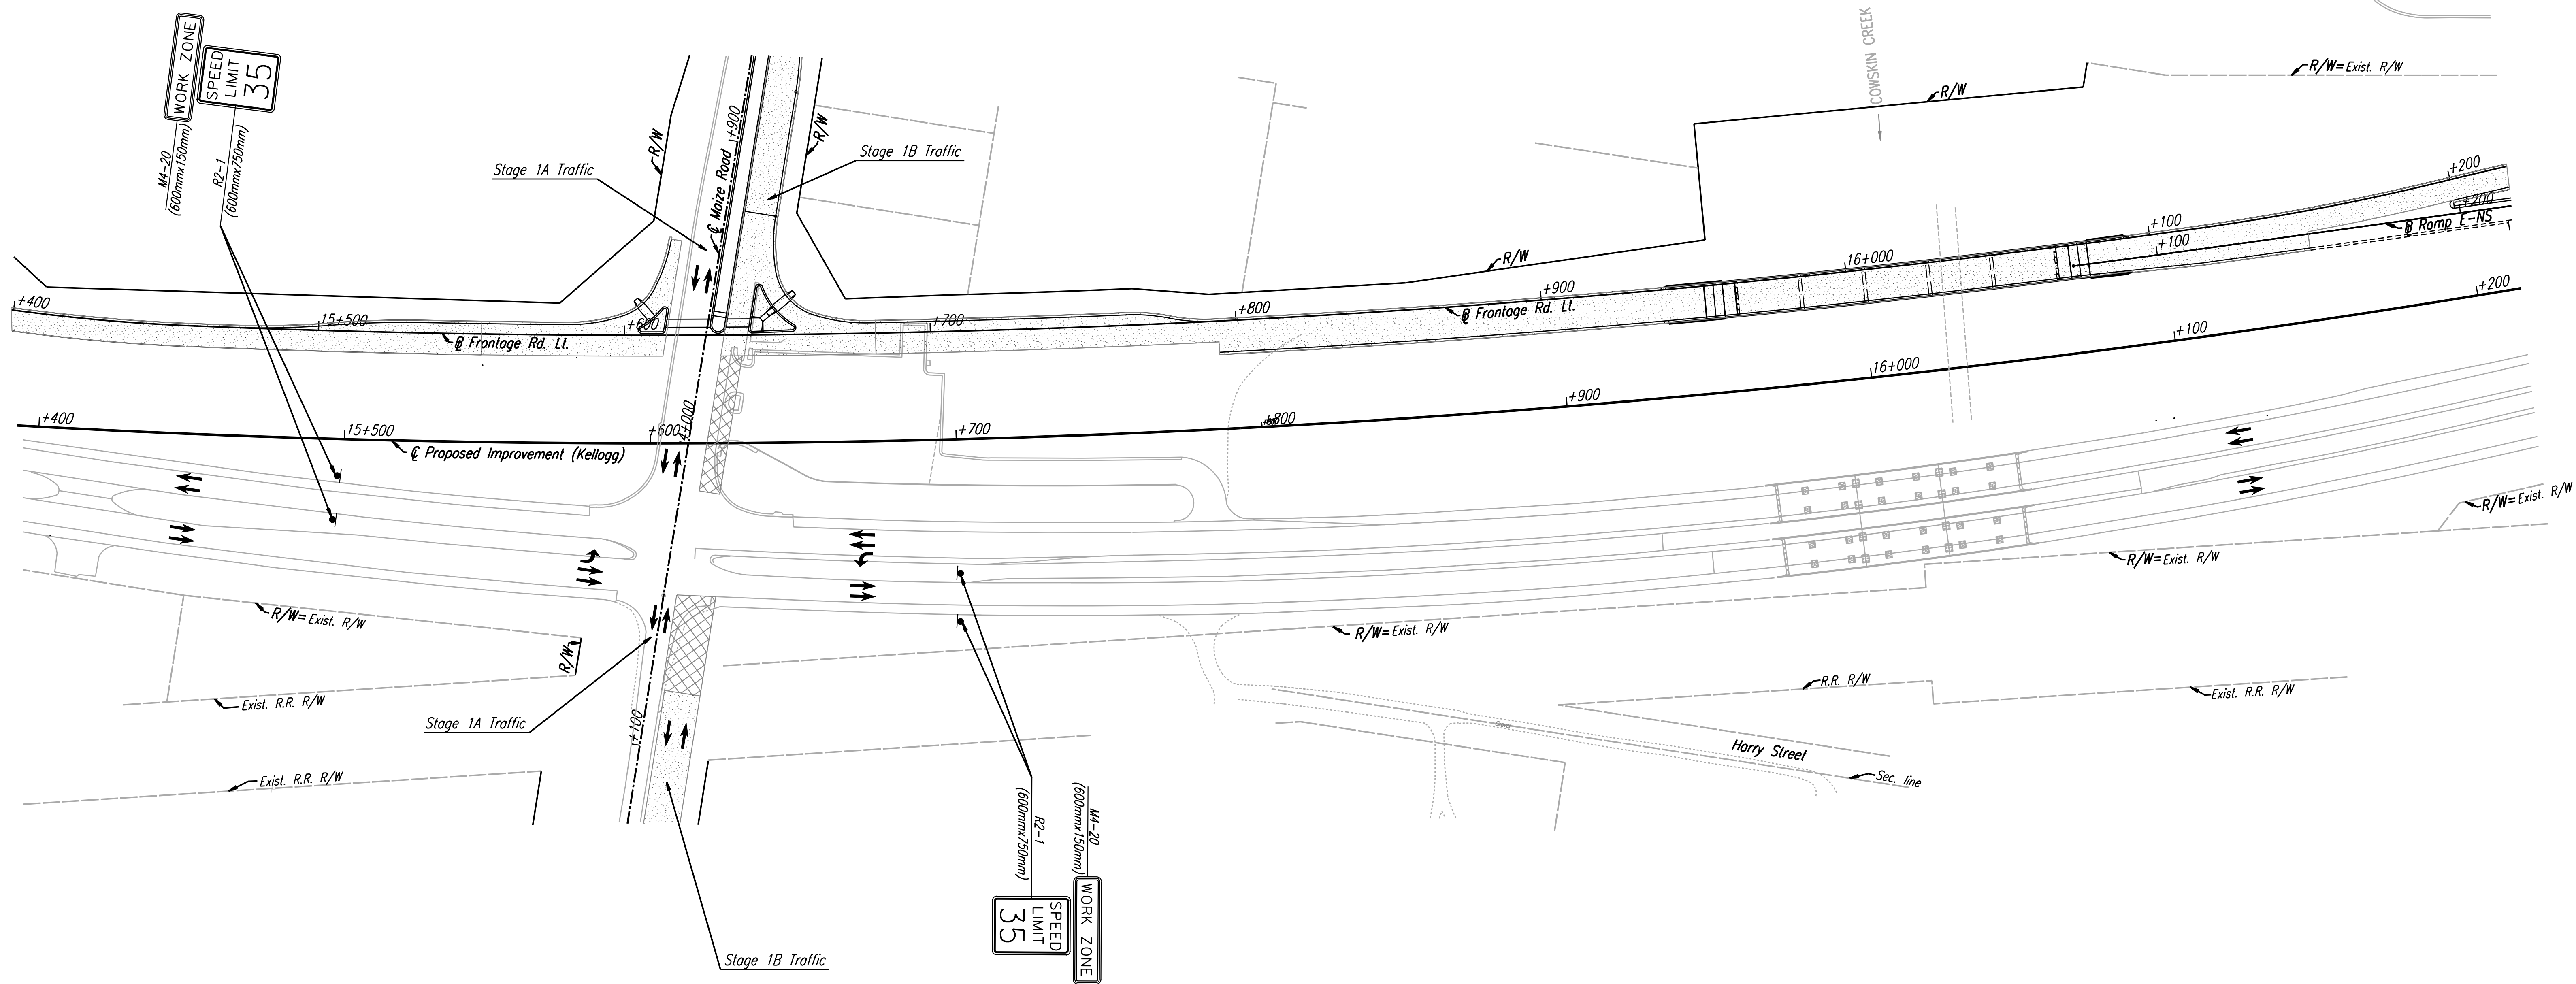


FHWA REGION NO.	STATE	PROJECT NO.	YEAR	SHEET NO.	TOTAL SHEETS
7	KANSAS	54-87 K-6657-01	2002	798	1122


BY	DATE
REFERENCES NOTED	REFERENCES CHECKED

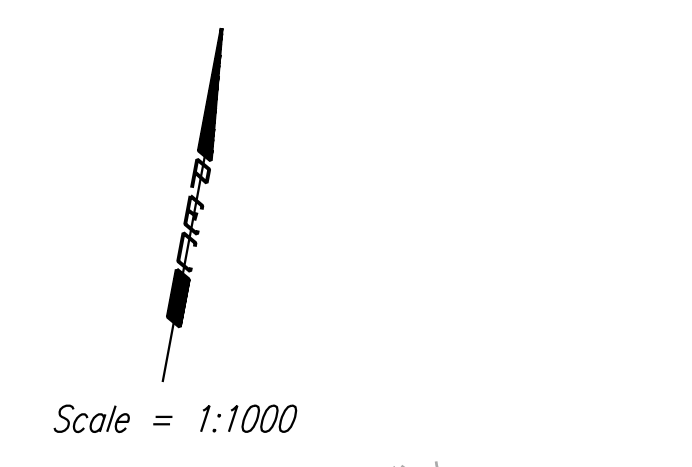

DSNR: OPER: JGP Scale: 1:1000
 1/1997/97-362/As-Builts/dgn/s/Vol 4/1/5h 798-TC Stage 1a-pl154.dgn Last Rev: 10-4-07 By: gdr

See Sh. Nos. 815-818
 for Traffic Control
 on Maize Rd.

 See Sheet Nos. 837 & 838
 for Temporary Traffic Signal.

1			
No.	Revisions	By	Date
CITY OF WICHITA TRAFFIC CONTROL STAGE IA, IB & IC STA. 15+400 TO STA. 16+200 SEDGWICK COUNTY			
 Professional Engineering Consultants, P.A. <small>303 S. TOPEKA • WICHITA, KANSAS 67202 316-262-2691 • FAX 316-262-3003</small>			
Designed by	RPC, RWM	Checked by	WDH
Drawn by	JGP	Date	April, 2002 Job No. 97362