


FHWA REGION NO.	STATE	PROJECT NO.	YEAR	SHEET NO.	TOTAL SHEETS
7	KANSAS	54-87 K-6657-01	2002	799	1122

DATE	
BY	
REFERENCES NOTED	
REFERENCES CHECKED	

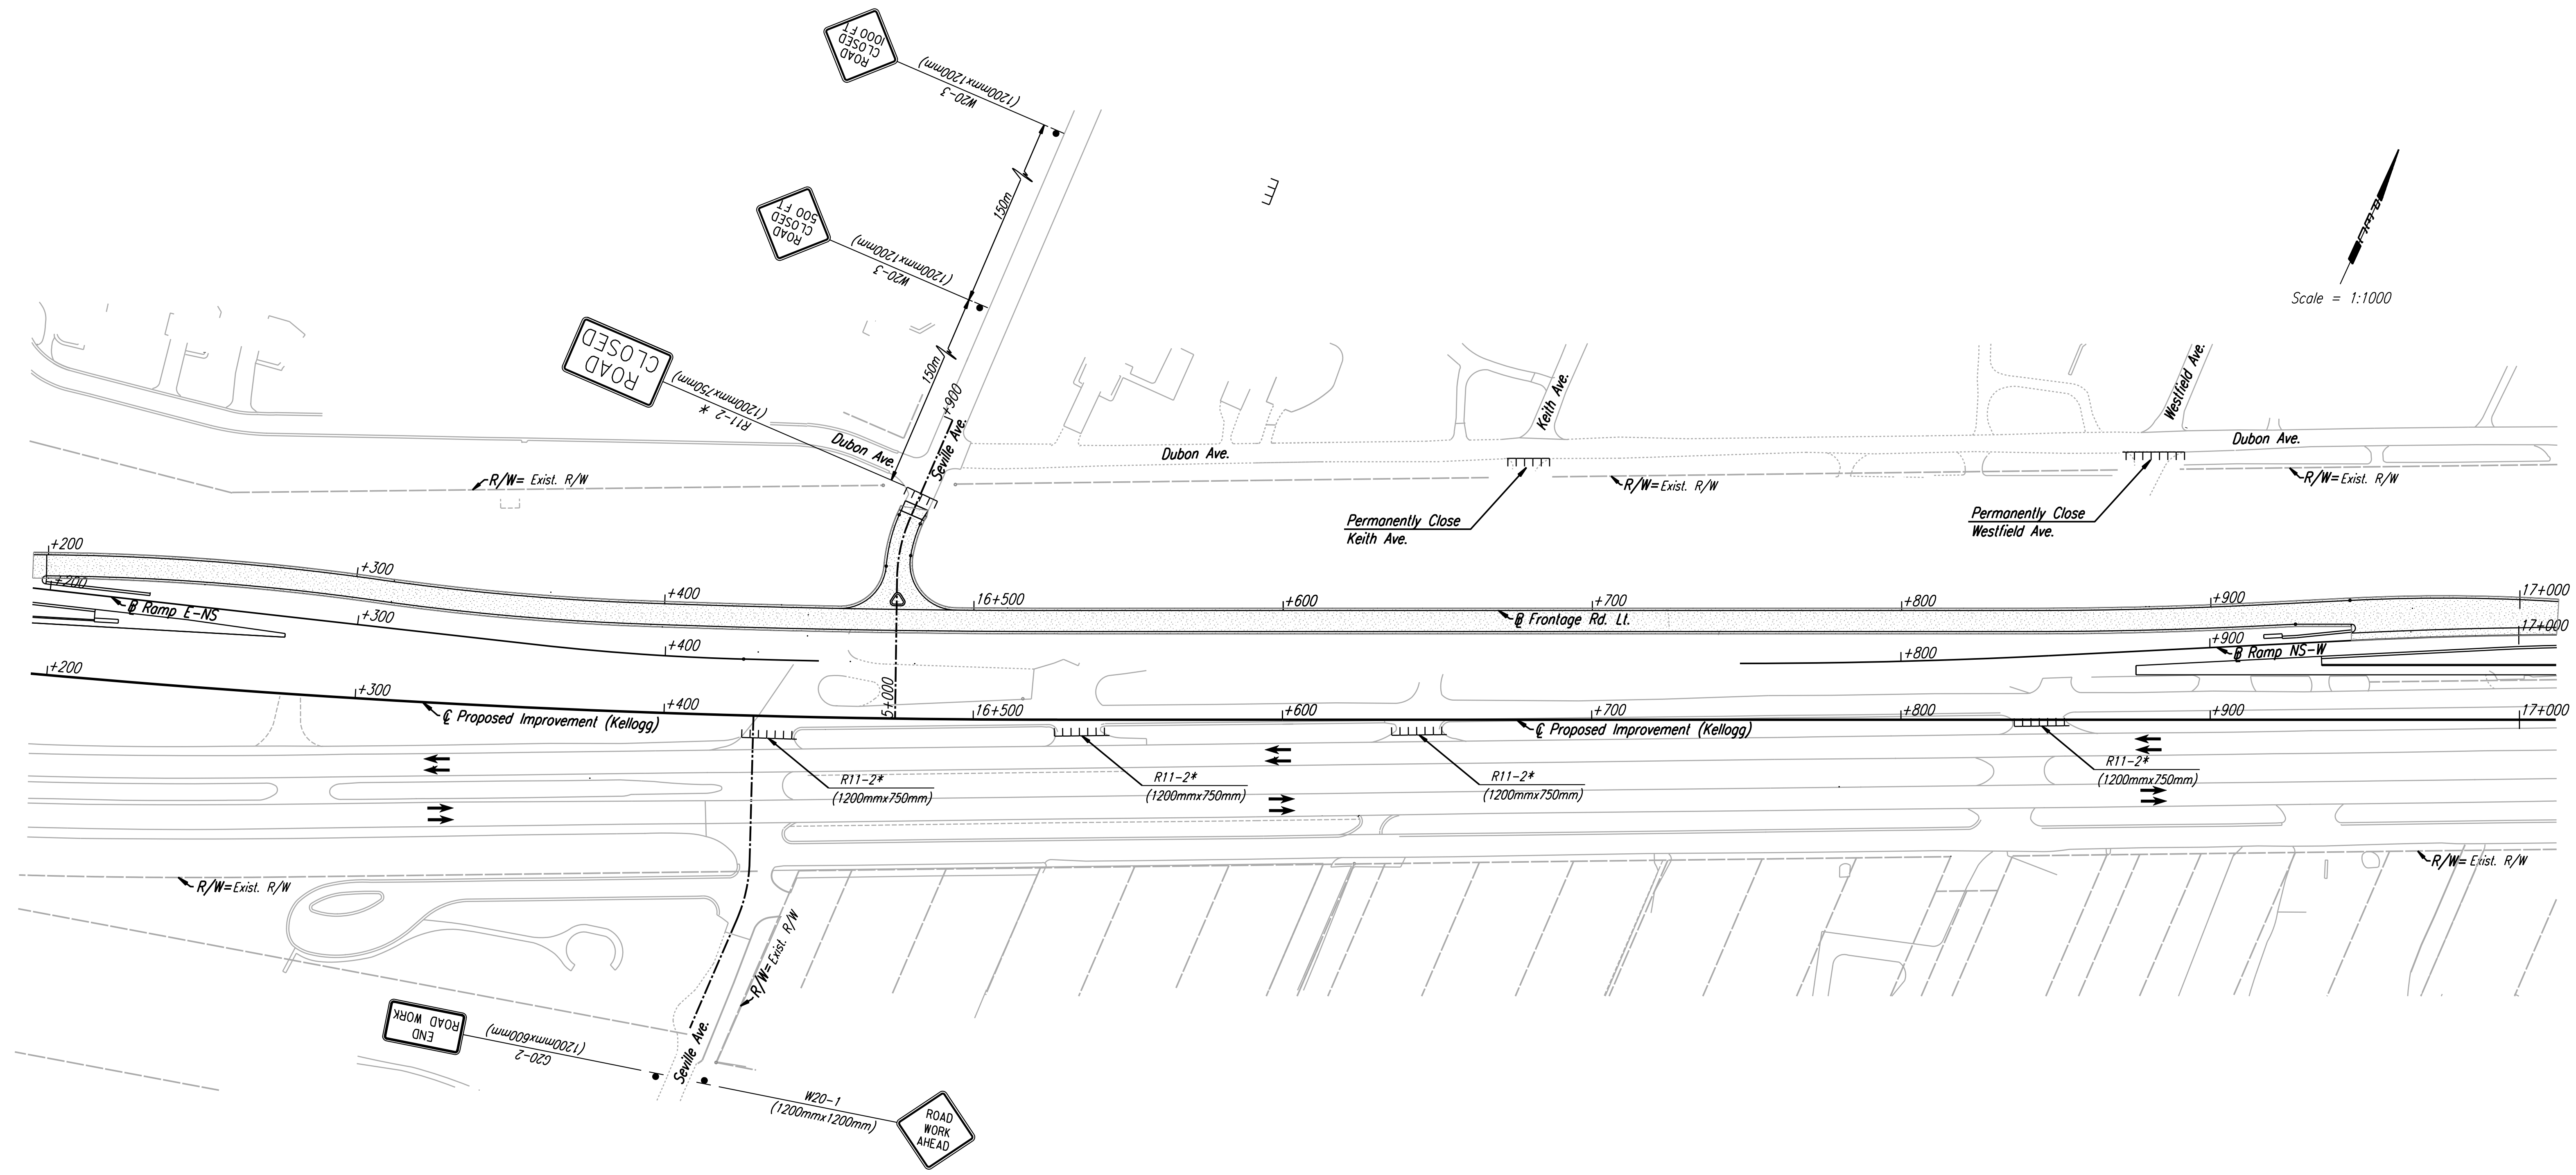

DSWR: RCH OPER: JGP Scale: 1:1000
 I:/1997/97362/As-Built/dgn's/vol 4/Sh 799-TC Stage 1a-pl162.dgn Last Rev: 10-4-07 By: gdr

No.	Revisions	By	Date
CITY OF WICHITA TRAFFIC CONTROL STAGE IA, IB & IC STA. 16+200 TO STA. 17+000 SEDGWICK COUNTY			
Professional Engineering Consultants, P.A. <small>303 S. TOPEKA • WICHITA, KANSAS 67202 316-262-2691 • FAX 316-262-3003</small>			
Designed by	RPG, RWM	Checked by	WDH
Drawn by	JGP	Date	April, 2002 Job No. 97362