
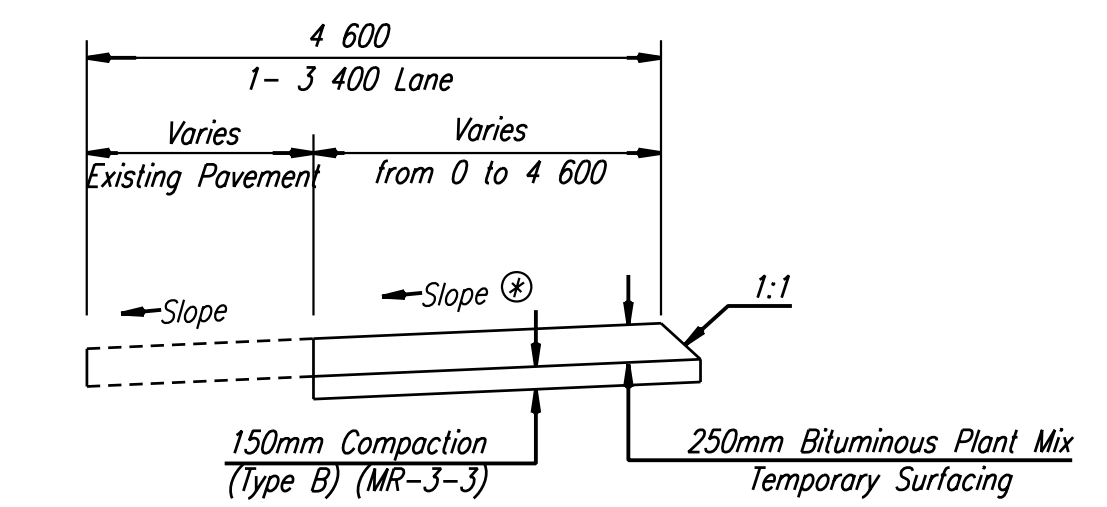


Scale = 1:1000

| | |
|--------------------|--|
| DATE | |
| BY | |
| REFERENCES NOTED | |
| REFERENCES CHECKED | |

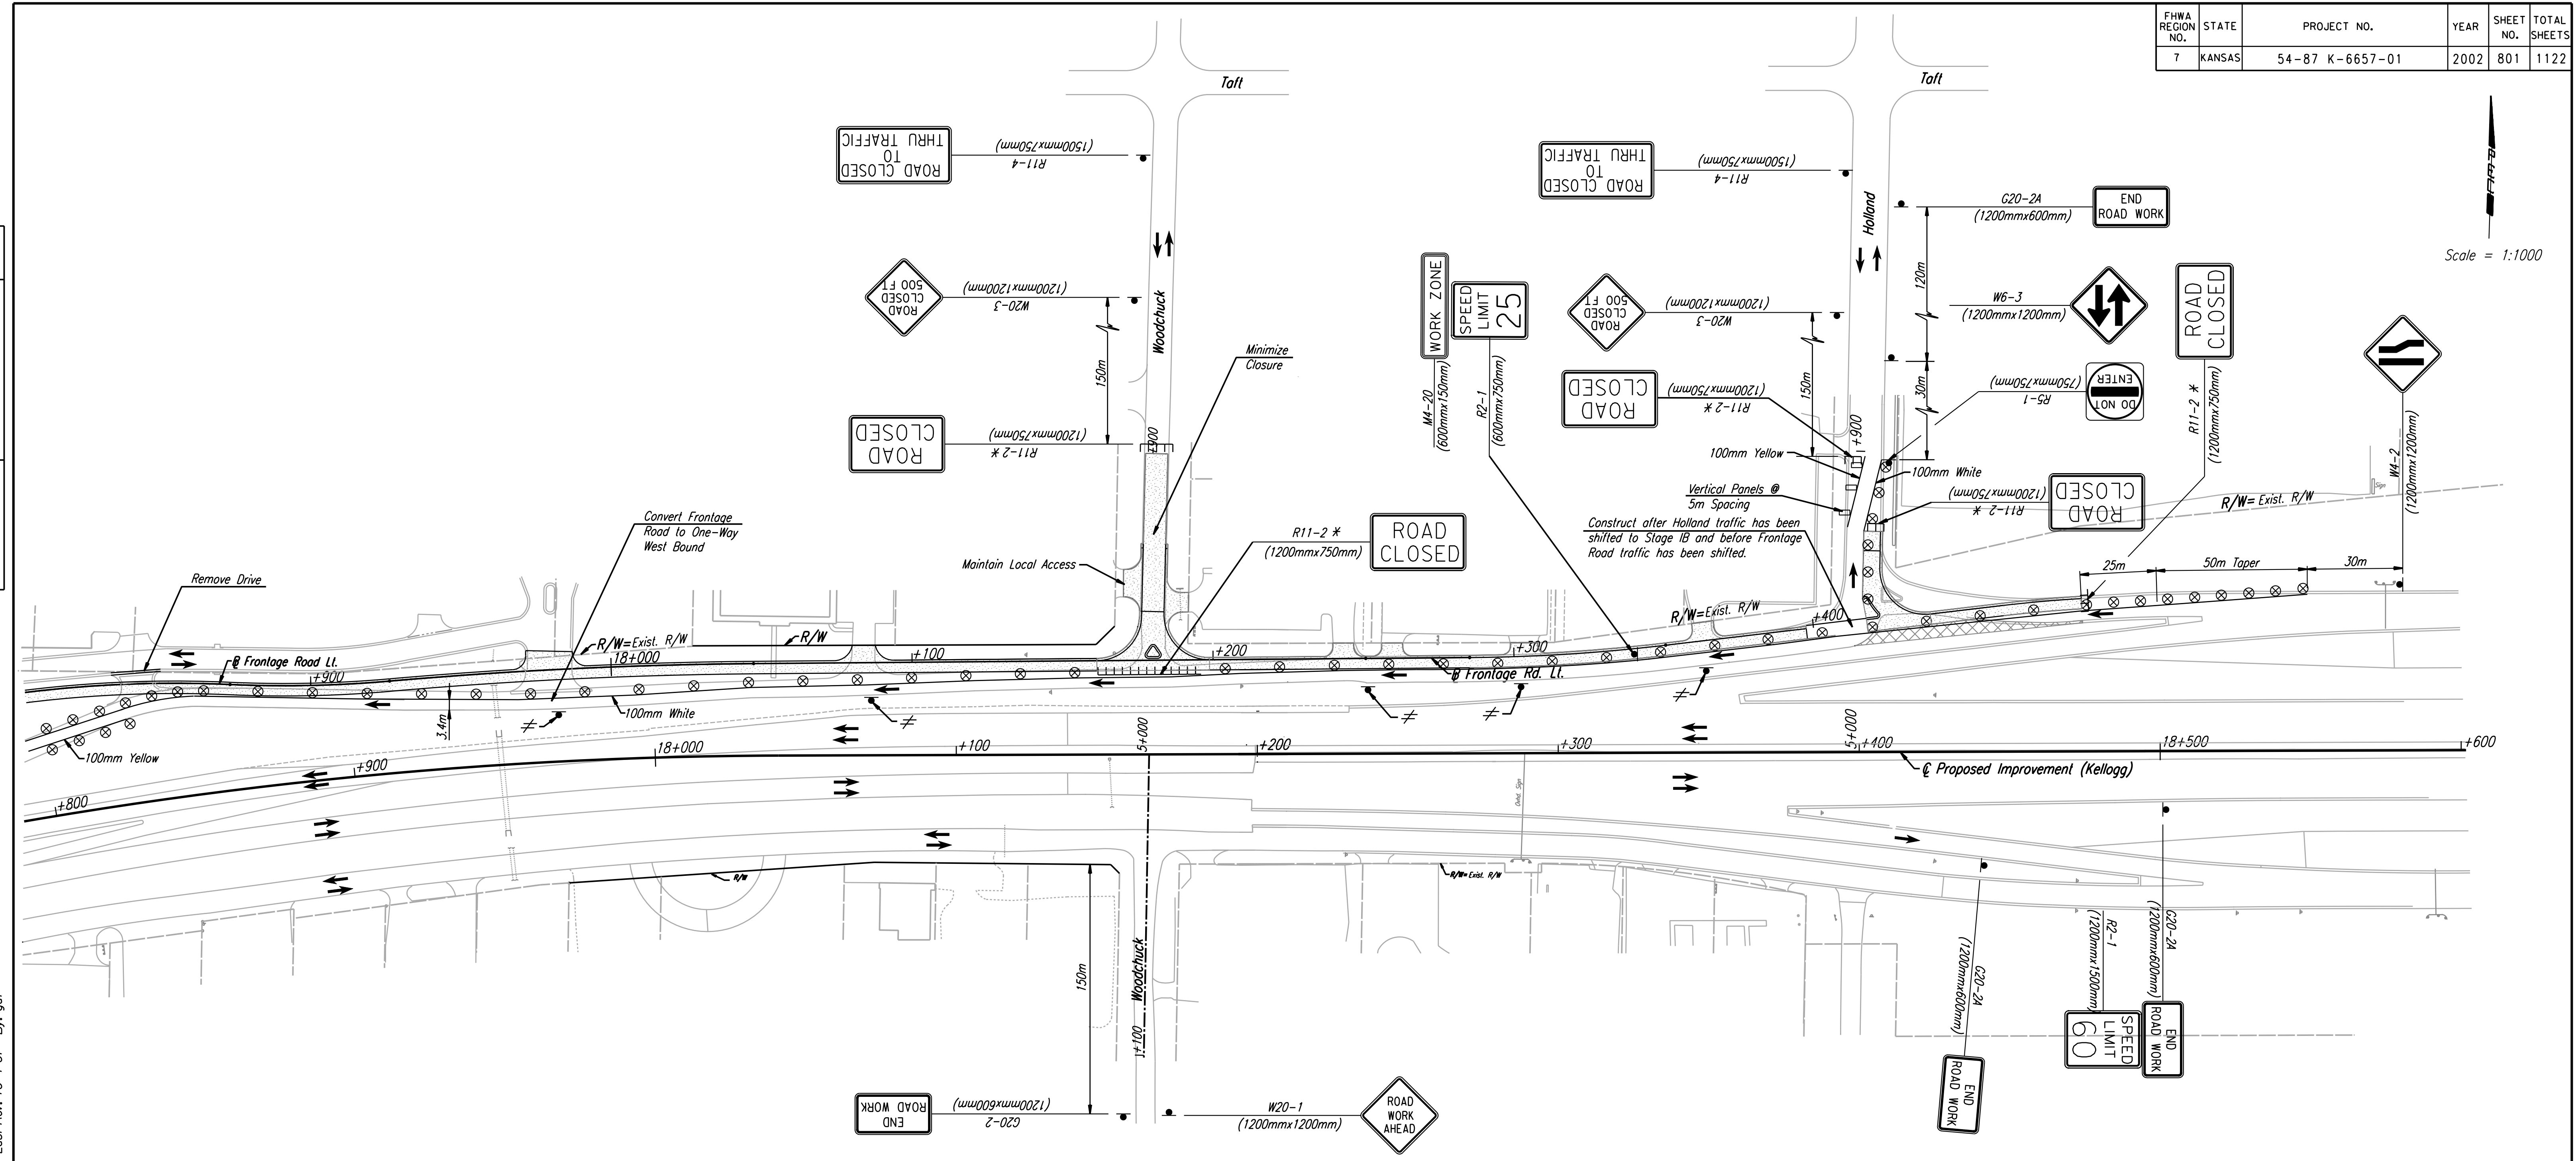

DSWR: RCH OPER: JGP Scale: 1:1000
 1:1997/97/362/As-Built.dgn's/va/4/Sh 801-TC Stage 1a-pl178.dgn Last Rev. 10-4-07 By: gdr

| | | | |
|-----|-----------|----|------|
| No. | Revisions | By | Date |
| | | | |

CITY OF WICHITA
TRAFFIC CONTROL
STAGE IA
STA. 17+800 TO STA. 18+600
SEDGWICK COUNTY

Professional Engineering Consultants, P.A.
 303 S. TOPEKA • WICHITA, KANSAS 67202
 316-262-2691 • FAX 316-262-3003

| | | | |
|-------------|----------|------------|-------------|
| Designed by | RPC, RWM | Checked by | WDH |
| Drawn by | JGP | Date | April, 2002 |
| | | Job No. | 97362 |