


FHWA REGION NO.	STATE	PROJECT NO.	YEAR	SHEET NO.	TOTAL SHEETS
7	KANSAS	54-87 K-6657-01	2002	802	1122

DATE	
BY	
REFERENCES NOTED	
REFERENCES CHECKED	

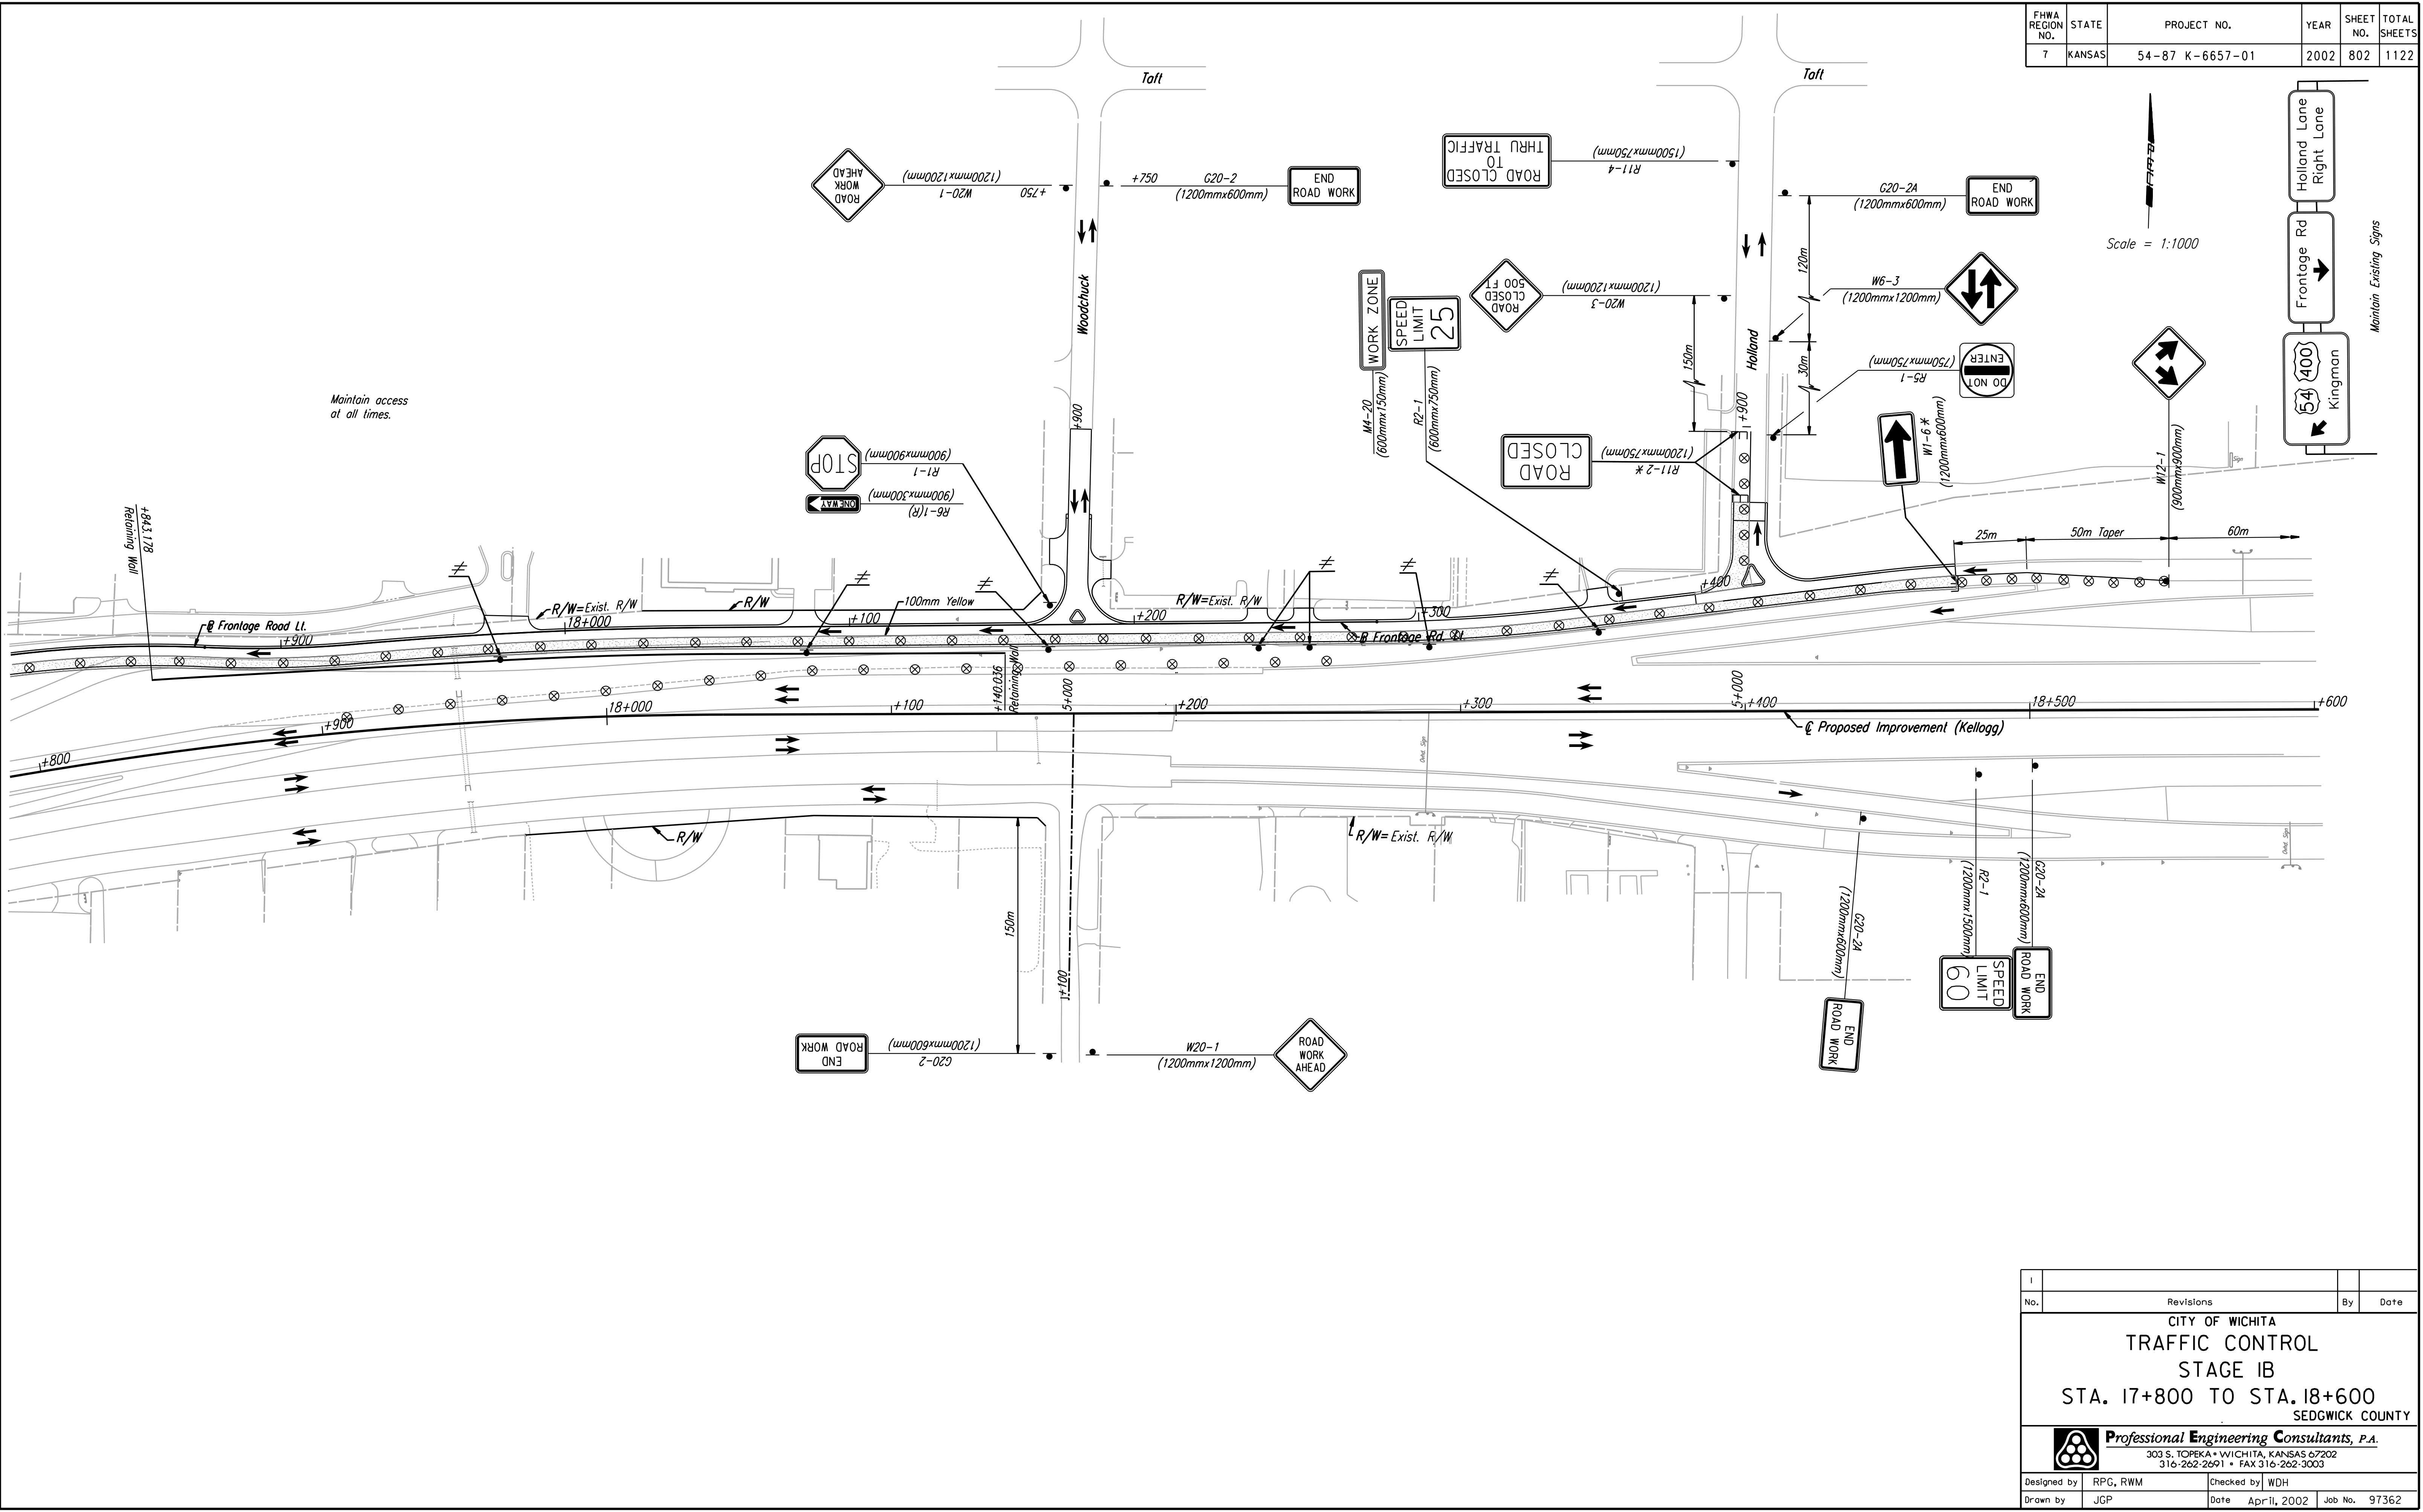

Maintain access at all times.

Scale = 1:1000

Maintain Existing Signs

DSMR: RCH OPER: JGP Scale: 1:1000
 I:/1997/97362/As-Built/dgn's/vol 4/Sh 802-TC Stage 1b-pl178.dgn Last Rev: 10-4-07 By: gdr

No.	Revisions	By	Date

CITY OF WICHITA
 TRAFFIC CONTROL
 STAGE IB
 STA. 17+800 TO STA. 18+600
 SEDGWICK COUNTY

Professional Engineering Consultants, P.A.
 303 S. TOPEKA • WICHITA, KANSAS 67202
 316-262-2691 • FAX 316-262-3003

Designed by	RPC, RWM	Checked by	WDH
Drawn by	JGP	Date	April, 2002
		Job No.	97362