
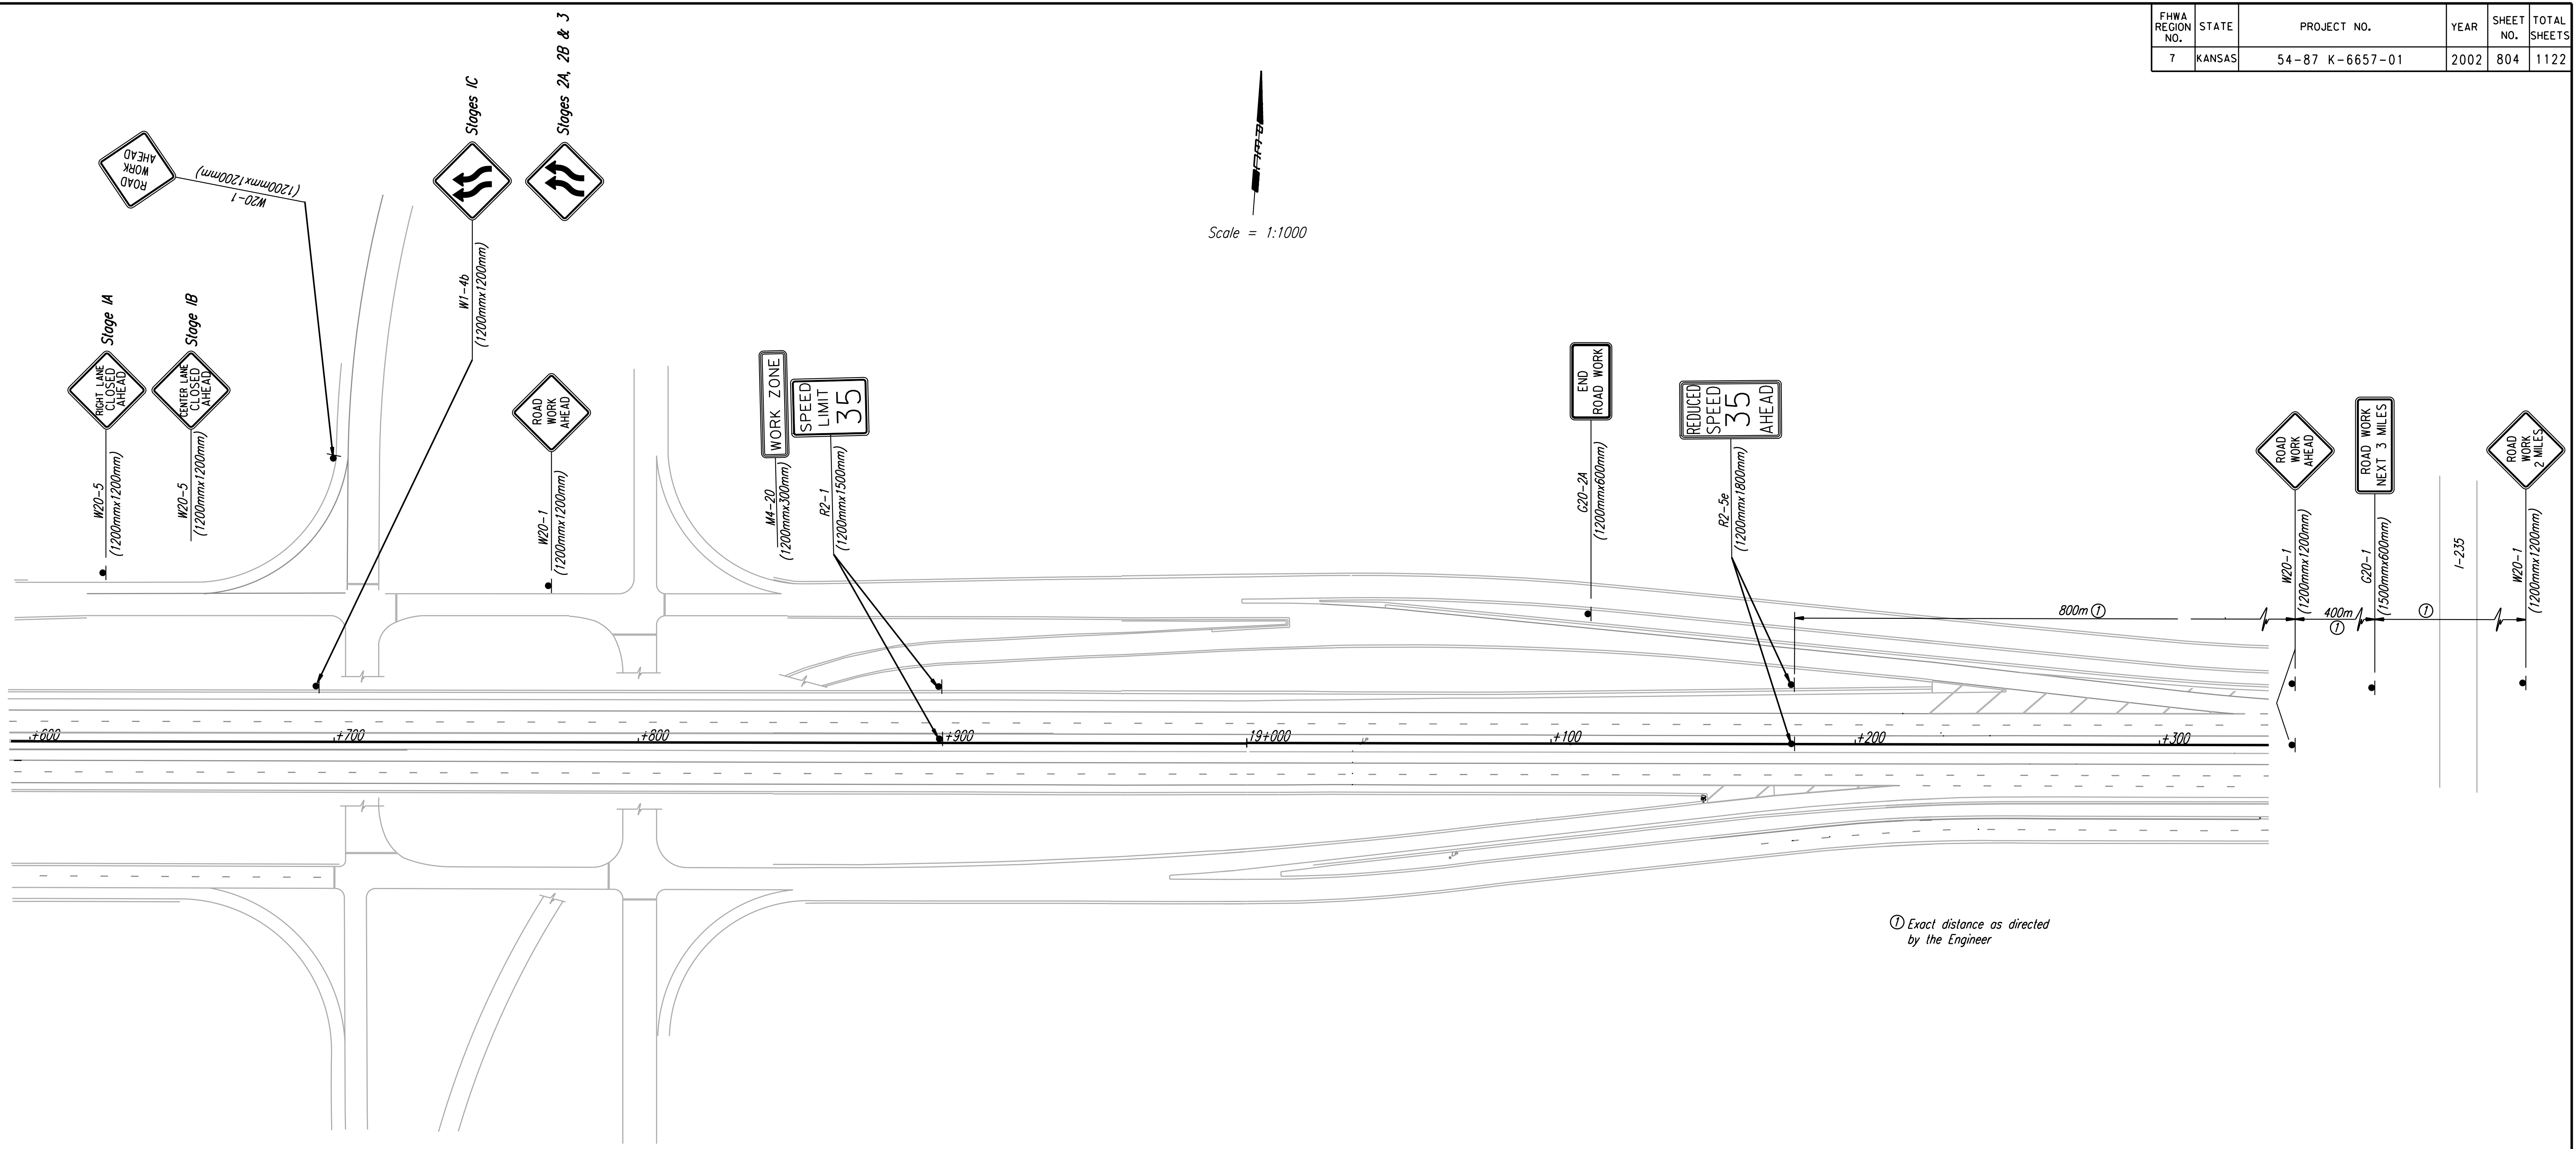


FHWA REGION NO.	STATE	PROJECT NO.	YEAR	SHEET NO.	TOTAL SHEETS
7	KANSAS	54-87 K-6657-01	2002	804	1122

REFERENCES NOTED	BY	DATE
REFERENCES CHECKED		

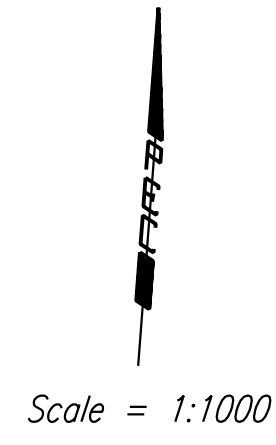

① Exact distance as directed by the Engineer

DSMR: RCH OPER: JGP Scale: 1:1000
 I:/1997/97362/As-Builts/dgn's/vol 4/Sh 804-TC Stage 1a-pl186.dgn Last Rev: 10-4-07 By: gdr

No.	Revisions	By	Date
CITY OF WICHITA TRAFFIC CONTROL ALL STAGES STA. 18+600 TO STA. 19+300 SEDGWICK COUNTY			
Professional Engineering Consultants, P.A. 303 S. TOPEKA • WICHITA, KANSAS 67202 316-262-2691 • FAX 316-262-3003			
Designed by	RPG, RWM	Checked by	WDH
Drawn by	JGP	Date	April, 2002 Job No. 97362