



FHWA REGION NO.	STATE	PROJECT NO.	YEAR	SHEET NO.	TOTAL SHEETS
7	KANSAS	54-87 K-6657-01			

DATE	
BY	
REFERENCES NOTED	
REFERENCES CHECKED	

Scale = 1:1000

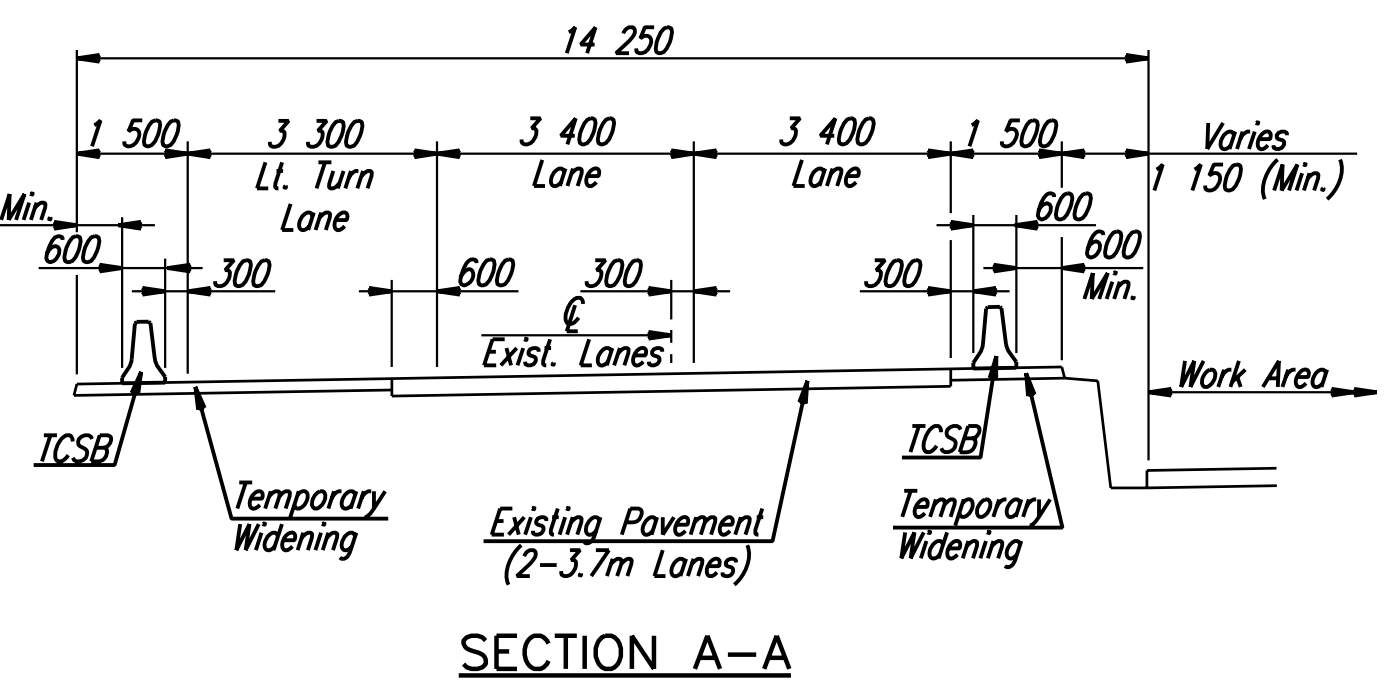

DSNR: OPER: JGP Scale: 1:1000
 I:/1997/97362/As-Builts/dgn/s/Vol 4/5h 807-TC Stage 2a-pl154rev2b.dgn Last Rev: 10-4-07 By: gdr

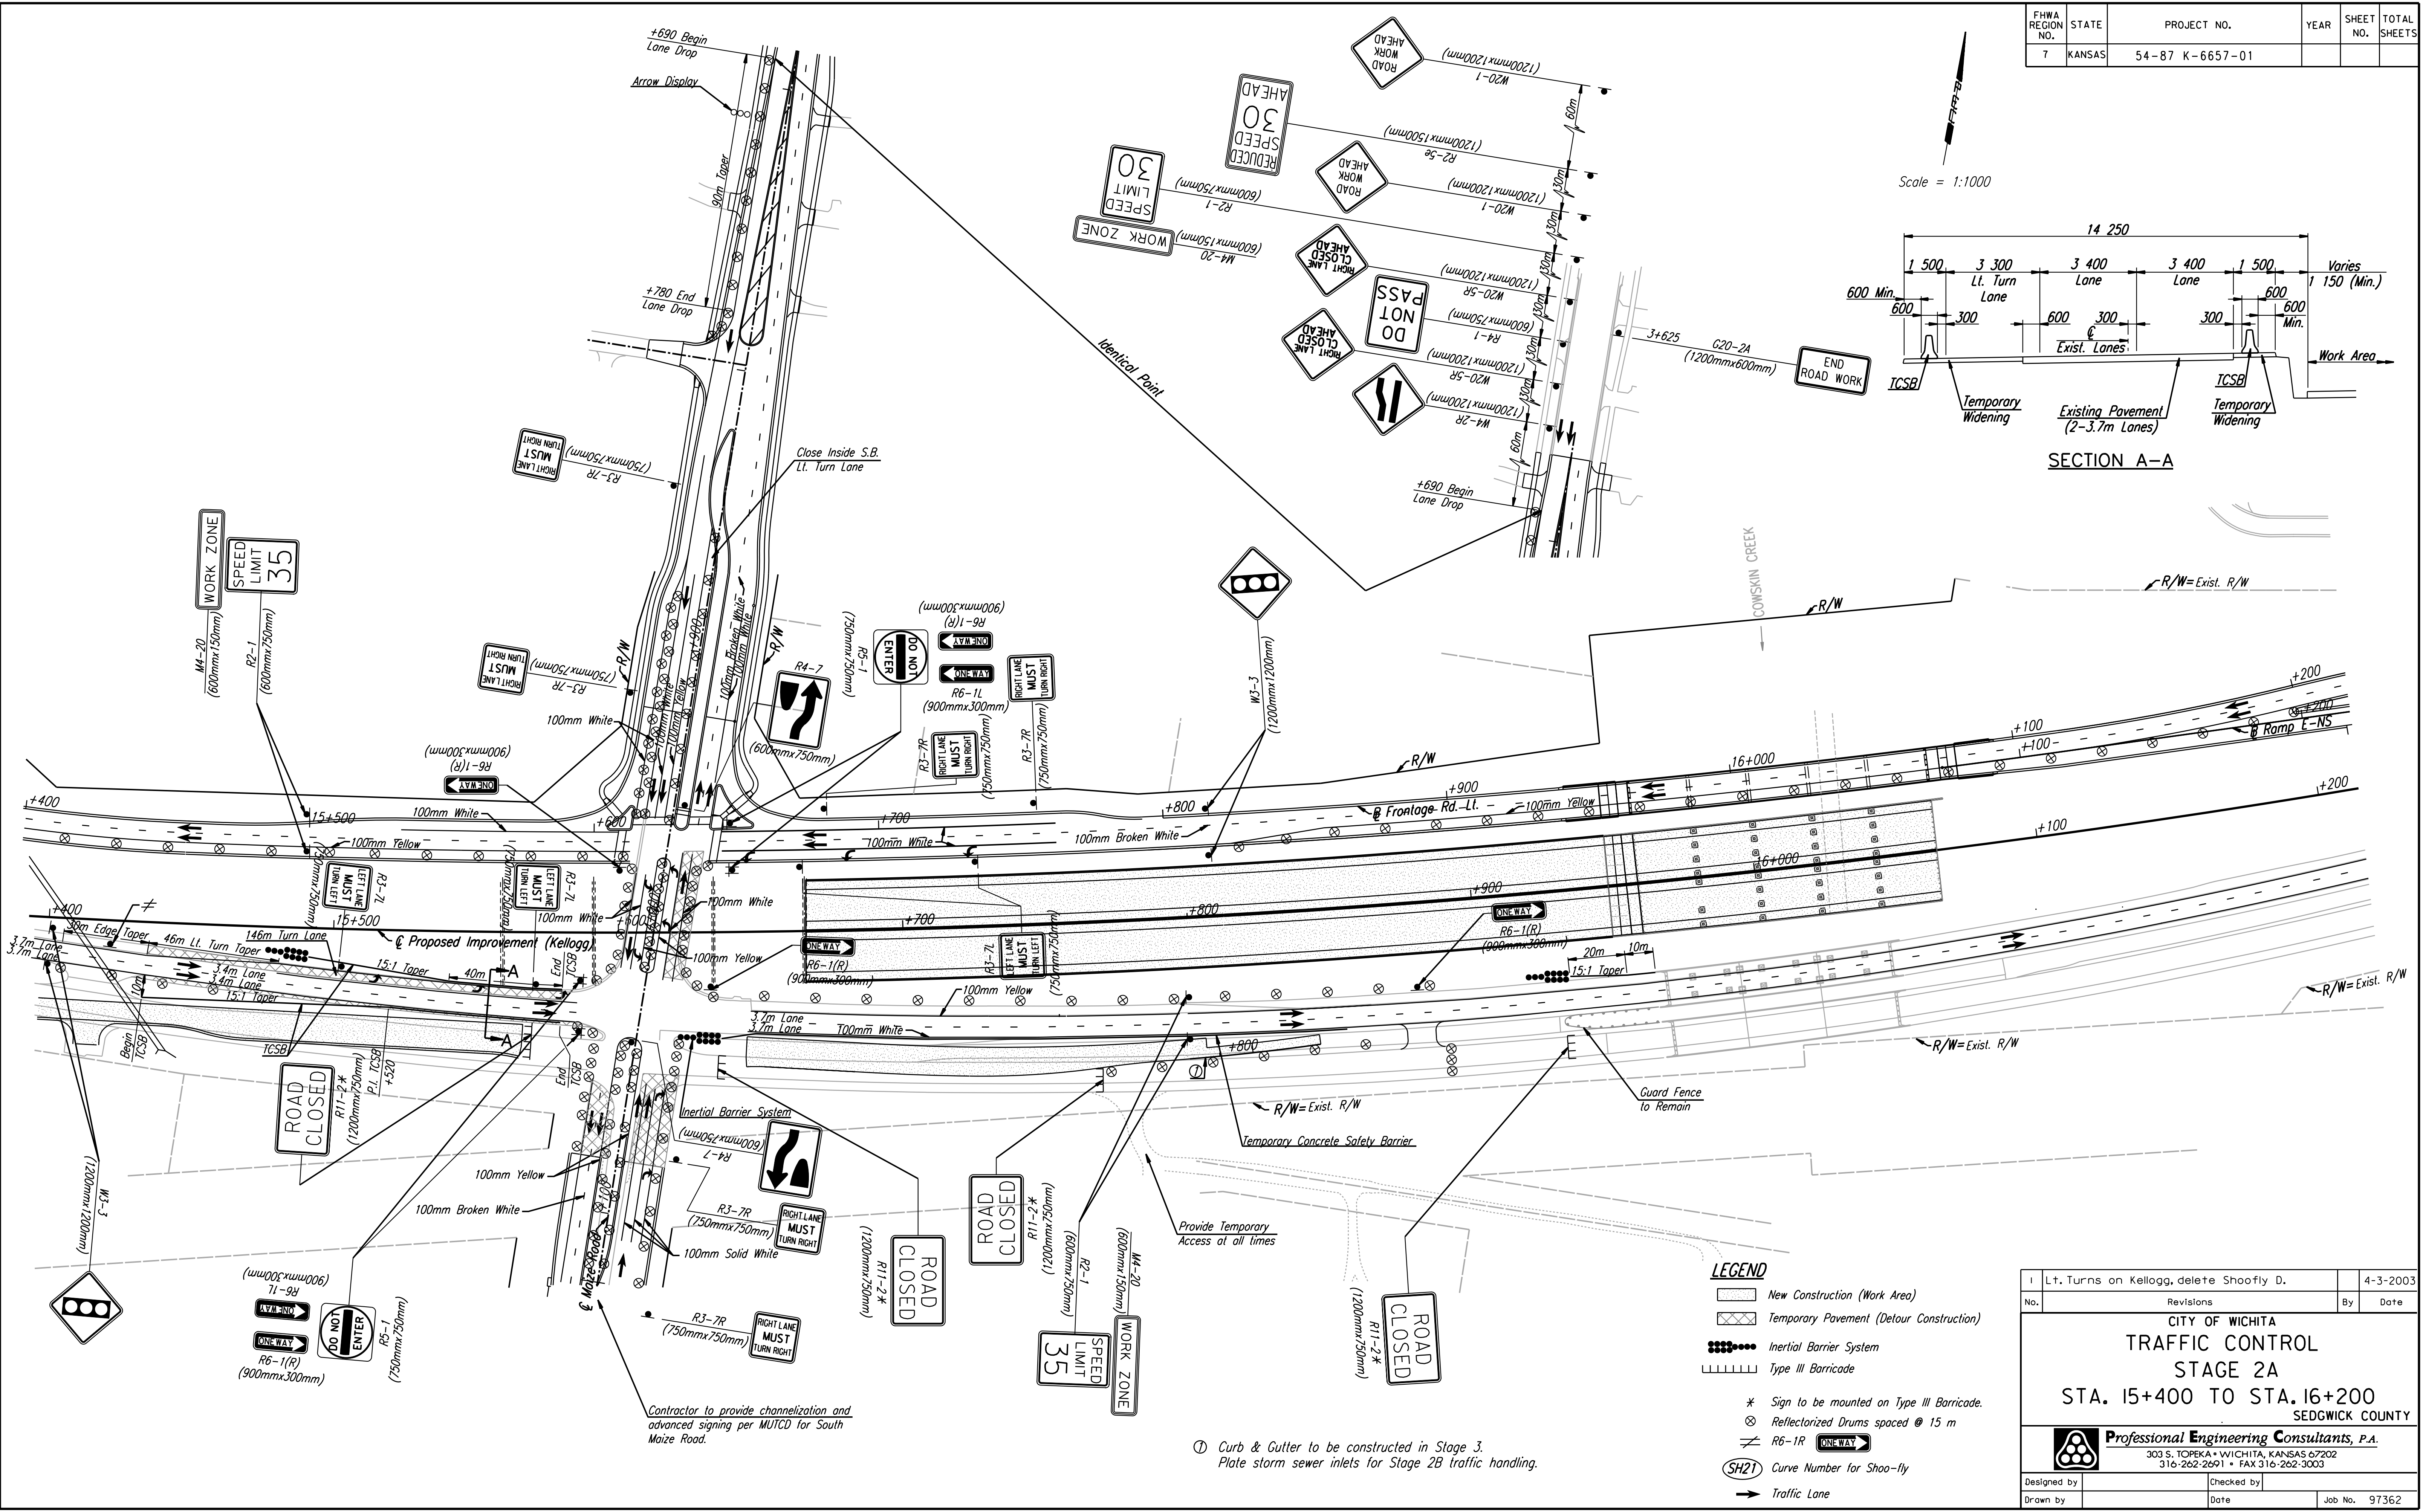

- LEGEND**
- New Construction (Work Area)
 - Temporary Pavement (Detour Construction)
 - Inertial Barrier System
 - Type III Barricade
 - * Sign to be mounted on Type III Barricade.
 - ⊗ Reflectorized Drums spaced @ 15 m
 - ⊗ SH21 Curve Number for Shoo-fly
 - Traffic Lane

1	Lt. Turns on Kellogg, delete Shoo-fly D.	4-3-2003
No.	Revisions	By Date
CITY OF WICHITA TRAFFIC CONTROL STAGE 2A STA. 15+400 TO STA. 16+200 SEDGWICK COUNTY		
Professional Engineering Consultants, P.A. 303 S. TOPEKA • WICHITA, KANSAS 67202 316-262-2691 • FAX 316-262-3003		
Designed by	Checked by	
Drawn by	Date	Job No. 97362

① Curb & Gutter to be constructed in Stage 3.
 Plate storm sewer inlets for Stage 2B traffic handling.

Contractor to provide channelization and advanced signing per MUTCD for South Maize Road.