


DATE	
BY	
REFERENCES NOTED	
REFERENCES CHECKED	

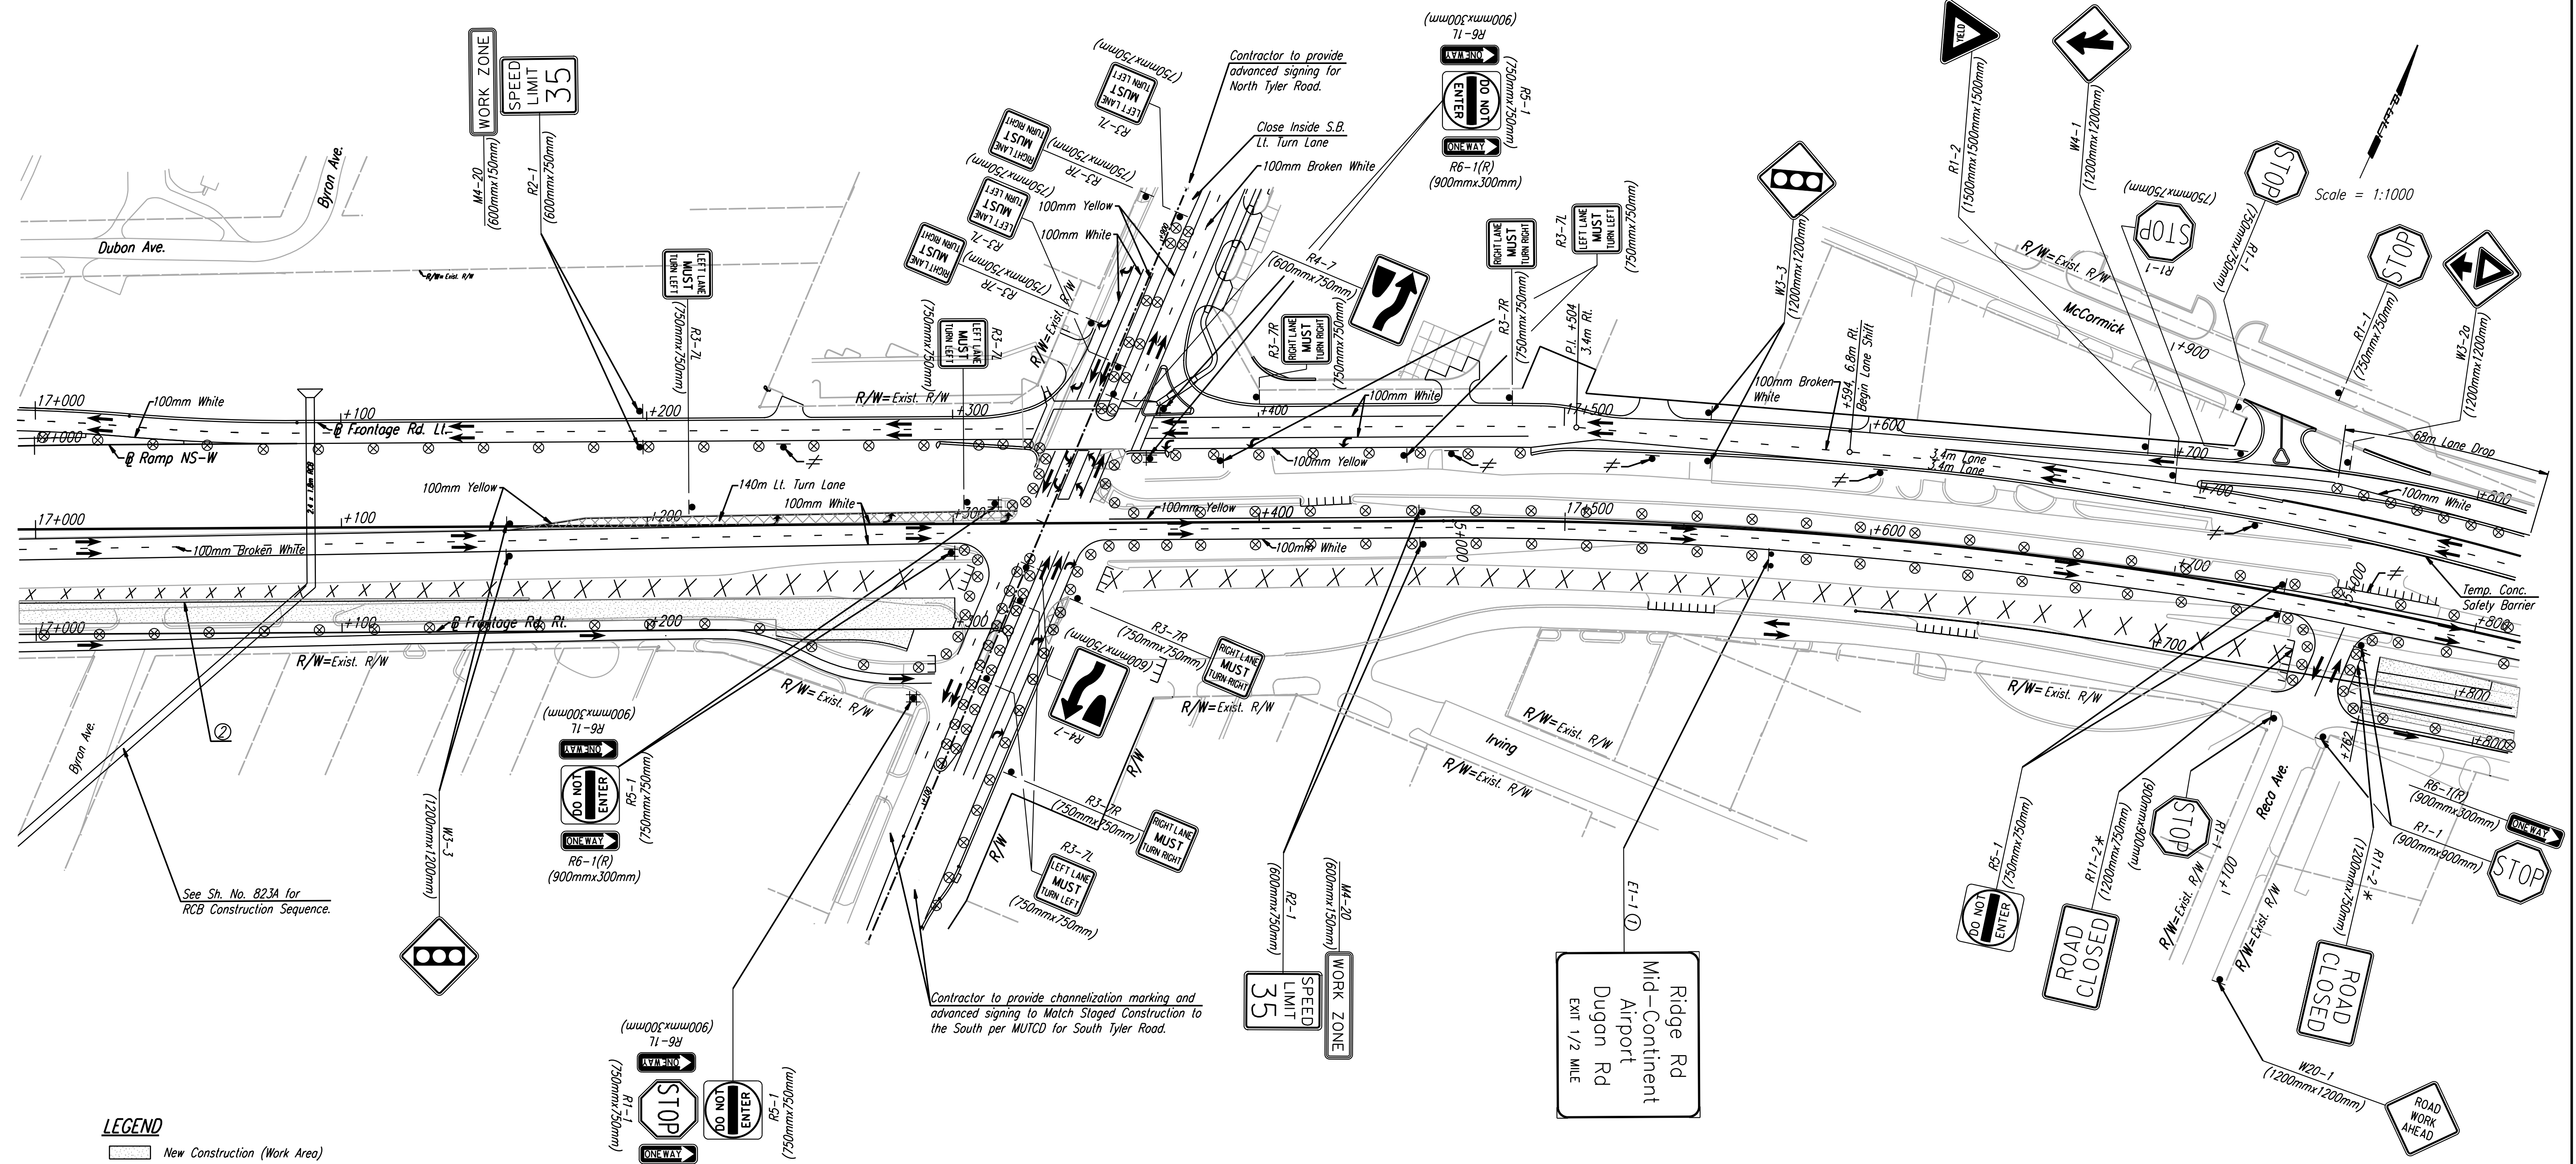

LEGEND

- New Construction (Work Area)
- Temporary Pavement (Detour Construction)
- Inertial Barrier System
- Type III Barricade
- * Sign to be mounted on Type III Barricade.
- Reflectorized Drums spaced @ 15 m
- R6-1R
- SH21 Curve Number for Shoo-ly
- Traffic Lane

R6-11 (900mmx300mm)
 R5-1 (750mmx750mm)
 R6-1(R) (900mmx300mm)
 R1-1 (750mmx750mm)

Ridge Rd
Mid-Continent
Airport
Dugan Rd
EXIT 1/2 MILE

- ① May use existing sign relocated from Sta. 17+460.
- ② Contractor to verify that there is enough room to construct mainline retaining wall prior to constructing inside lane of Fr. Rd. Rt.

1	Lt. Turn Lanes on Kellogg & Yield @ Recla.	4-7-2003
No.	Revisions	By Date
CITY OF WICHITA TRAFFIC CONTROL STAGE 2A STA. 17+000 TO STA. 17+800 SEDGWICK COUNTY		
Professional Engineering Consultants, P.A. 303 S. TOPEKA • WICHITA, KANSAS 67202 316-262-2691 • FAX 316-262-3003		
Designed by	WDH	Checked by
Drawn by		Date
		Job No. 97362

DSMB: OPER: JGP Scale: 1:1000
 12/1997/97362/As-Built/dgn/s/Vol 4/Sh 809-Tc Stage 2a-pl/70rev.dgn Last Rev: 10-4-07 By: gdr