



See Sh. Nos. 837 & 842 for Temporary Traffic Signal.
See Sh. Nos. 815-818 for Traffic Control on Tyler Rd.

DATE	
BY	
REFERENCES NOTED	
REFERENCES CHECKED	

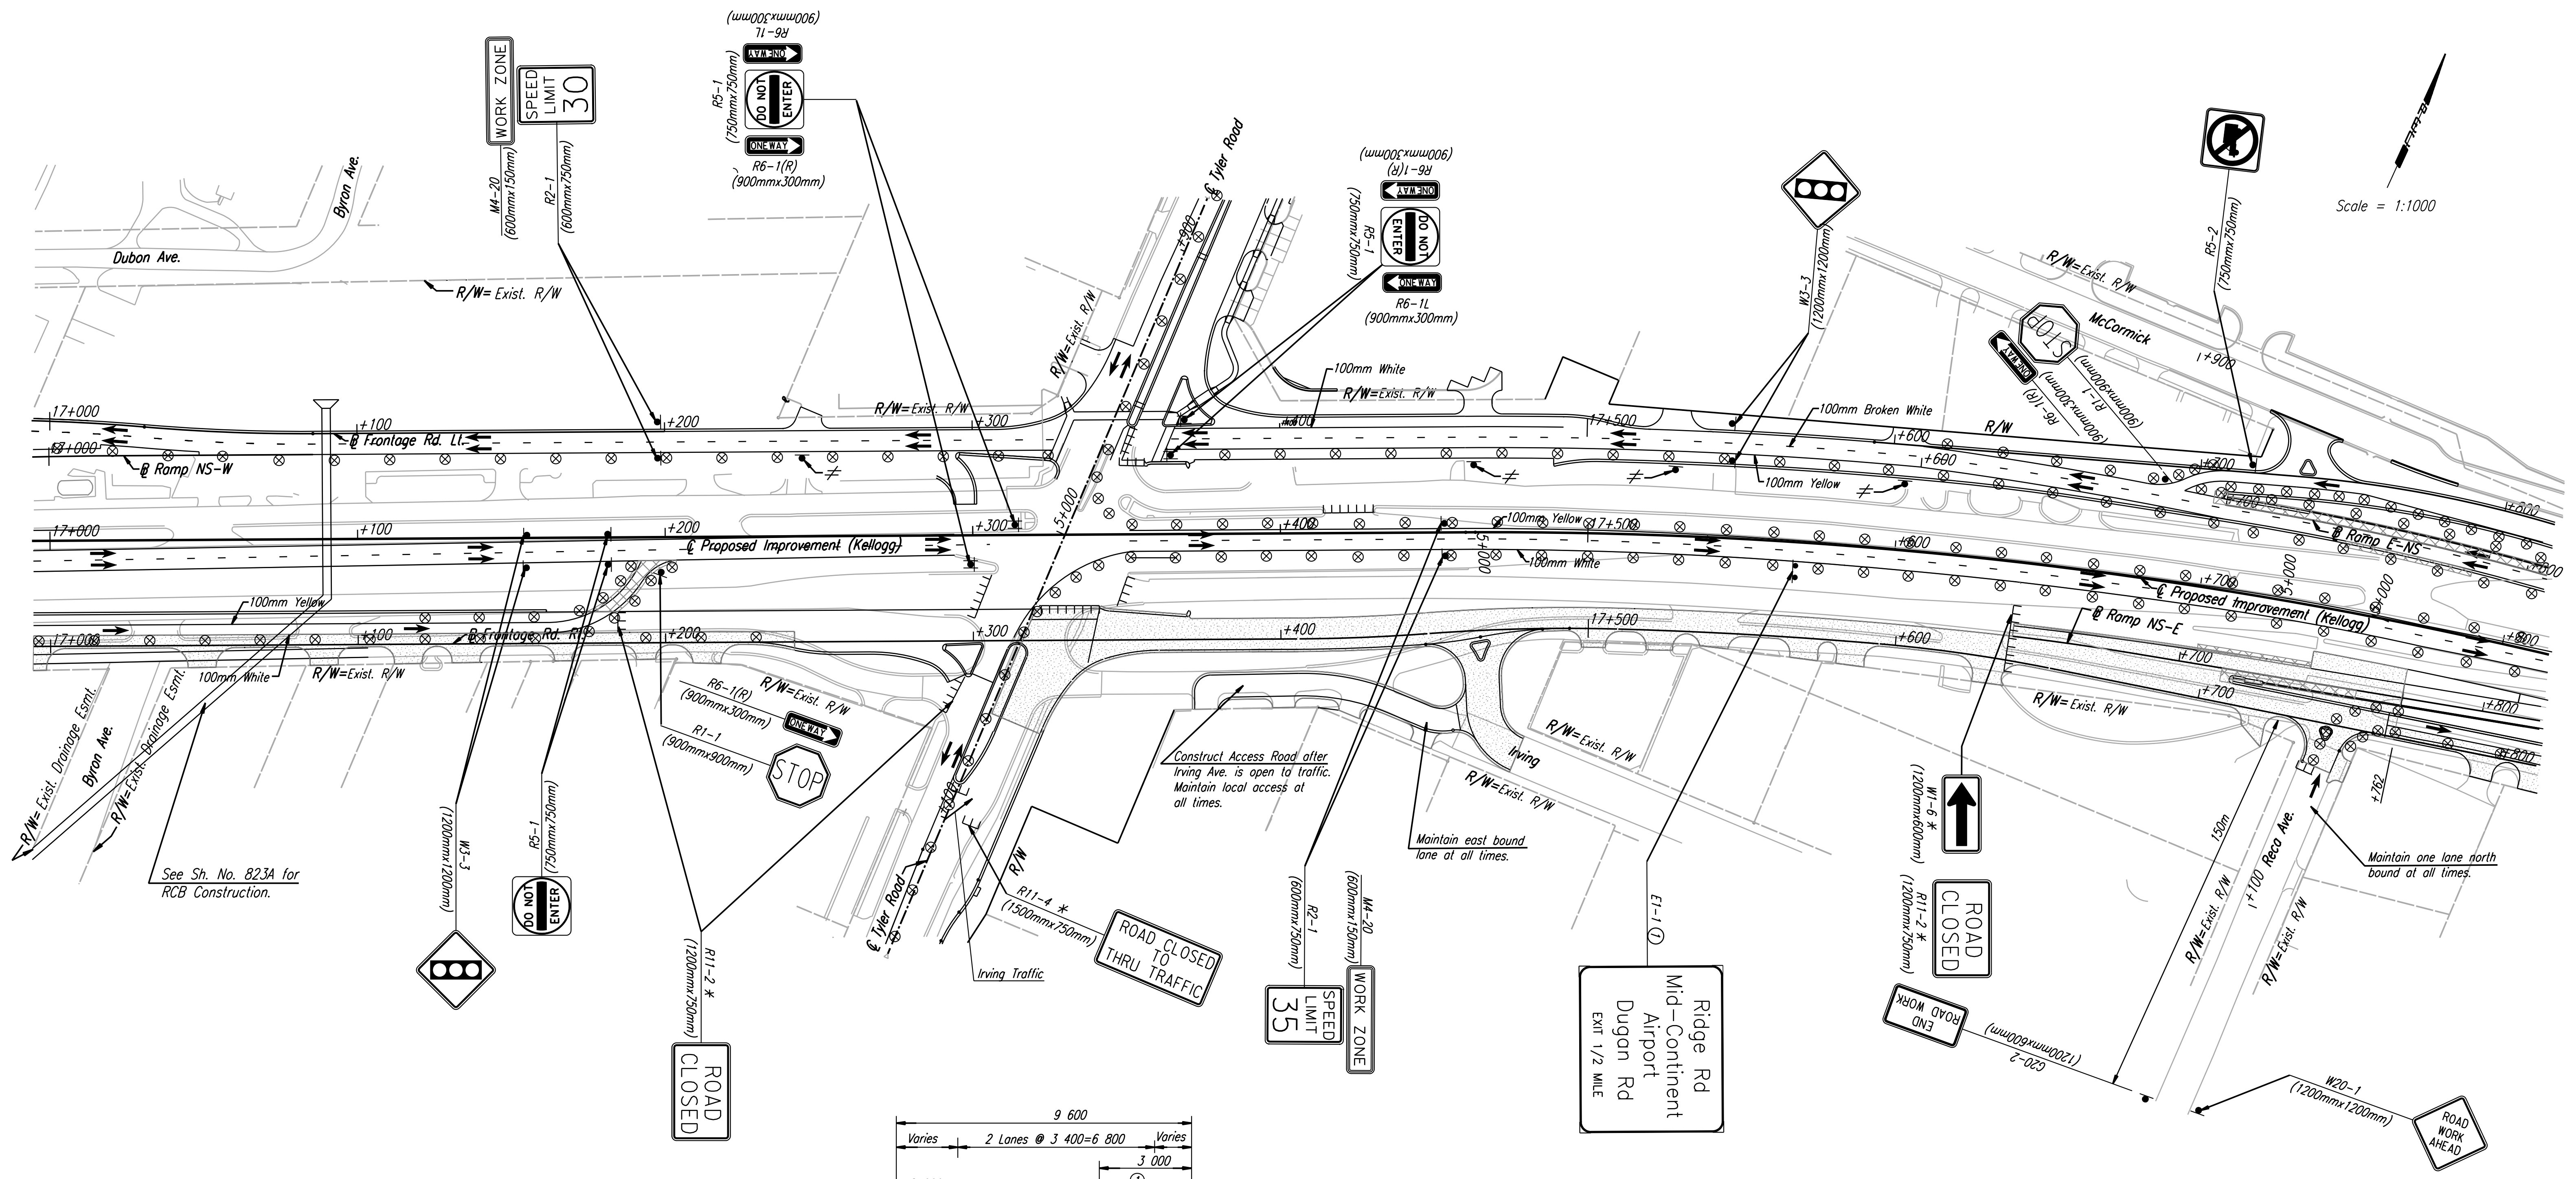

Scale = 1:1000

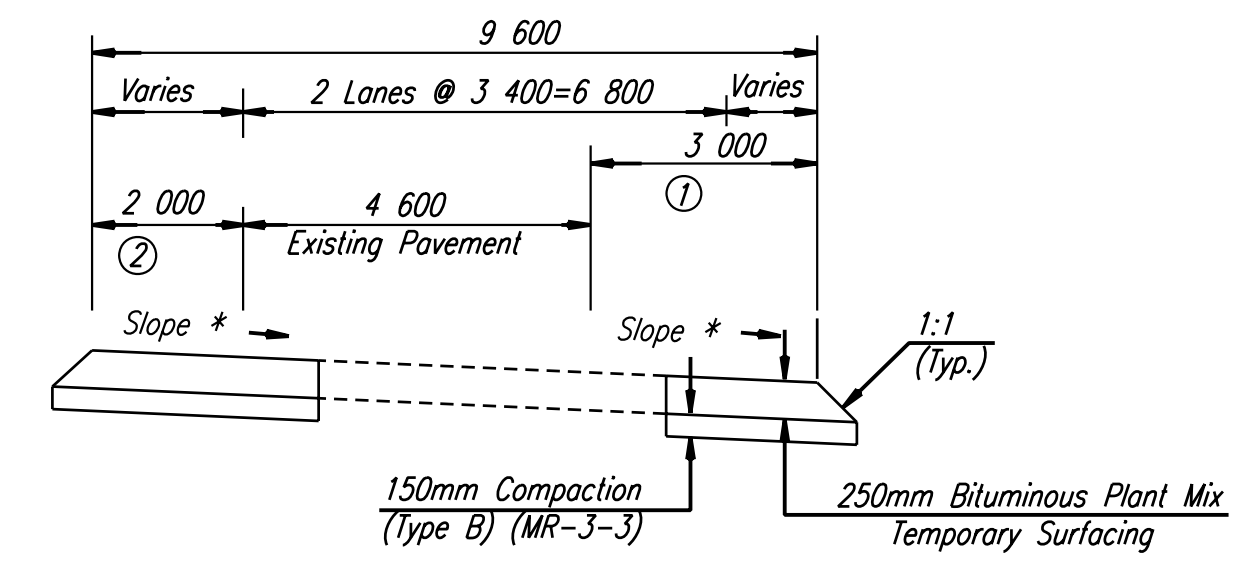

TYPICAL SECTION - TEMP. WIDENING
 ① Tyler Ramp NS-E Sta. 17+714.2 to Sta. 17+758.5
 ② Tyler Ramp NS-E Sta. 17+705.2 to Sta. 17+742.6
 * Match Existing Pavement Slope

① May use existing sign relocated from Sta. 17+460.

DSWR: OPER: JGP Scale: 1:1000
 12/1997/97362/As-Built/dgn/s/Vol 4/Sh 813-TC Stage 2b-pl70.dgn Last Rev: 10-4-07 By: gdr

No.	Revisions	By	Date

CITY OF WICHITA
TRAFFIC CONTROL
STAGE 2B
STA. 17+000 TO STA. 17+800
 SEDGWICK COUNTY

Professional Engineering Consultants, P.A.
 303 S. TOPEKA • WICHITA, KANSAS 67202
 316-262-2691 • FAX 316-262-3003

Designed by	RPG, RWM	Checked by	WDH
Drawn by	JGP	Date	April, 2002
		Job No.	97362