


FHWA REGION NO.	STATE	PROJECT NO.	YEAR	SHEET NO.	TOTAL SHEETS
7	KANSAS	54-87 K-6657-01	2002	814	1122

DATE	
BY	
REFERENCES NOTED	
REFERENCES CHECKED	

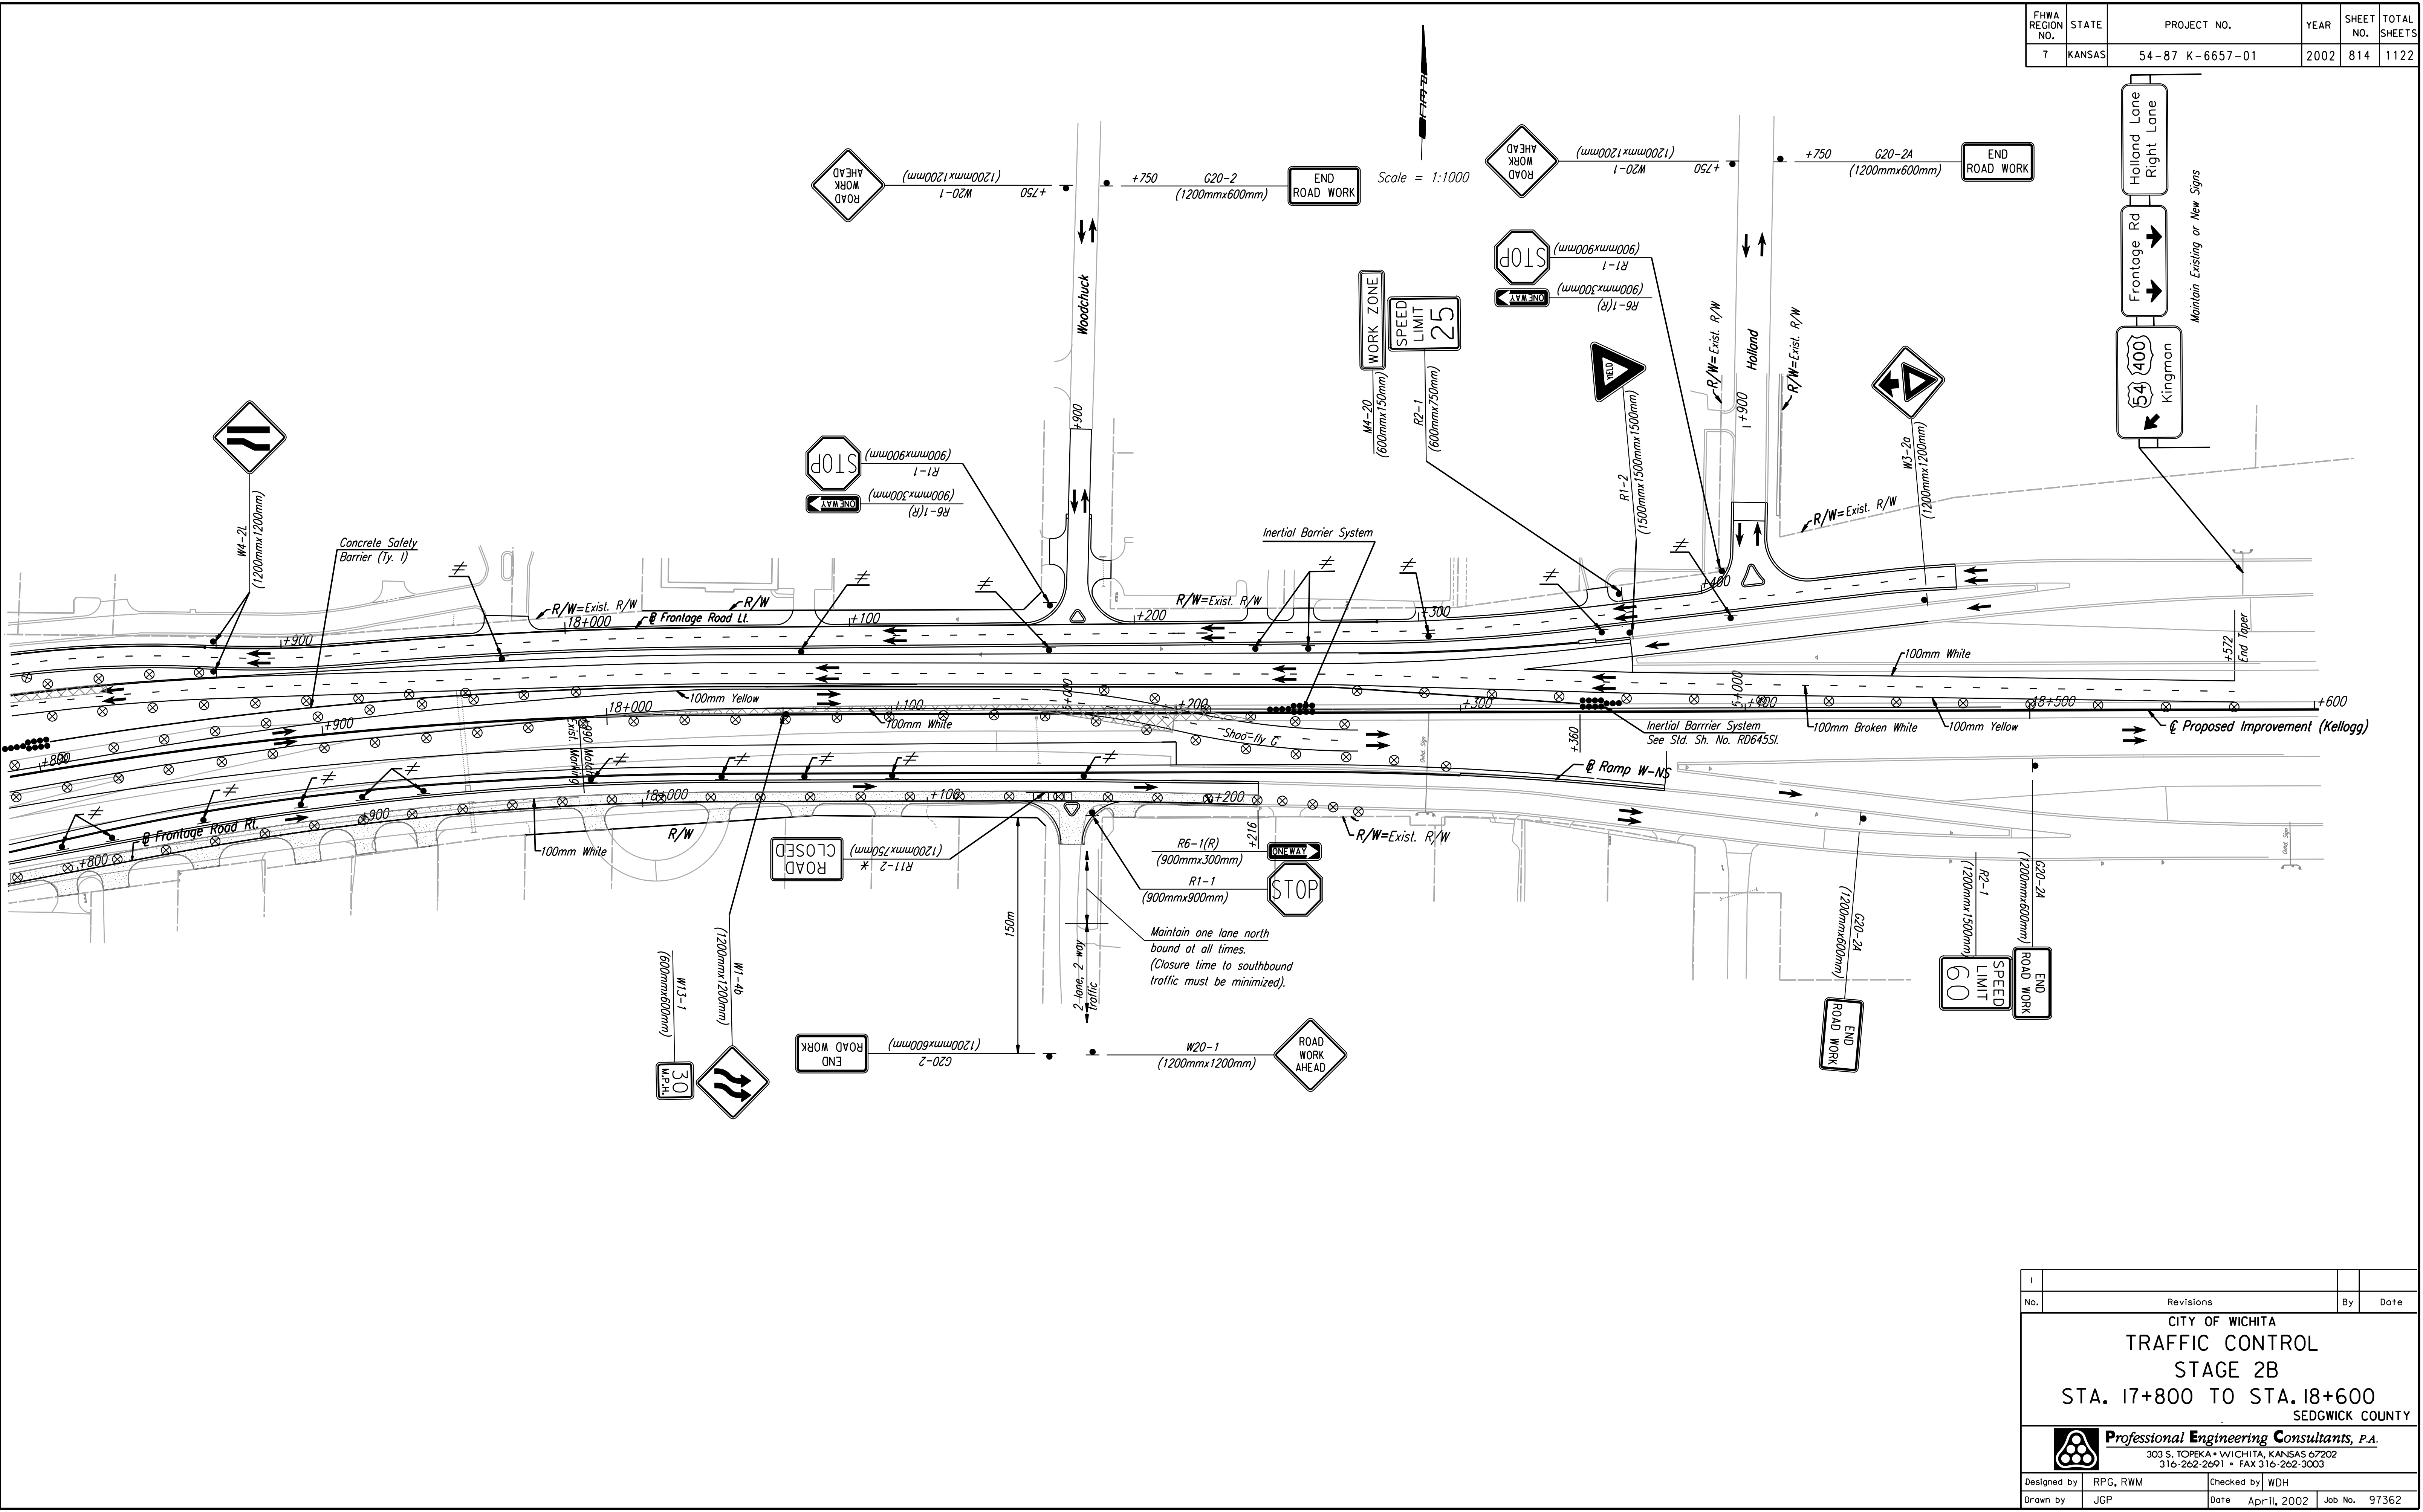

DSMR: OPER: JGP Scale: 1:1000
 i:/1997/97362/As-Builts/dgrs/Vol 4/Sh B14_TC Stage 2b-pl17B.dgn Last Rev: 10-5-07 By: gqr

1			
No.	Revisions	By	Date
CITY OF WICHITA TRAFFIC CONTROL STAGE 2B STA. 17+800 TO STA. 18+600 SEDGWICK COUNTY			
Professional Engineering Consultants, P.A. 303 S. TOPEKA • WICHITA, KANSAS 67202 316-262-2691 • FAX 316-262-3003			
Designed by	RPC, RWM	Checked by	WDH
Drawn by	JGP	Date	April, 2002 Job No. 97362