


FHWA REGION NO.	STATE	PROJECT NO.	YEAR	SHEET NO.	TOTAL SHEETS
7	KANSAS	54-87 K-6657-01	2002	814A	1122

Scale = 1:1000

DATE	
BY	
REFERENCES NOTED	
REFERENCES CHECKED	

DSMR: OPER: JGP Scale: 1:1000  
 I:/1997/97362/As-Builts/dgn's/Vol 4/Sh 814a\_TC Stage 3-pl/38.dgn Last Rev: 10-5-07 By: gdr

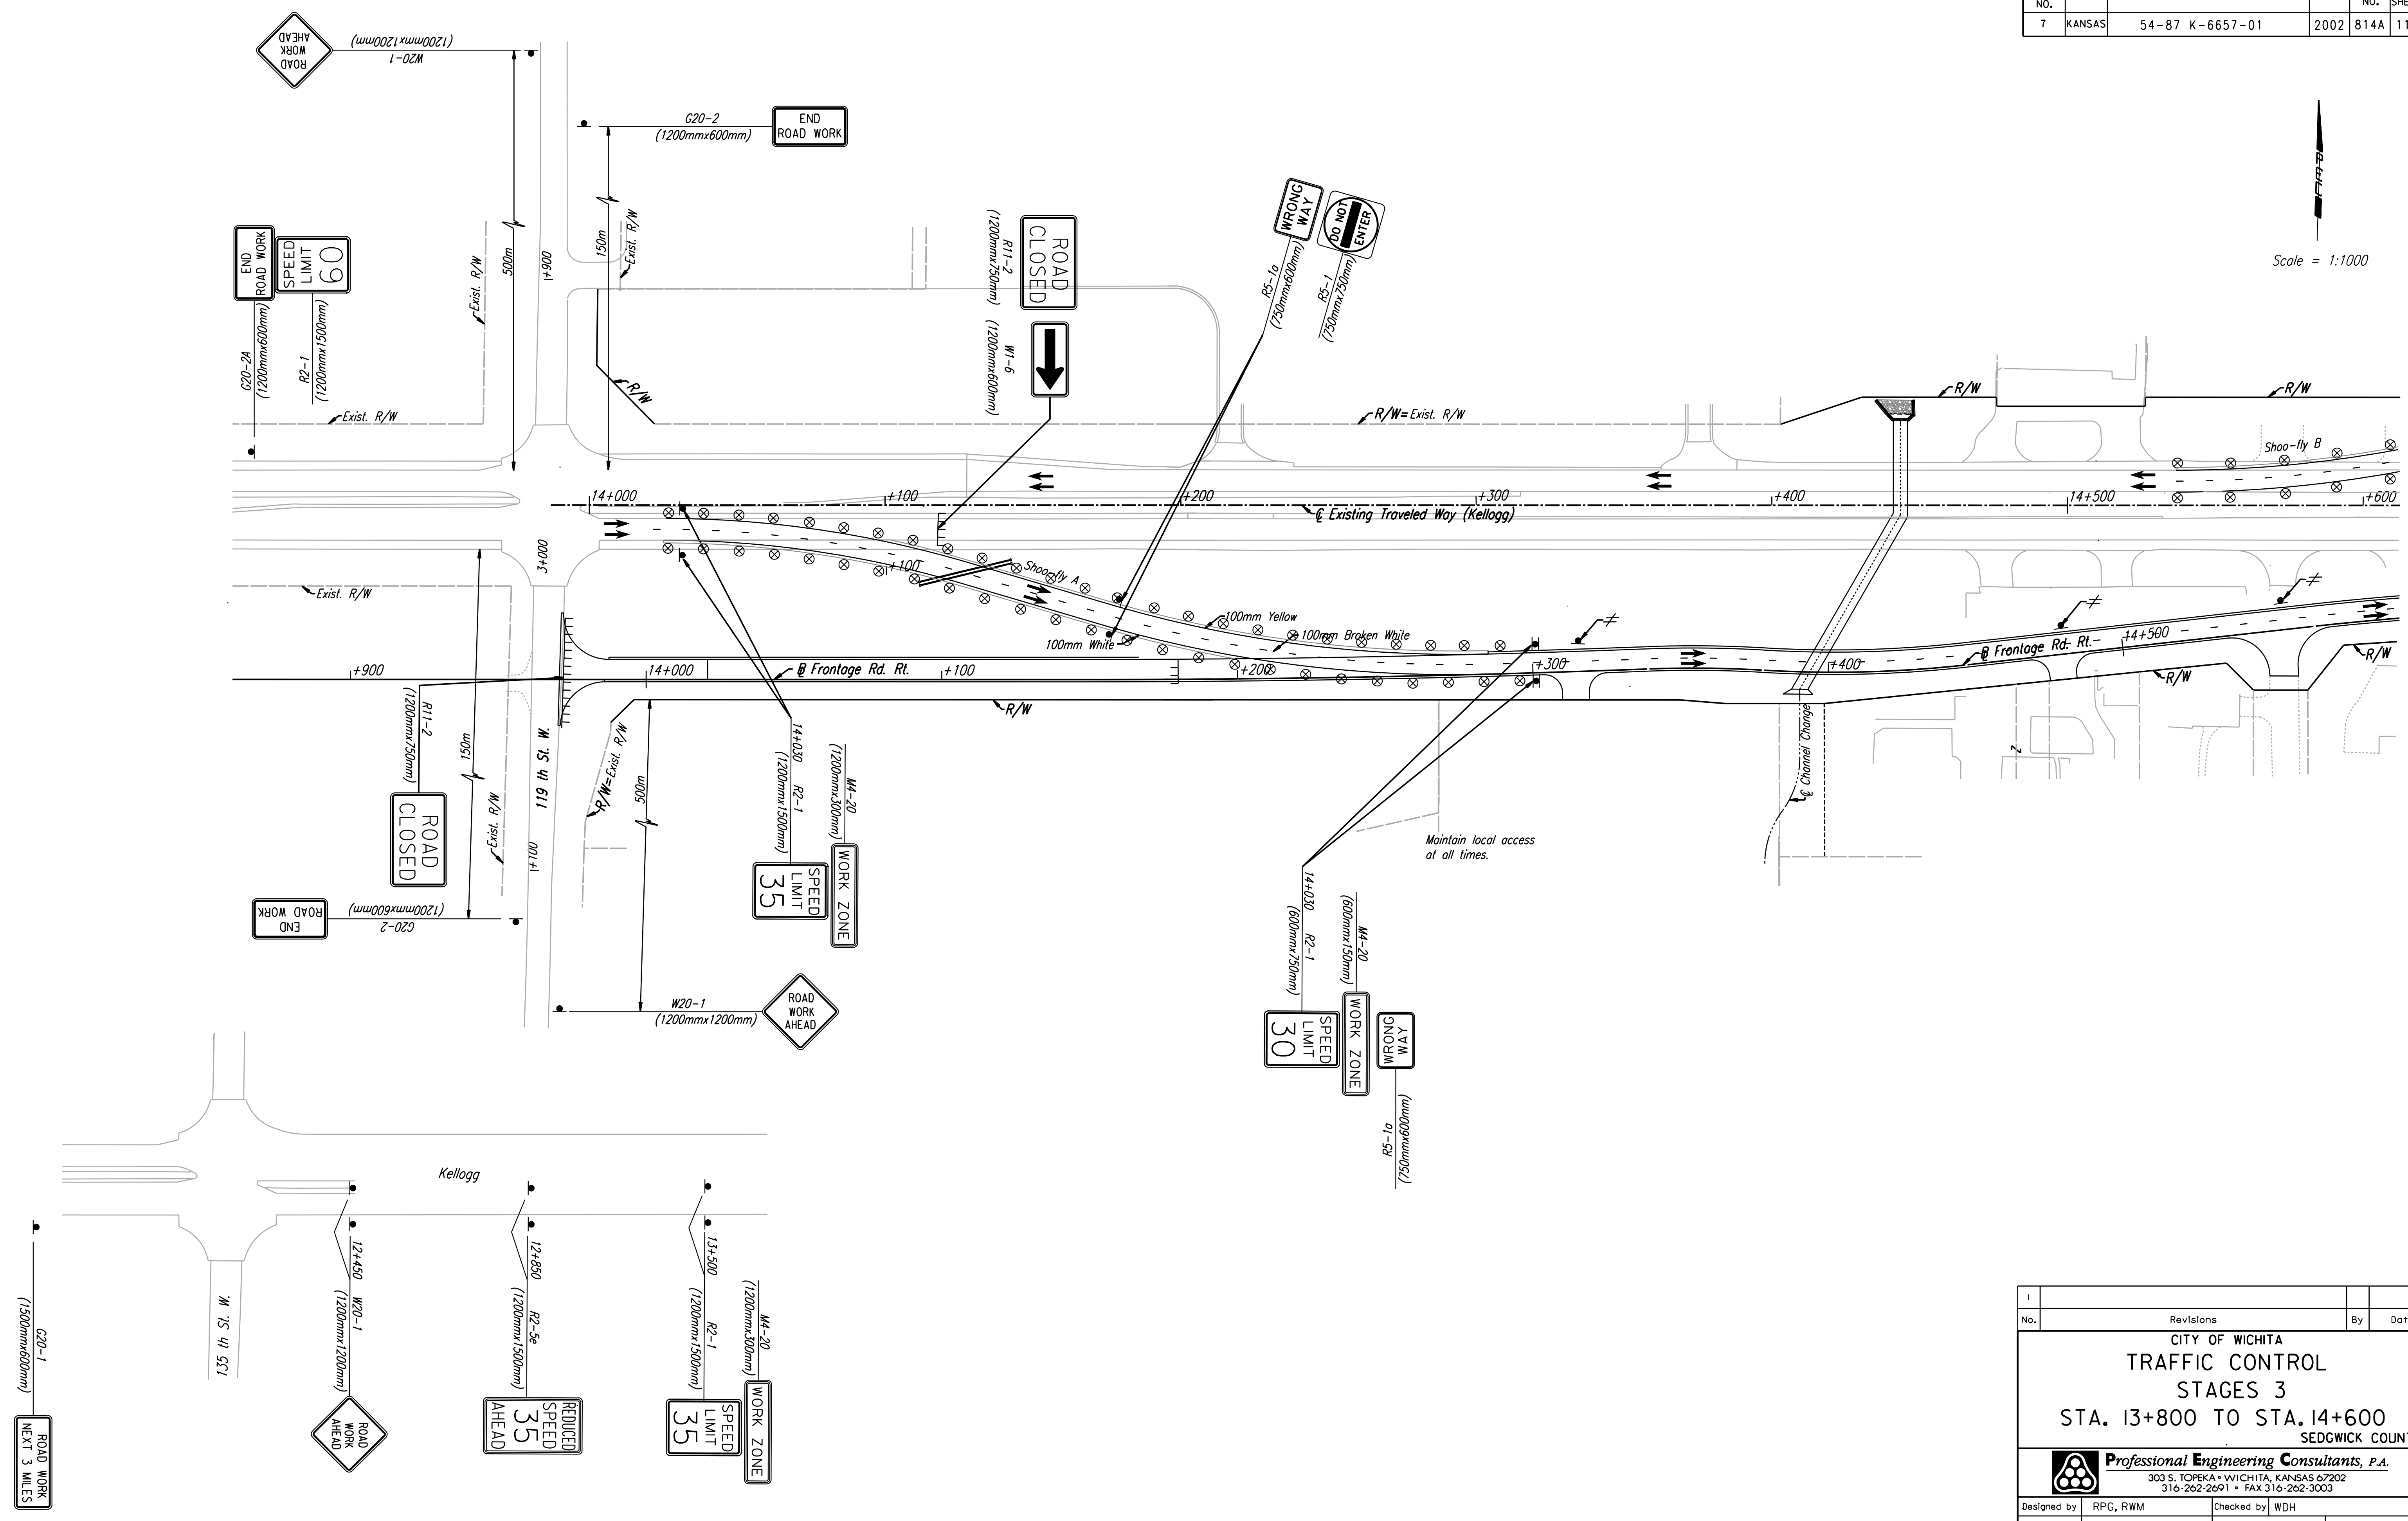

No.	Revisions	By	Date

CITY OF WICHITA  
 TRAFFIC CONTROL  
 STAGES 3  
 STA. 13+800 TO STA. 14+600  
 SEDGWICK COUNTY

**Professional Engineering Consultants, P.A.**  
 303 S. TOPEKA • WICHITA, KANSAS 67202  
 316-262-2691 • FAX 316-262-3003

Designed by	RPC, RWM	Checked by	WDH
Drawn by	JGP	Date	April, 2002
		Job No.	97362