



FHWA REGION NO.	STATE	PROJECT NO.	YEAR	SHEET NO.	TOTAL SHEETS
7	KANSAS	54-87 K-6657-01	2002	814C	1122

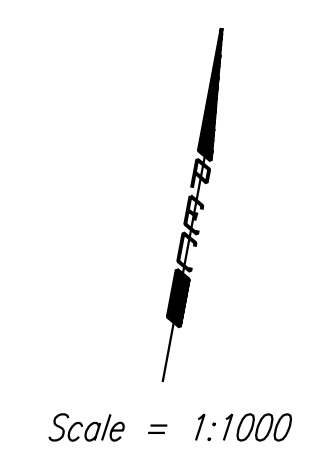

BY	DATE
REFERENCES NOTED	REFERENCES CHECKED

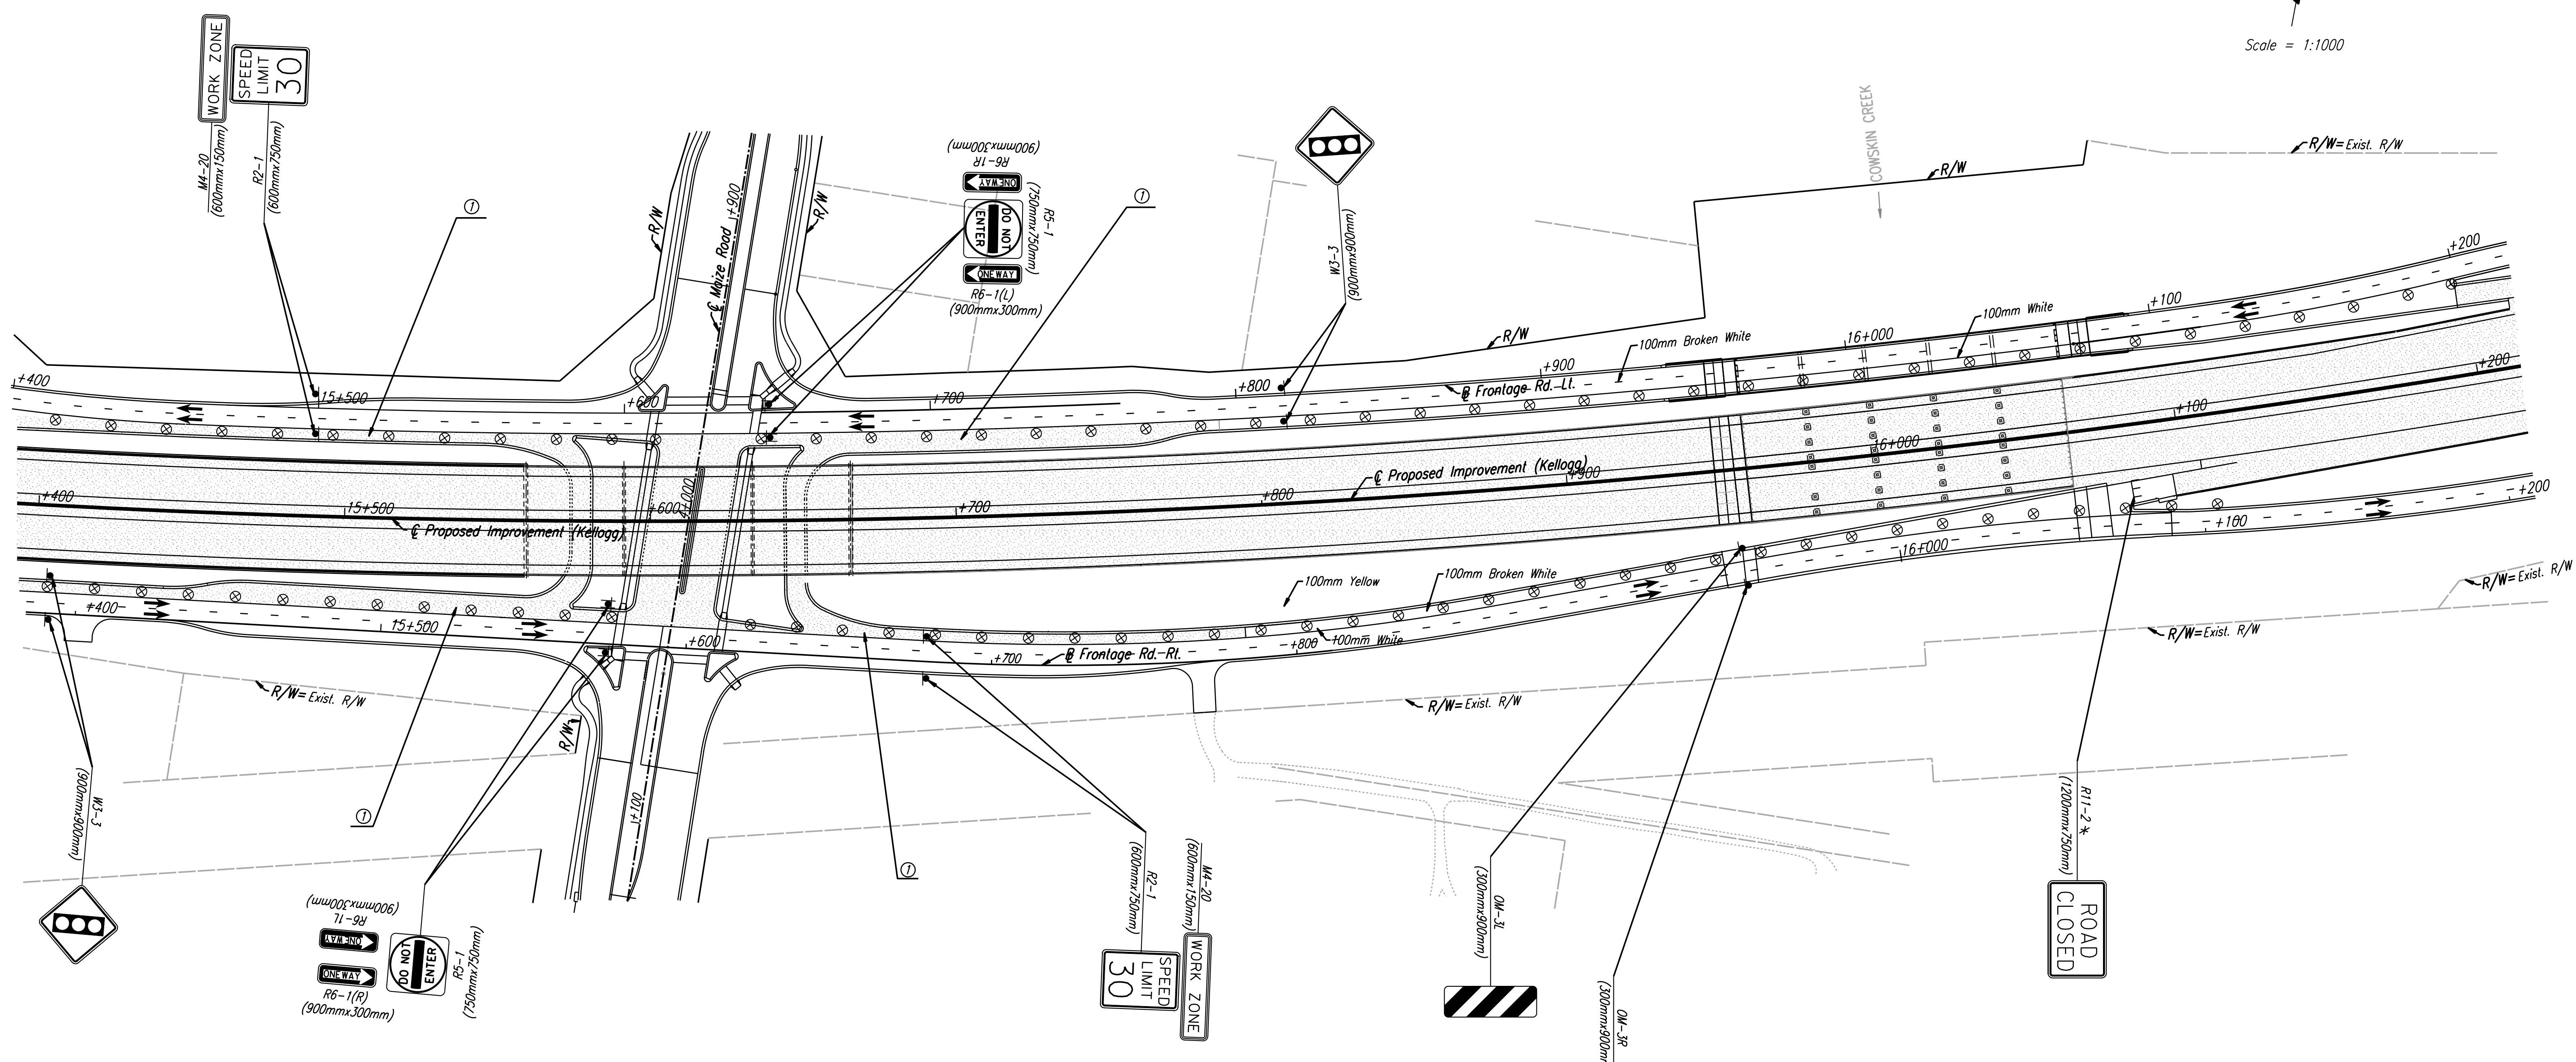

See Sh. Nos. 837 & 839  
for Temporary Traffic Signal.

See Sh. Nos. 815-818  
for Traffic Control on Maize Rd.

① Complete Frontage Road Construction during Stage 4  
as required to clear retaining wall construction.

DSNR: OPER: JGP Scale: 1:1000  
 12/1997/197-362/As-Built/dgn/s/Vol 4/Sh 814c.TC Stage 3-pl154.dgn Last Rev: 10-5-07 By: gdr

No.	Revisions	By	Date

CITY OF WICHITA  
 TRAFFIC CONTROL  
 STAGE 3  
 STA. 15+400 TO STA. 16+200  
 SEDGWICK COUNTY

**Professional Engineering Consultants, P.A.**  
 303 S. TOPEKA • WICHITA, KANSAS 67202  
 316-262-2691 • FAX 316-262-3003

Designed by	RPG, RWM	Checked by	WDH
Drawn by	JGP	Date	April, 2002
		Job No.	97362