


FHWA REGION NO.	STATE	PROJECT NO.	YEAR	SHEET NO.	TOTAL SHEETS
7	KANSAS	54-87 K-6657-01	2002	8140	1122

DATE	
BY	
REFERENCES NOTED	
REFERENCES CHECKED	

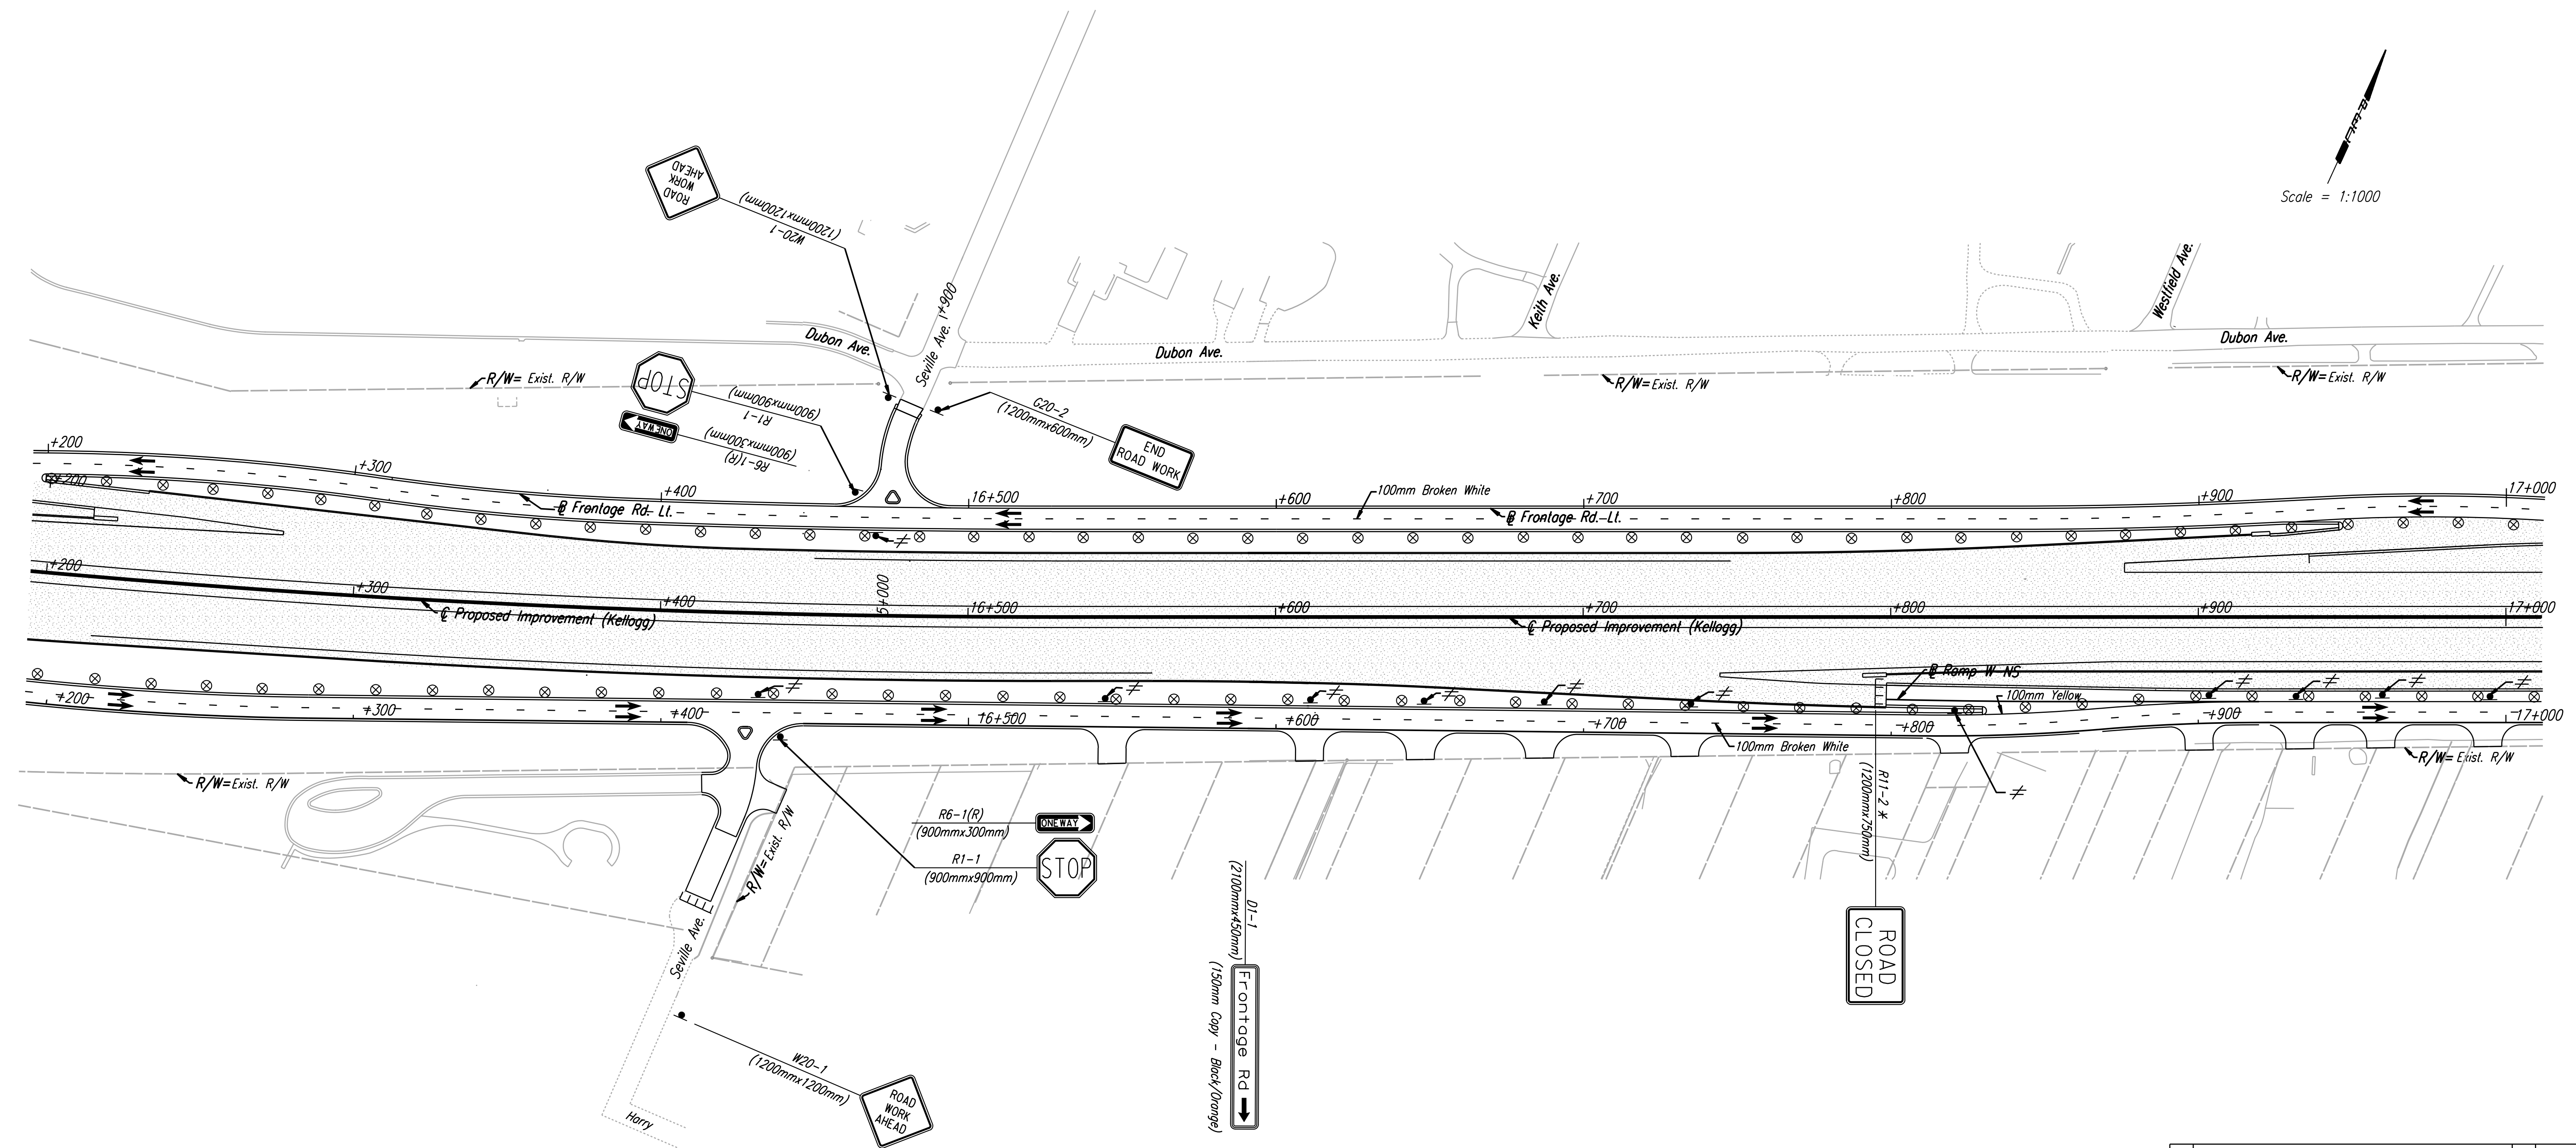

DSNR: OPER: JGP Scale: 1:1000  
 I:/1997/97362/As-Builts/dgn/4/SH 814d\_TC Stage 3-pl162.dgn Last Rev: 10-5-07 By: gdr

No.	Revisions	By	Date
CITY OF WICHITA TRAFFIC CONTROL STAGE 3 STA. 16+200 TO STA. 17+000 SEDGWICK COUNTY			
<b>Professional Engineering Consultants, P.A.</b> 303 S. TOPEKA • WICHITA, KANSAS 67202 316-262-2691 • FAX 316-262-3003			
Designed by	RPC, RWM	Checked by	WDH
Drawn by	JGP	Date	April, 2002 Job No. 97362