


FHWA REGION NO.	STATE	PROJECT NO.	YEAR	SHEET NO.	TOTAL SHEETS
7	KANSAS	54-87 K-6657-01	2002	814E	1122

See Sh. Nos. 837 & 842 for Temporary Traffic Signal.
See Sh. Nos. 815-818 for Traffic Control on Tyler Rd.

DATE	
BY	
REFERENCES NOTED	
REFERENCES CHECKED	

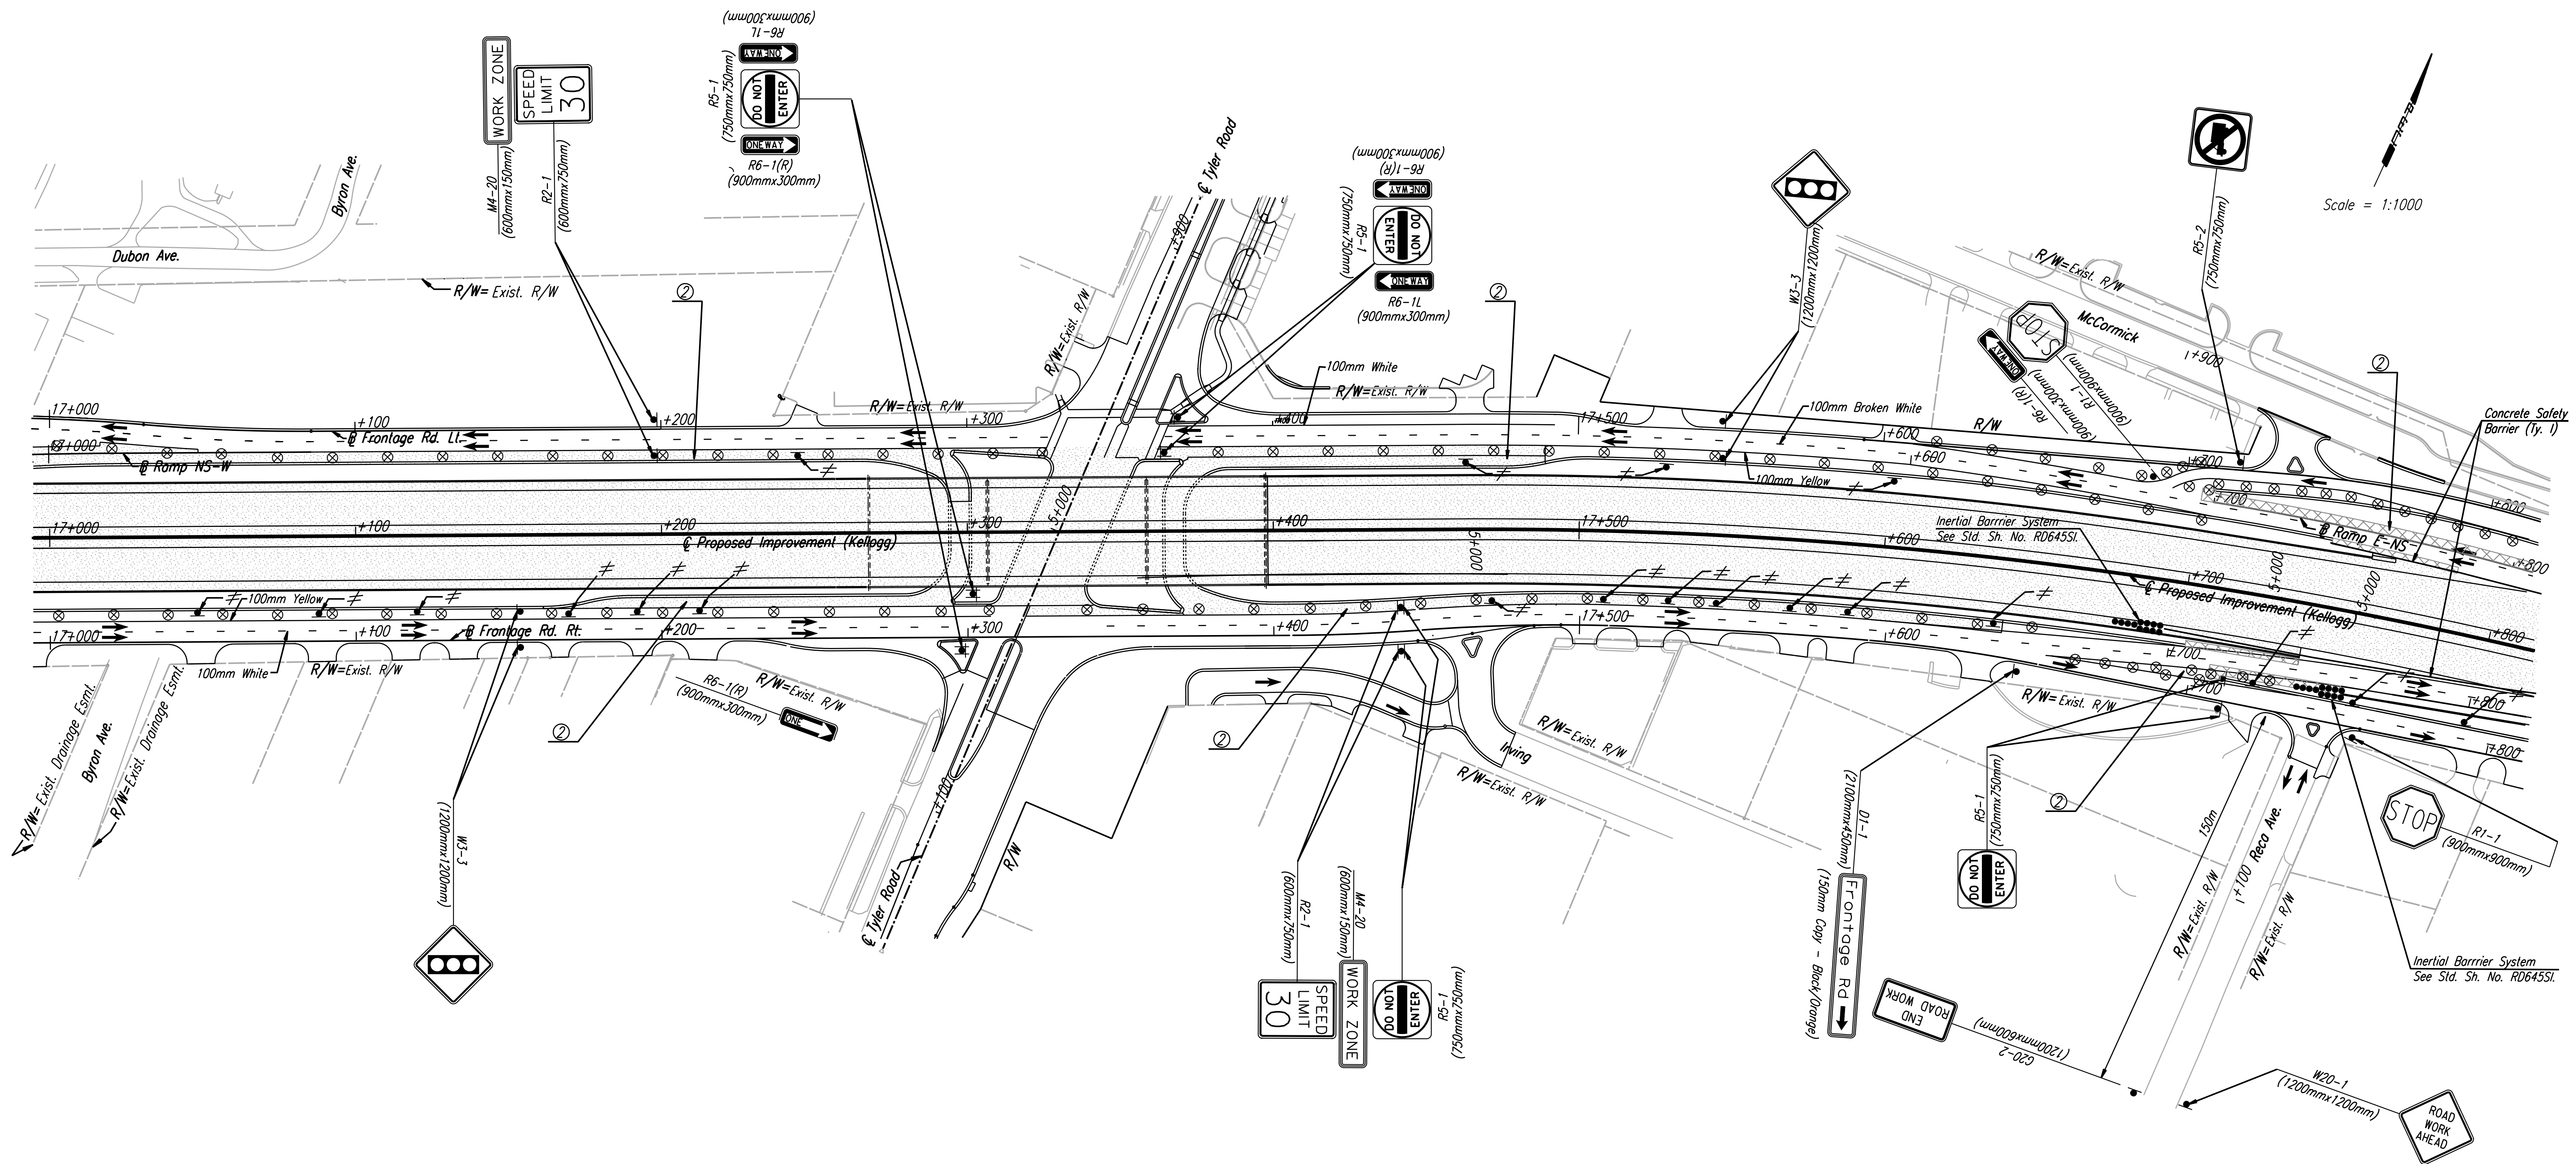

Scale = 1:1000

DSMR: OPER: JGP Scale: 1:1000
12/1997/97362/As-Built/dgn/s/Vol 4/Sh 814e_TC Stage 3-pl/70.dgn Last Rev: 10-5-07 By: gdr

- ① May use existing sign relocated from Sta. 17+460.
- ② Complete Frontage Road & Ramp Construction During Stage 4 as Required to Clear Retaining Wall Construction.

No.	Revisions	By	Date

CITY OF WICHITA
TRAFFIC CONTROL
STAGE 3
STA. 17+000 TO STA. 17+800
SEDGWICK COUNTY

Professional Engineering Consultants, P.A.
303 S. TOPEKA • WICHITA, KANSAS 67202
316-262-2691 • FAX 316-262-3003

Designed by	RPG, RWM	Checked by	WDH
Drawn by	JGP	Date	April, 2002
		Job No.	97362