
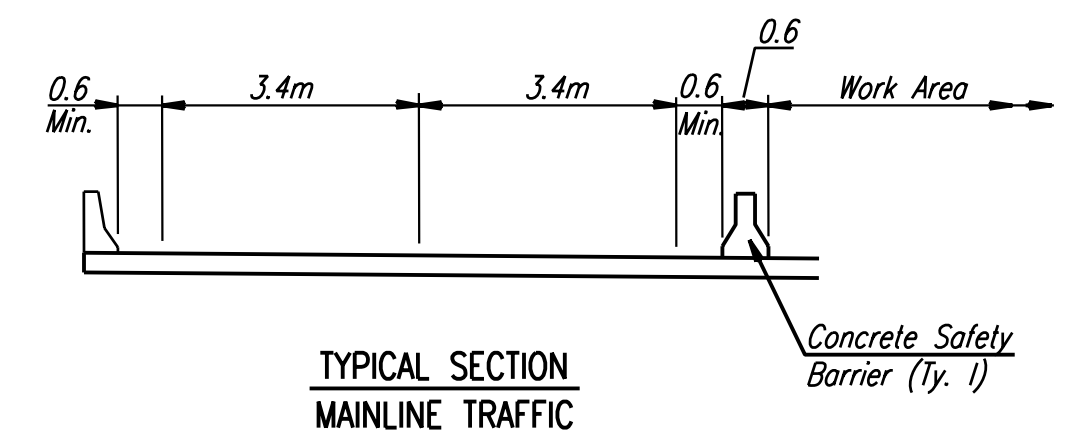


FHWA REGION NO.	STATE	PROJECT NO.	YEAR	SHEET NO.	TOTAL SHEETS
7	KANSAS	54-87 K-6657-01	2002	814F	1122

DATE	
BY	
REFERENCES NOTED	
REFERENCES CHECKED	

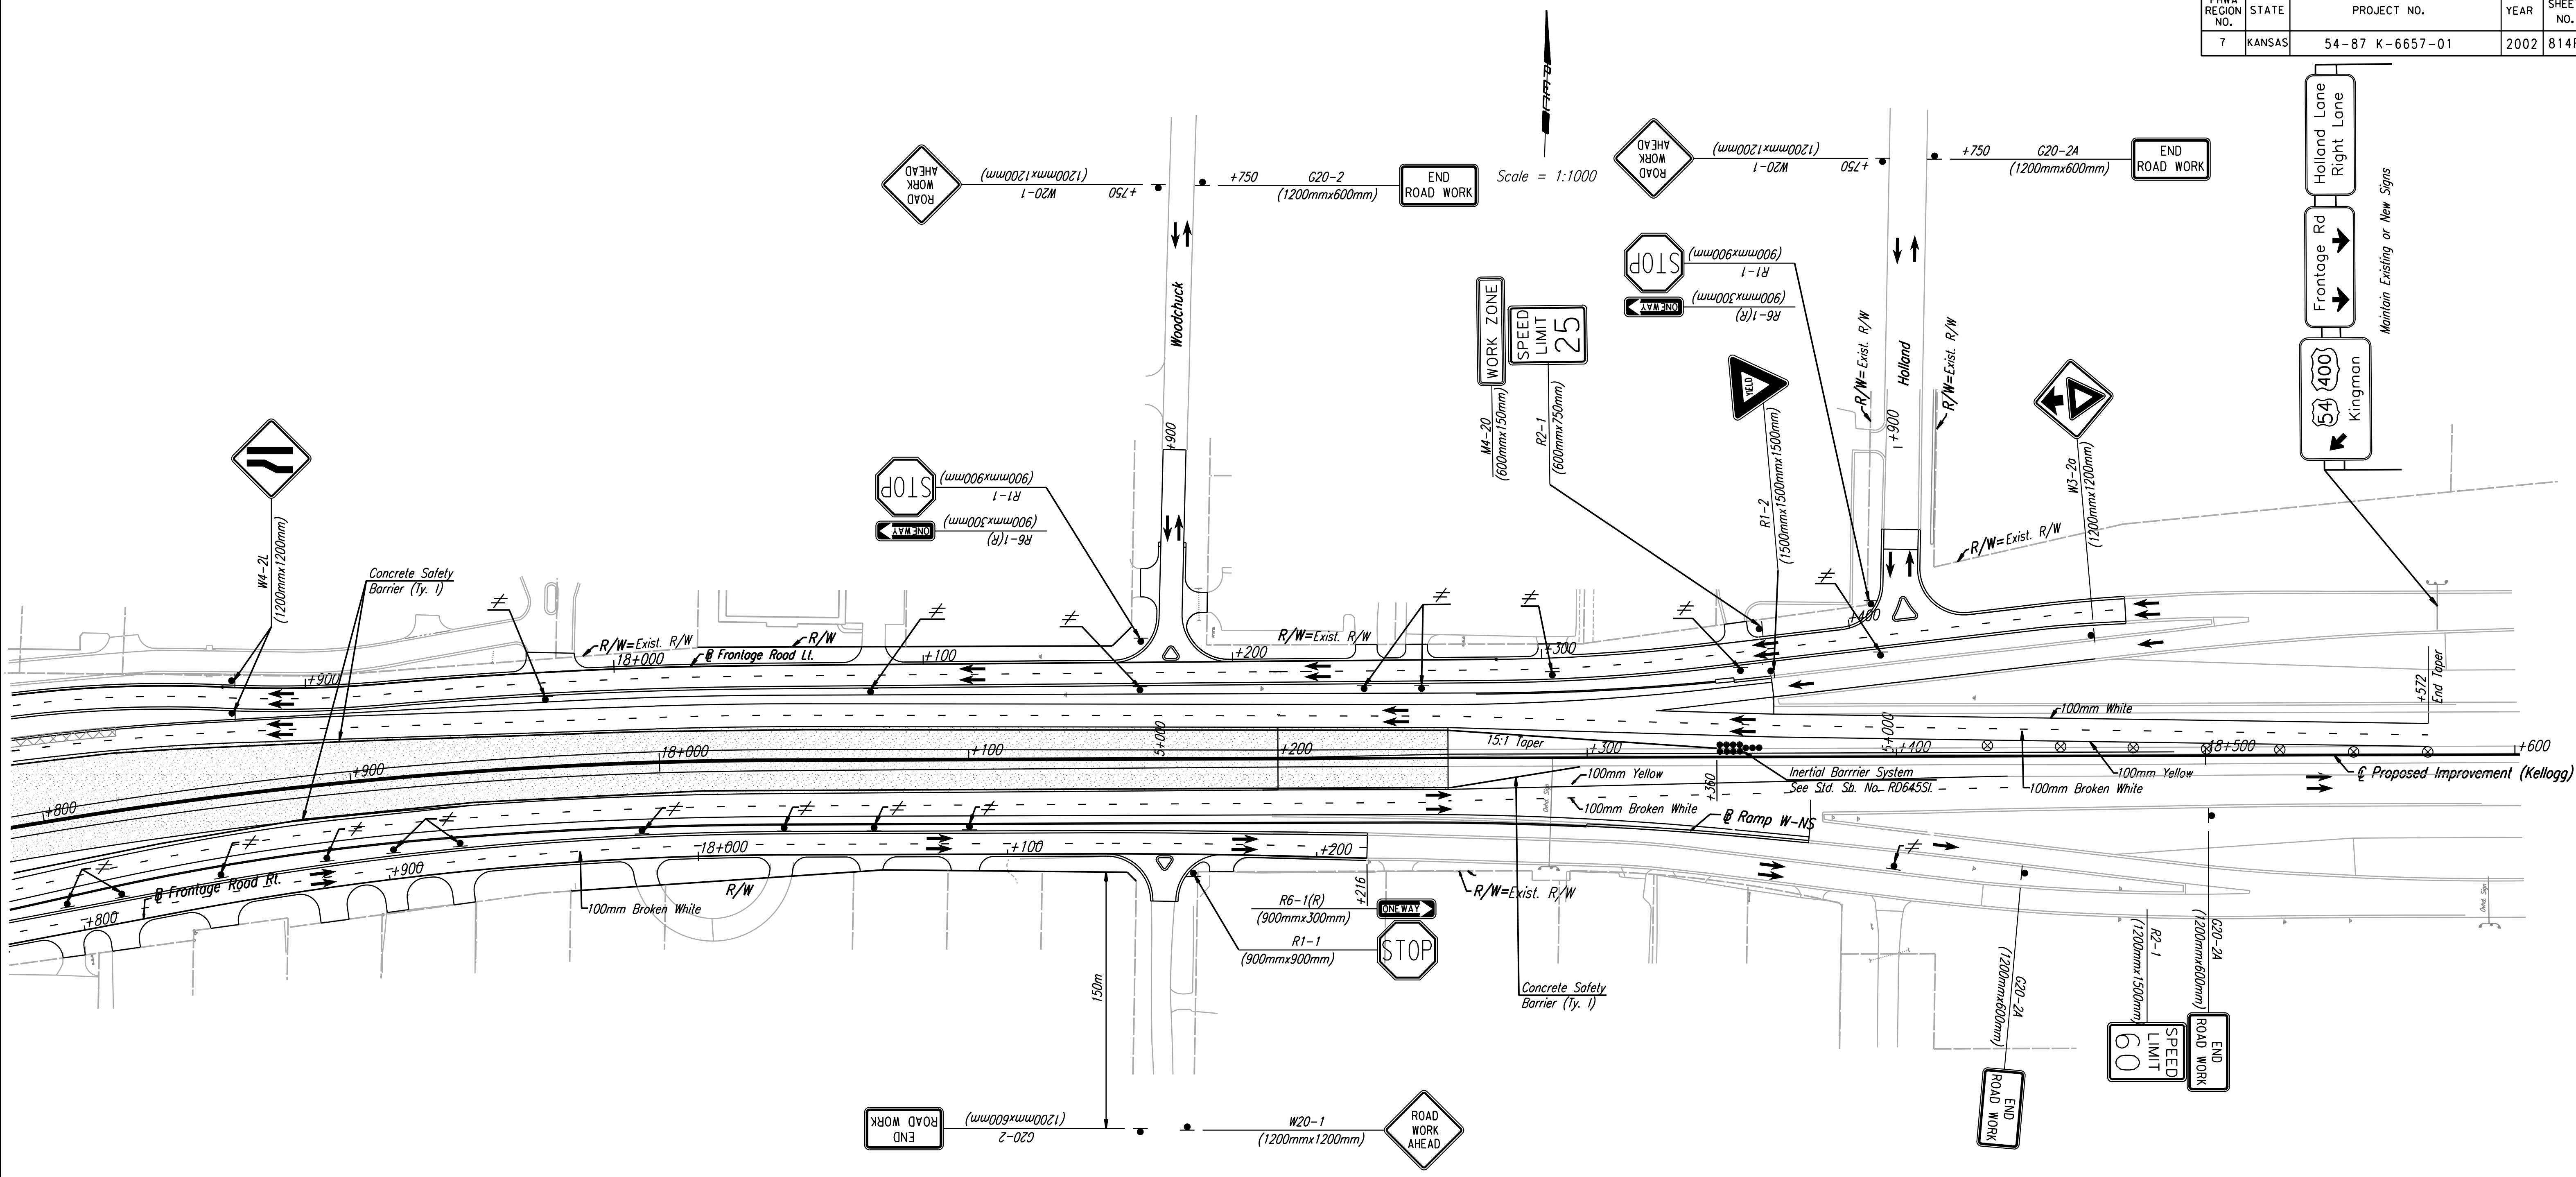

DSWR: OPER: JGP Scale: 1:1000
 1:/1997/97362/As-Builts/dgrs/014/Sh 814F_TC Stage 3-pl17B.dgn Last Rev: 10-5-07 By: gdr

No.	Revisions	By	Date

CITY OF WICHITA
 TRAFFIC CONTROL
 STAGE 3
 STA. 17+800 TO STA. 18+600
 SEDGWICK COUNTY

Professional Engineering Consultants, P.A.
 303 S. TOPEKA • WICHITA, KANSAS 67202
 316-262-2691 • FAX 316-262-3003

Designed by	RPC, RWM	Checked by	WDH
Drawn by	JGP	Date	April, 2002
		Job No.	97362