


FHWA REGION NO.	STATE	PROJECT NO.	YEAR	SHEET NO.	TOTAL SHEETS
7	KANSAS	54-87 K-6657-01	2002	815	1122



DATE	
BY	
REFERENCES NOTED	
REFERENCES CHECKED	

DSNR: OPER: JGP Scale: 1:1000  
 1/1997/97-362/As-Builts/dgn/s/Vol 4/SH 815-TC Stage 1a-mzpl3670.dgn Last Rev: 10-5-07 By: gdr

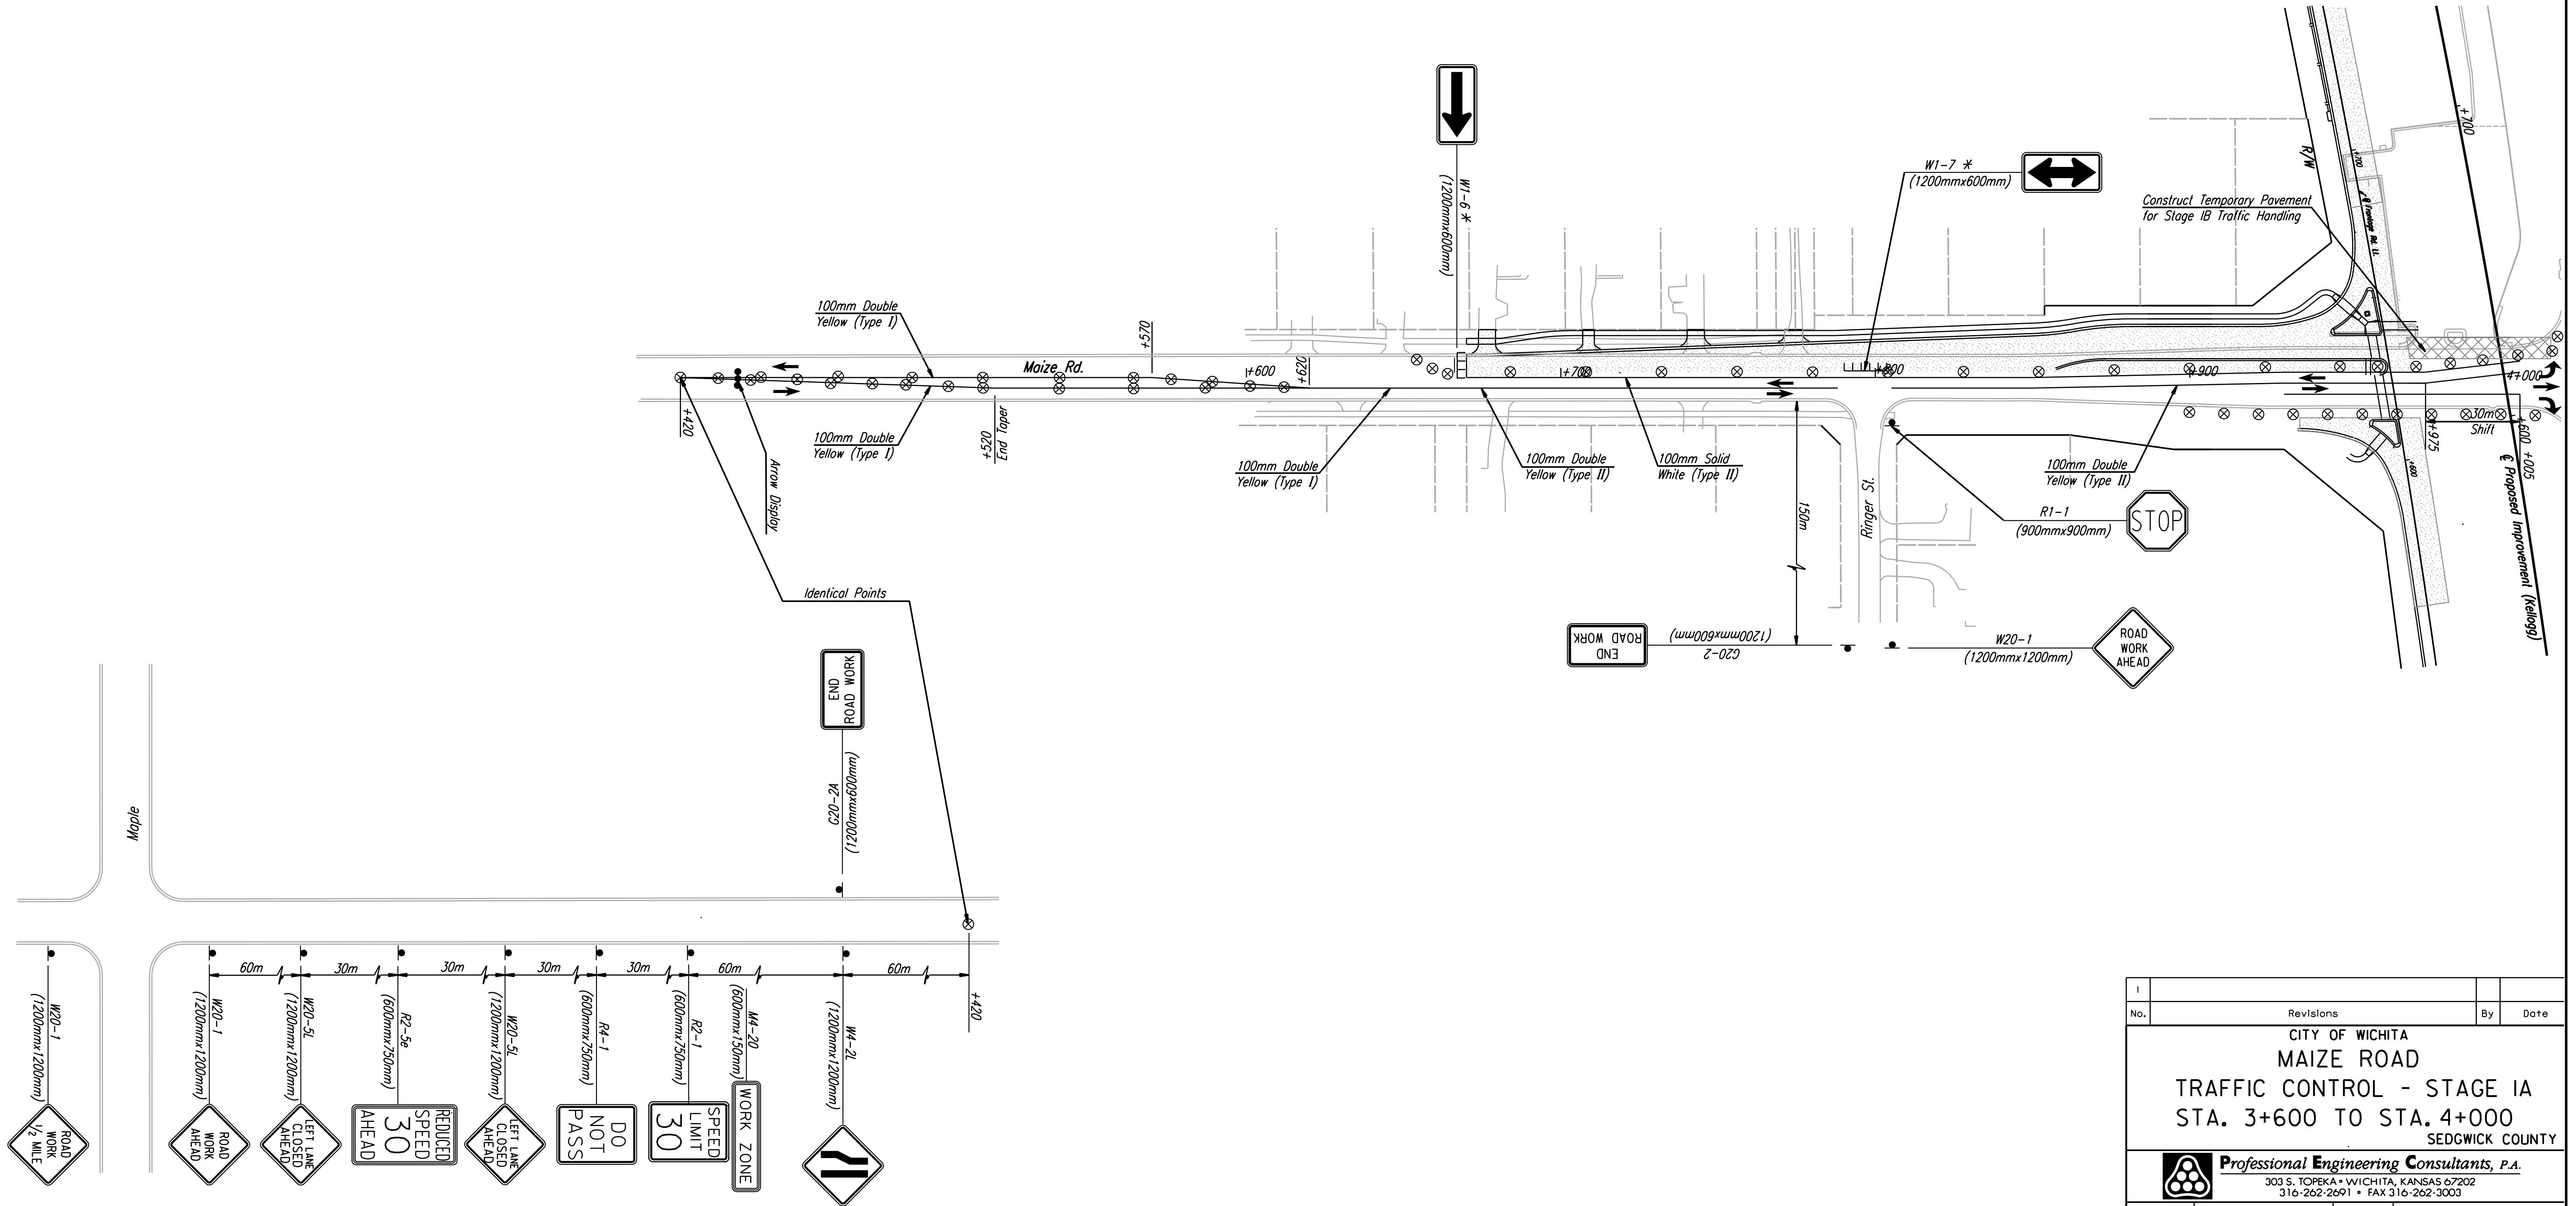

No.	Revisions	By	Date

CITY OF WICHITA  
**MAIZE ROAD**  
**TRAFFIC CONTROL - STAGE IA**  
**STA. 3+600 TO STA. 4+000**  
 SEDGWICK COUNTY

**Professional Engineering Consultants, P.A.**  
 303 S. TOPEKA • WICHITA, KANSAS 67202  
 316-262-2691 • FAX 316-262-3003

Designed by	RPC, RWM	Checked by	WDH
Drawn by	JGP	Date	April, 2002
		Job No.	97362