
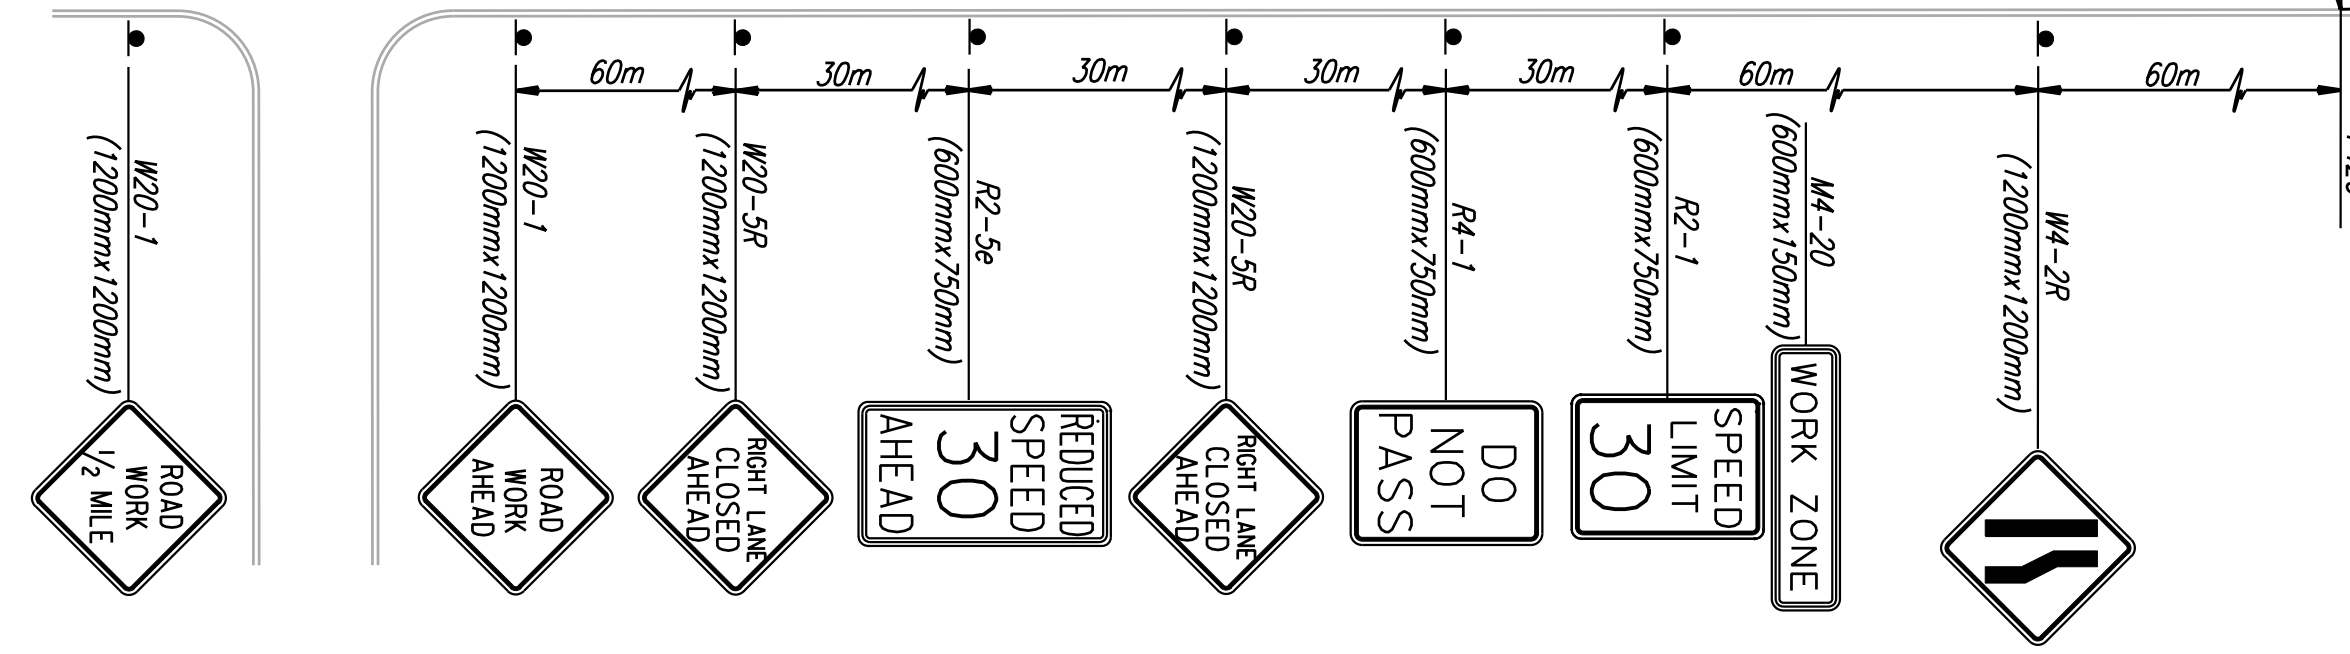


FHWA REGION NO.	STATE	PROJECT NO.	YEAR	SHEET NO.	TOTAL SHEETS
7	KANSAS	54-87 K-6657-01	2002	817	1122

DATE	
BY	
REFERENCES NOTED	
REFERENCES CHECKED	

DSMR: OPER: JGP Scale: 1:1000
 1:1997/97.362/As-Builts/dgn's/Vol 4/Sh 817-TC Stage 1b-mzpl3670.dgn Last Rev: 10-5-07 By: gdr

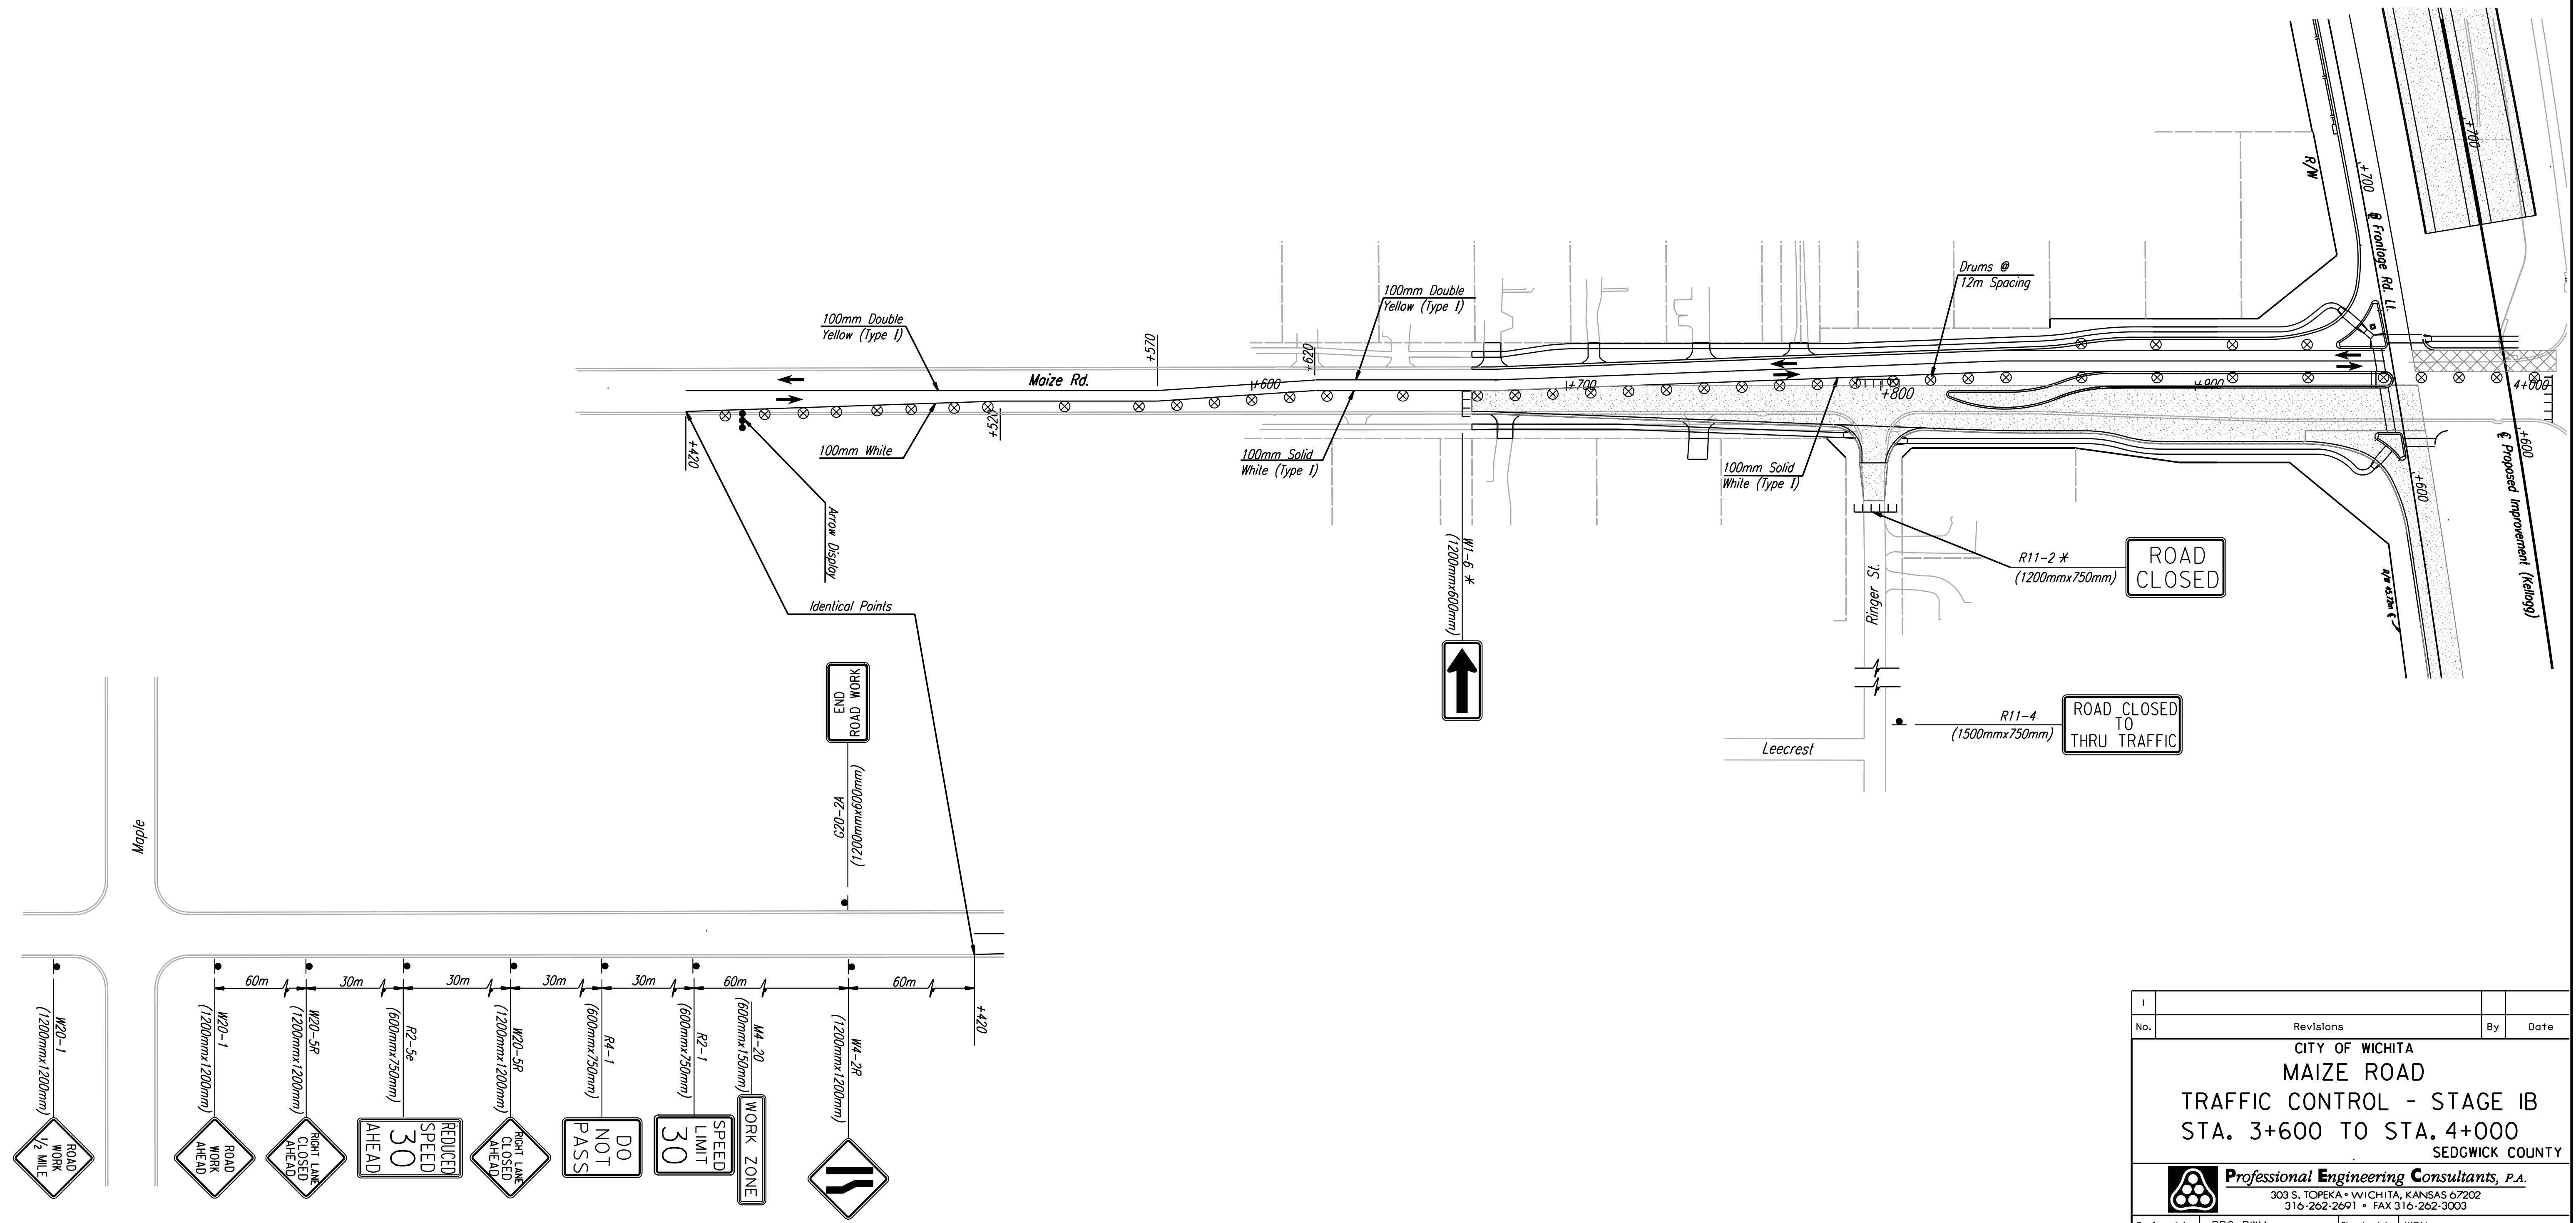

1			
No.	Revisions	By	Date
CITY OF WICHITA MAIZE ROAD TRAFFIC CONTROL - STAGE 1B STA. 3+600 TO STA. 4+000 SEDGWICK COUNTY			
Professional Engineering Consultants, P.A. <small>303 S. TOPEKA • WICHITA, KANSAS 67202 316-262-2691 • FAX 316-262-3003</small>			
Designed by	RPC, RWM	Checked by	WDH
Drawn by	JGP	Date	April, 2002 Job No. 97362