


FHWA REGION NO.	STATE	PROJECT NO.	YEAR	SHEET NO.	TOTAL SHEETS
7	KANSAS	54-87 K-6657-01	2002	822	1122

BY	DATE
REFERENCES NOTED	
REFERENCES CHECKED	

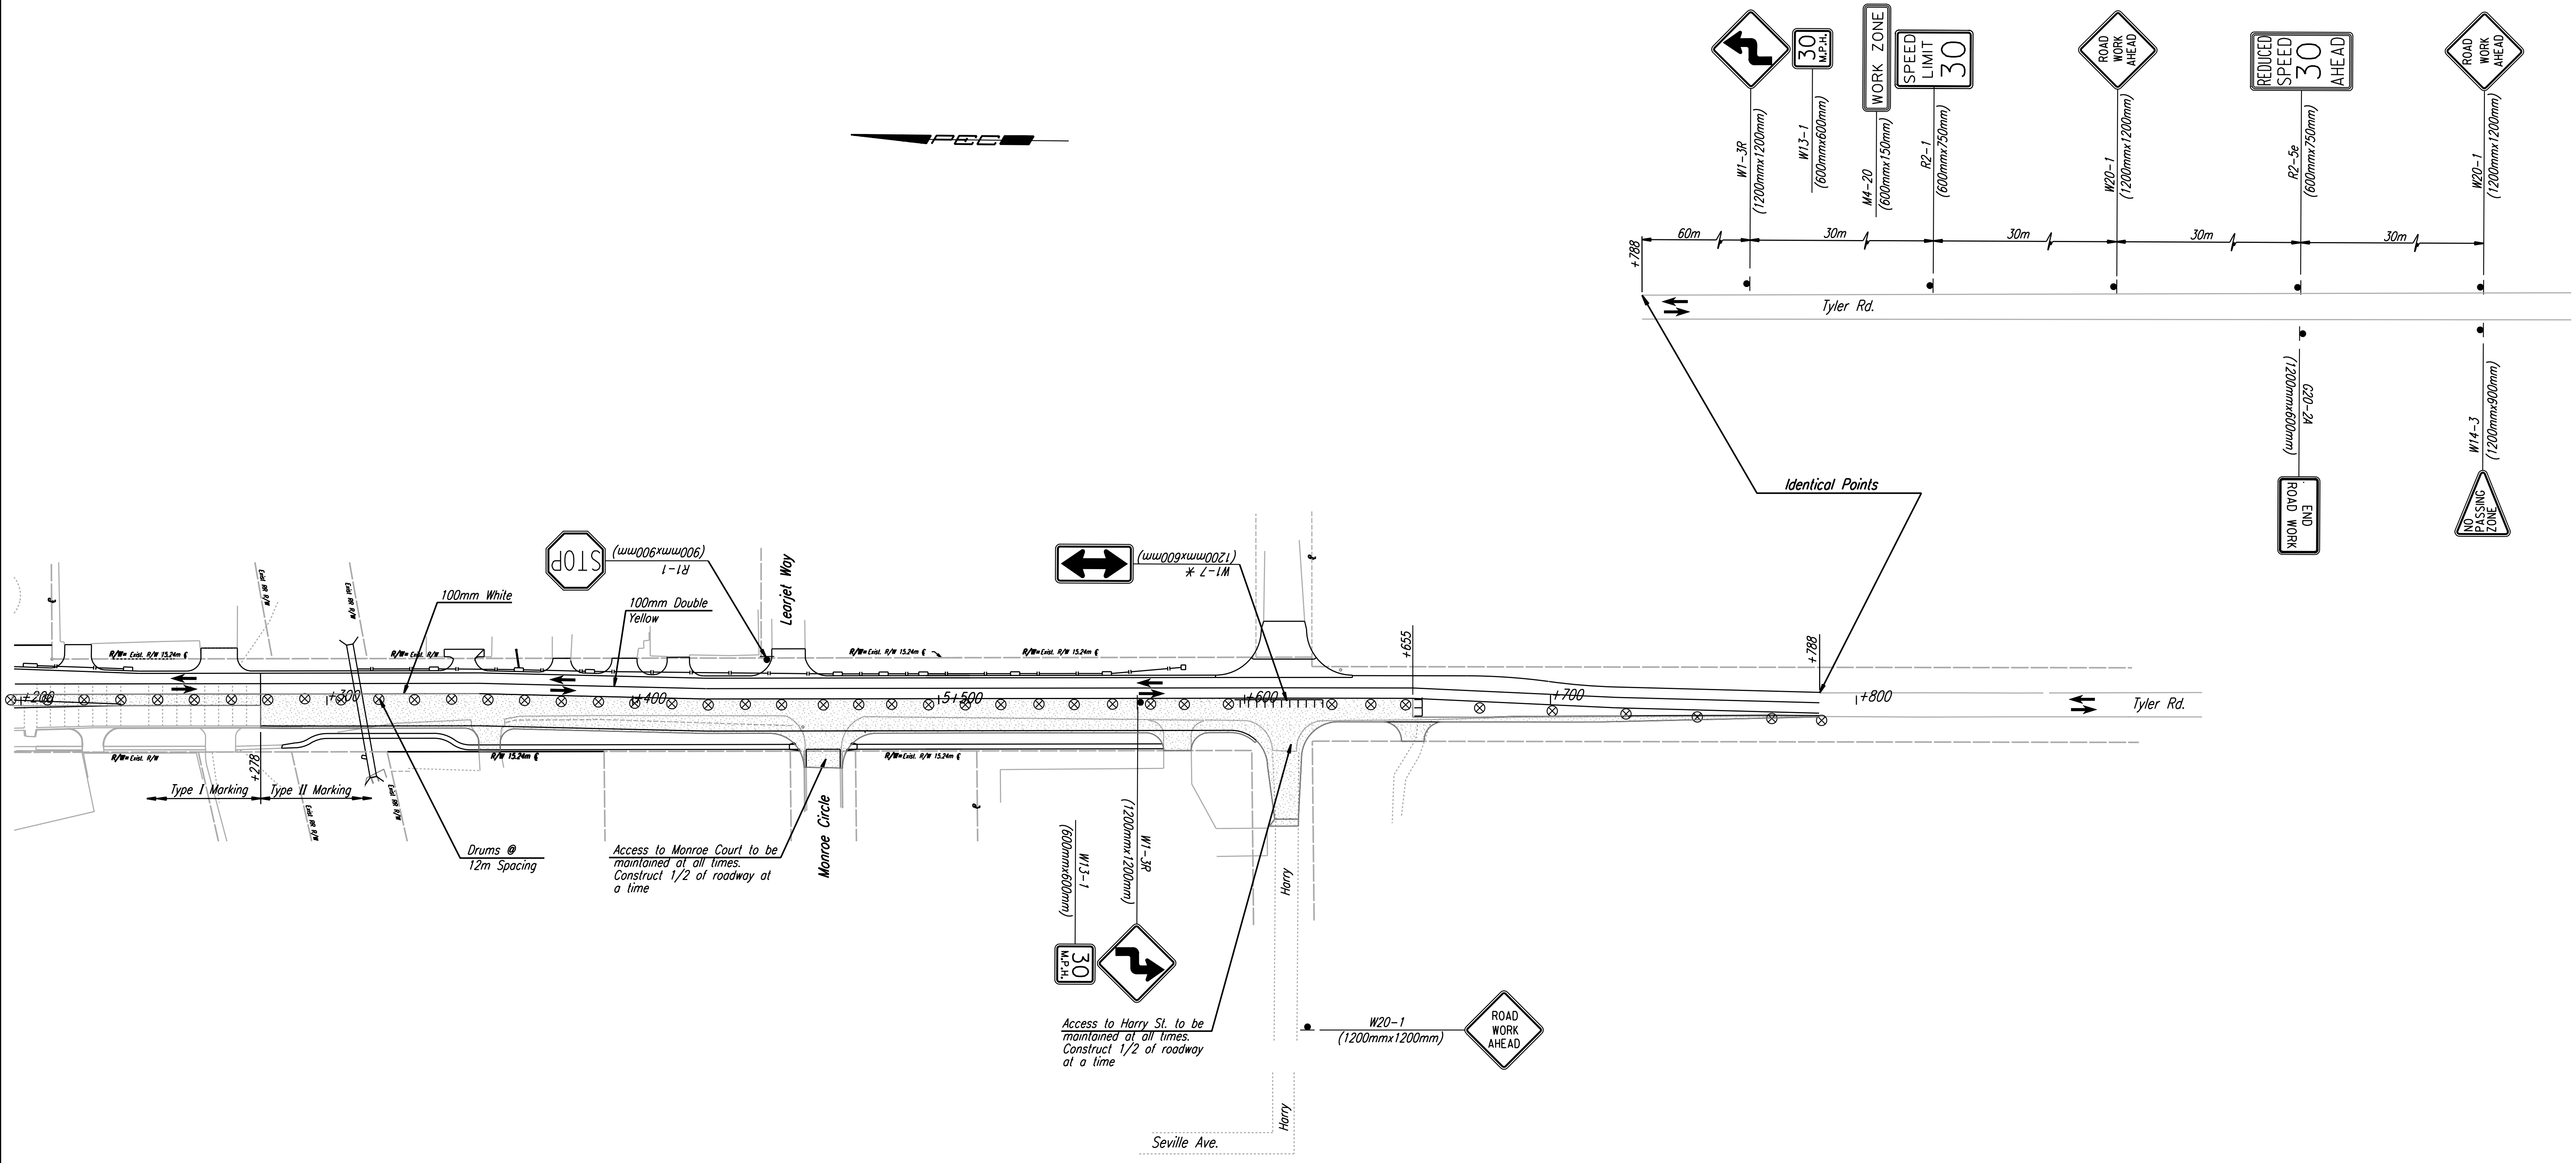

DSNR: OPER: JGP Scale: 1:1000  
 12/1997/97-362-As-Builts/dgn/s/Vol 4/5th 822-TC Stage 1b-1/1/15200.dgn Last Rev: 10-5-07 By: gdr

1			
No.	Revisions	By	Date
CITY OF WICHITA <b>TYLER ROAD</b> <b>TRAFFIC CONTROL - STAGE 1B</b> <b>STA. 5+200 TO STA. 5+800</b> SEDGWICK COUNTY			
<b>Professional Engineering Consultants, P.A.</b> <small>303 S. TOPEKA • WICHITA, KANSAS 67202          316-262-2691 • FAX 316-262-3003</small>			
Designed by	RPC, RWM	Checked by	WDH
Drawn by	JGP	Date	April, 2002 Job No. 97362